



1100 Robeson Street
 PO Box 35376
 Fayetteville, North Carolina 28303
 910-488-1319 Fax: 910-488-5673

www.barnhillcontracting.com

May 7, 2014

Geof Little
 NC DENR, Division of Waste Management
 Solid Waste Section Permitting
 1646 Mail Service Center
 Raleigh, NC 27699-1646

Permit No.	Date	Document ID No.
26-K	March 06, 2015	23929

Re: Doc Bennett Road LCID
 Permit No. 26-K

Received via a mail
 Date: May 07, 2014
 Solid Waste Section
 Raleigh Central Office

Dear Mr. Little:

Attached is information pertaining to a Permit Amendment for the above referenced landfill facility. This amendment is for the next five years of disposal operations within a previously permitted landfill. As required by the Application Guidance provided to us, we have included the following:

- Information for Section 1: General Information
- Information for Section 7: Application for 5-Year Permit
 - General Information in Section 1
 - Updated plans including cross-sections
 - Updates to operation plan
 - Letter from Cumberland County Planning Department

With this letter we are including two (2) paper copies of the narrative and plans as well as a CD containing a PDF of the above information. Please let us know if you have questions or need additional information.

Sincerely,
 Barnhill Contracting Company

Steve Waters

Barnhill Contracting Company
1100 Robeson Street
Fayetteville, NC 28305

Application for Permit Renewal
Doc Bennett Road Land Clearing & Inert Debris Landfill
Permit No. 36-K

Section 1: General Information

1. Name & Permit Number
Doc Bennett Road Land Clearing & Inert Debris Landfill
Permit No. 26-K
2. Contact Information
Landowner, Business Owner & Operator
Barnhill Contracting Company
1100 Robeson Street
Fayetteville, NC 28305
910.488.1319

Person In Responsible Charge:
Steve Waters
Barnhill Contracting Company
1100 Robeson Street
Fayetteville, NC 28305
910.488.1319
3. Applicant's Consulting Engineer
Call Sign Engineers, PA
104 Gillespie Street
Fayetteville, NC 28301
910.486.0700
4. Person to receive permit fee invoices
Steve Waters
Barnhill Contracting Company
1100 Robeson Street
Fayetteville, NC 28305
910.488.1319

Section 7: Application for 5-Year Permit

1. Section 1 information is indicated above.
2. See drawings included with this submittal
3. There are no revisions to the Operation Plan.
4. Included as a part of this submittal is a letter dated February 28, 2014 from the Planning & Inspections Department of Cumberland County stating that the LCID complies with the local land use and zoning codes and that a recent inspection shows the site to be in compliance.

Thomas J. Lloyd,
Director

Cecil P. Combs,
Deputy Director

Ken Sykes,
Code Enforcement Manager

Carol M. Post
Office Processing Assistant



CUMBERLAND
★ **COUNTY** ★
NORTH CAROLINA

Planning & Inspections Department

Debra Johnson,
Inspector

Chris Fulton
Inspector

George Hatcher,
Inspector

Joey Lewis,
Inspector

Joan Fenley,
Inspector

February 28, 2014

Gordon Rose, PE LEED AP
Call Sign Engineers
104 Gillespie Street
Fayetteville, NC 28301

Re: Barnhill Contracting LCID Site
Doc Bennett Road
PIN: 434-91-3834

Sir:


This is to confirm that the above subject property is located within the zoning jurisdiction of Cumberland County, North Carolina and is zoned RR CU -- Rural Residential with a Conditional Use Overlay. Zoning Case P92-3 was approved by the Cumberland County Board of County Commissioners May 26, 1992. In doing so, the Commissioners approved the current zoning and the operation of a demolition landfill.

A site inspection was performed by Debra Johnson on February 28, 2014. Her inspection shows the site to be in compliance with the above referenced case.


I hope this meets your needs. Please let me know if you need anything additional.

Sincerely,

Kenneth Sykes
Code Enforcement Manager

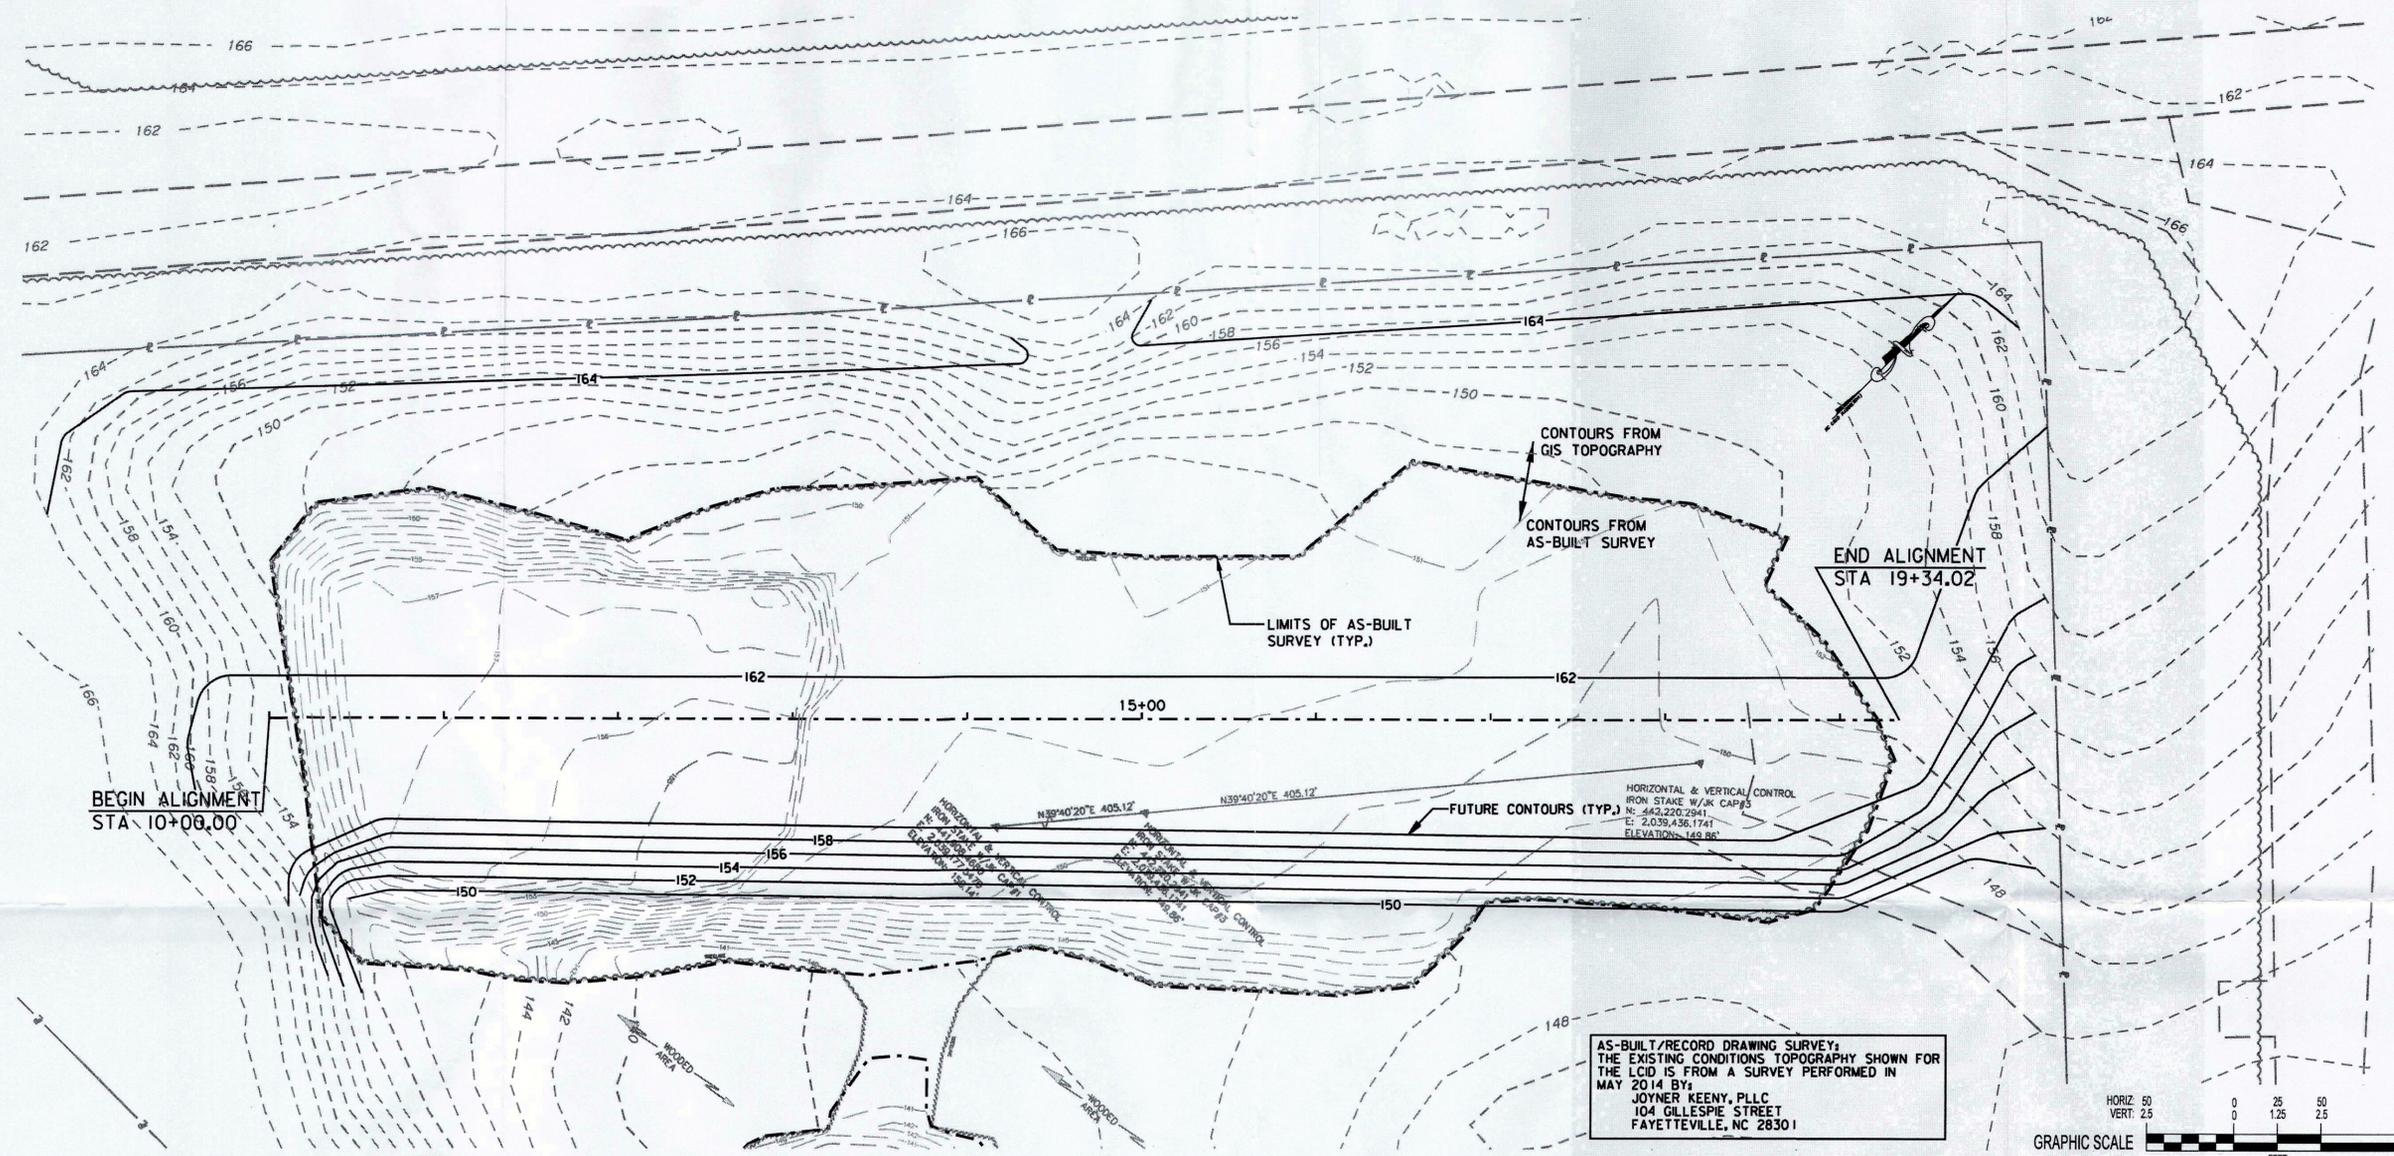


AS-BUILT/RECORD DRAWING SURVEY:
 THE EXISTING CONDITIONS TOPOGRAPHY SHOWN FOR
 THE LCID IS FROM A SURVEY PERFORMED IN
 MAY 2014 BY:
 JOYNER KEENEY, PLLC
 104 GILLESPIE STREET
 FAYETTEVILLE, NC 28301

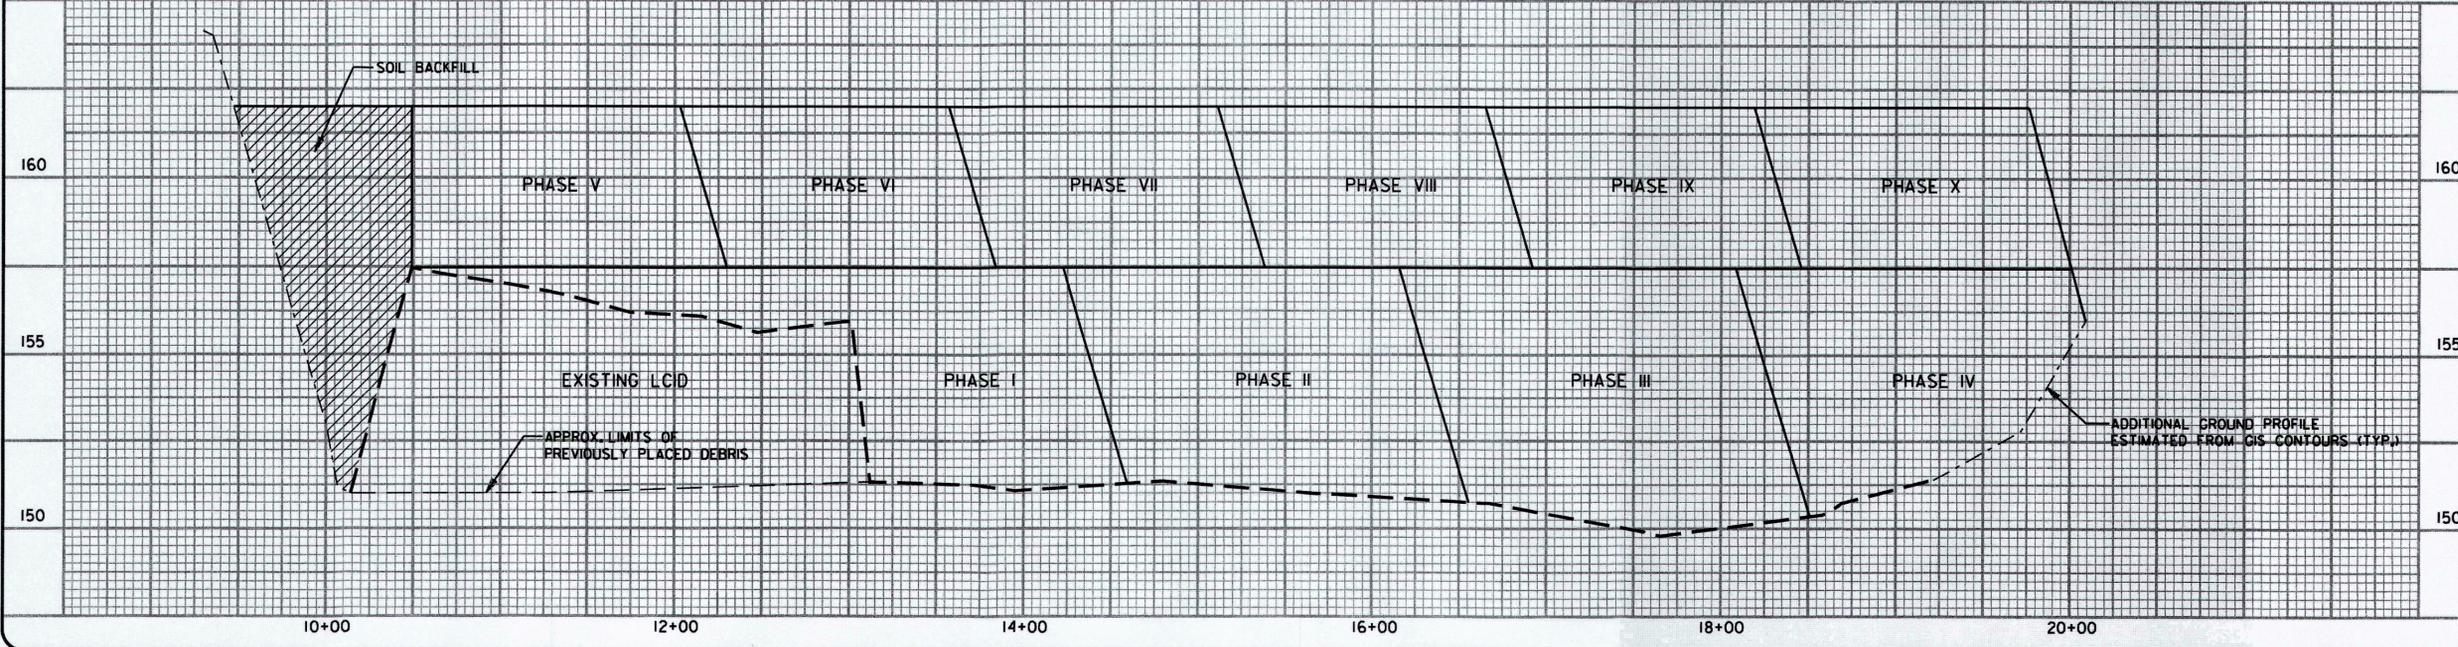

**BARNHILL
 CONTRACTING
 COMPANY**

**CALL SIGN
 ENGINEERS**
 104 Gillespie Street
 Fayetteville, NC 28301
 Ph: 910.486.0700 Fax: 910.486.8900
 www.callsignengineers.com
 NC Firm License No. C-3485

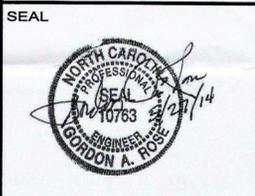

NO.	DATE	DESCRIPTION
1	14	

DATE: MAY 27, 2014
 CSE PROJ. # BAR_0073
 DRAWN: CHW
 DESIGNED: CHW/GAR
 CHECKED: GAR
 PROJ. MGR: CHW

DOC BENNETT ROAD
 LCID PERMIT RENEWAL

PROJECT STATUS
 MAP UPDATE
 MAP UPDATE
 (MAY 2014)

C-01