


A B C D E F


BUILDING CORNER COORDINATES

POINT	NORTHING	EASTING	DESCRIPTION
A	9543.97	11300.59	CINDER BLOCK BLDG
B	9573.20	11313.75	CINDER BLOCK BLDG
C	9685.98	10771.97	FRAME BLDG
D	9680.85	10732.49	FRAME BLDG
E	9708.83	10737.72	FRAME BLDG
F	9888.94	10675.32	FRAME BLDG
G	9834.37	10505.29	METAL BLDG
H	9828.19	10455.05	METAL BLDG
I	9888.42	10468.07	METAL BLDG
J	9878.32	10368.45	METAL BLDG

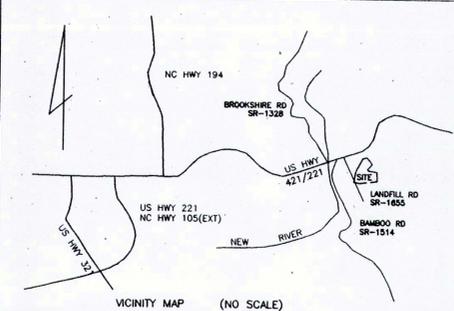


- NOTES:**
- 1) DATUM = U.S.G.S. (COORDINATES & ELEVATIONS BASED ON PROJECT PLANS BY DRAPER ADEN ASSOCIATES OF BLACKSBURG, VIRGINIA.)
 - 2) CONTOUR INTERVALS = 2' (TWO FEET)
 - 3) UNDERGROUND BENCH PIPING LOCATIONS TAKEN FROM DESIGN PLANS BY DRAPER ADEN ASSOCIATES.

LEGEND

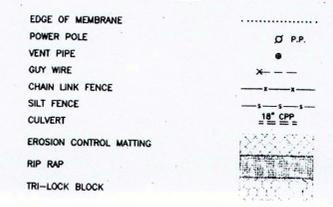

THE MAP SHOWN HEREON IS NOT WITHIN A 100 YEAR FLOOD HAZARD ZONE ACCORDING TO FIRM MAP PANEL No.: 370251 0115B DATED: 6/18/80

THIS MAP WAS PREPARED WITHOUT THE BENEFIT OF A TITLE REPORT, WHICH MAY REVEAL ADDITIONAL CONVEYANCES, EASEMENTS, RIGHTS-OF-WAY, OR BUILDING RESTRICTION LINES, NOT SHOWN. ALL PROPERTY OWNERSHIPS WERE TAKEN FROM CURRENT TAX RECORDS ONLY.

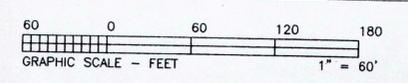

I, Tyrone Richard Bishop, RLS, certify that this map was drawn under my supervision from an actual survey made under my supervision; that the ratio of precision as calculated by latitudes and departures is 1:30,841. (That the boundaries not surveyed are shown as broken lines plotted from information found in Book N/A, Page N/A.) This map was not prepared for recordation. Unless otherwise noted there is no published horizontal control within 2,000.00'.


Witness my hand and seal this 15th day of January, A.D. 19 97.

Signature _____ (RLS) Reg. No. L-2427

REVISED 1/15/97 REVISED 5/6/97

SURVEY PREPARED BY
WESTERN CAROLINA SURVEYORS, P.A.
176 E. KING ST. BOONE, N.C. 28607 TELE. (704) 264-7473
JOB NO.: B96-069

NOTE:
TOPOGRAPHIC INFORMATION COMPILED FROM SURVEYS PERFORMED BY WESTERN CAROLINA SURVEYORS, P.A., ON 1-3-97 AND 5-6-97

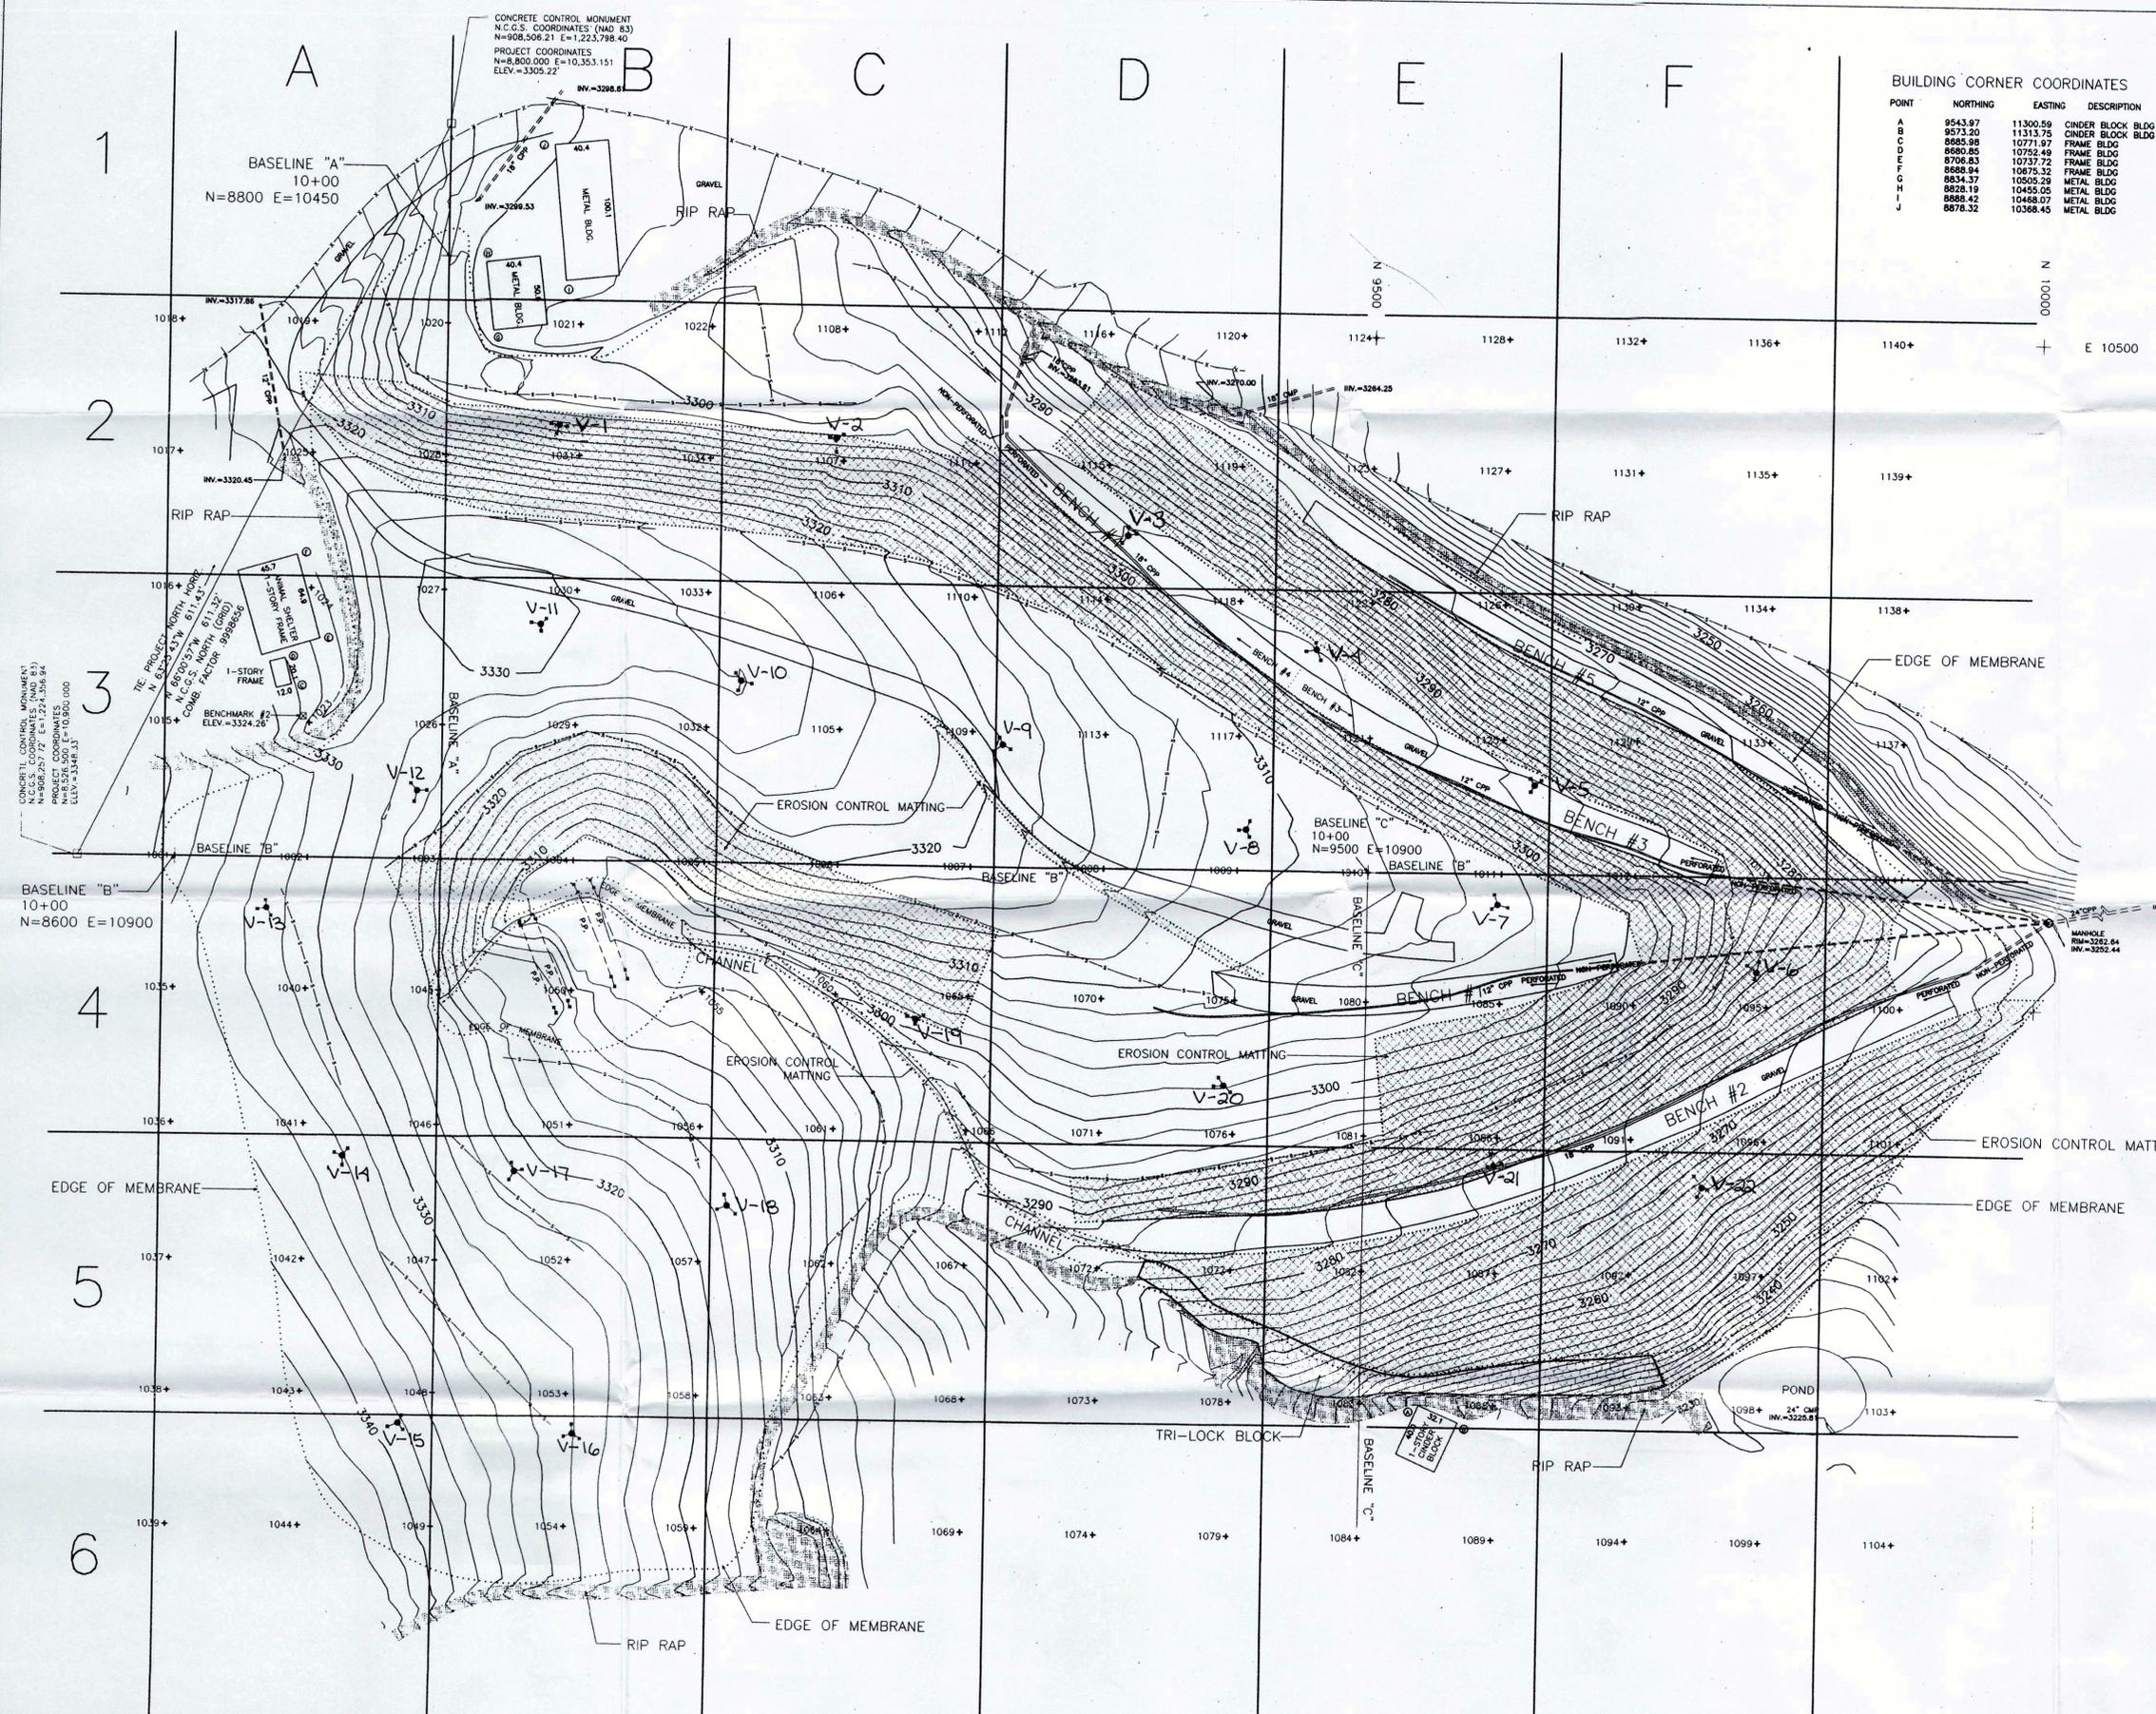

Draper Aden Associates
CONSULTING ENGINEERS
Blacksburg, Virginia - Richmond, Virginia - Nashville, Tennessee

DESIGNED N/A
DRAWN L.H.J.
CHECKED N/A
DATE 5-8-97

AS BUILT SURVEY-CLOSURE CONSTRUCTION
WATAUGA COUNTY LANDFILL
WATAUGA COUNTY NORTH CAROLINA

REVISIONS:

SCALE: 1"=60'

PLAN No 6520-31

SHEET 1 OF 1