

1109

FOR OFFICE USE ONLY

Quad. No. _____ Serial No. 166975

Lat. _____ Long. _____ Pc _____

Minor Basin _____

Basin Code _____

Header Ent. _____ GW-1 Ent. _____

WELL CONSTRUCTION RECORD

DRILLING CONTRACTOR Groundwater Protection, Inc.

DRILLER REGISTRATION NUMBER 1105

STATE WELL CONSTRUCTION PERMIT NUMBER: _____

Exxon 43998

1. WELL LOCATION: (Show sketch of the location below)

Nearest Town: GREENSBORO

(Road, Community, or Subdivision and Lot No.)

2. OWNER EXXON

ADDRESS 4701 W MARKET ST
 (Street or Route No.)
GREENSBORO N.C.
 City or Town State Zip Code

DATE DRILLED 12-6-95 USE OF WELL _____

TOTAL DEPTH 30' CUTTINGS COLLECTED Yes No

DOES WELL REPLACE EXISTING WELL? Yes No

STATIC WATER LEVEL: 20-4" FT. above TOP OF CASING.
 below
 TOP OF CASING IS 0 FT. ABOVE LAND SURFACE.

YIELD (gpm): N/A METHOD OF TEST N/A

WATER ZONES (depth): N/A

CHLORINATION: Type N/A Amount N/A

3. CASING:

From	To	Depth	Diameter	Wall Thickness or Weight/Ft.	Material
0	15	0'	2"	Sch 40	AUC
15					

4. GROUT:

From	To	Depth	Material	Method
0	15	15'	Type I Portland	Thrambe
15				

5. SCREEN:

From	To	Depth	Diameter	Slot Size	Material
15	30	15'	8"	100	PIE
30					

6. GRAVEL PACK:

From	To	Depth	Size	Material
13	30	17'	20/30	Sand
30				

REMARKS: Bentonite pellets from 14' to 13'

County: Guilford

Depth	DRILLING LOG	
From	To	Formation Description
9-11		red sh
14-16		silly clay
14-21		
24-26		
29-31		tan red sh


RECEIVED
 N.C. Dept. of EHNR
 APR - 4 1996
 Winston-Salem
 Regional Office

RECEIVED/EHNR
 DEM. GROUND WATER SEC.
 95 MAR 27 PM 2:10

If additional space is needed use back of form.

LOCATION SKETCH

(Show direction and distance from at least two State Roads, or other map reference points)

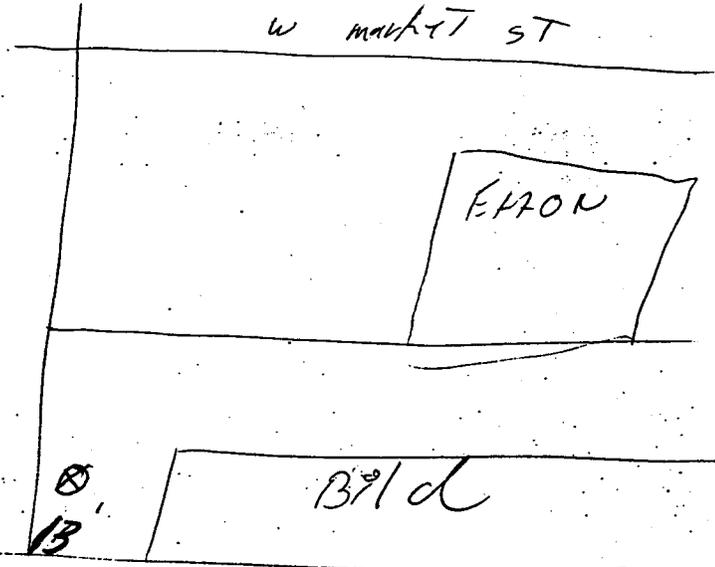

I DO HEREBY CERTIFY THAT THIS WELL WAS CONSTRUCTED IN ACCORDANCE WITH 15 NCAC 2C. WELL CONSTRUCTION STANDARDS, AND THAT A COPY OF THIS RECORD HAS BEEN PROVIDED TO THE WELL OWNER.

SIGNATURE OF CONTRACTOR OR AGENT

DATE