



Clayton, Sr., P.E.

C.T. Clayton, Sr., Professional Engineer

February 25, 2002

James C. Coffey, P. E.
NCDENR
Division of Waste Management
401 Oberlin Road
Suite 150
Raleigh, NC 27605

SCANNED
9/24/15



**RE: Dunn Erwin Landfill, Harnett County
Closed MSW Gas Extraction System – Phase 2
Asbuilt Drawings**

Dear Mr. Coffey:

This is a submittal of the asbuilt drawings of Dunn Erwin Landfill, Closed MSW Gas Extraction System – Phase 2 for your use and review. Included are 2 sets of drawings (2 sheets per set) that make up the asbuilt. The project is now complete. Hopefully this fulfills the required documentation needed by NCDENR.

Please direct any questions that may arise during your review to Tyrus Clayton of Draper Aden Associates (mobile/vmail: 919-454-4938, phone: 919-367-9997, fax: 919-367-9994) or me directly (contact info listed below).

We look forward to your reply.

Very truly yours,

C.T. Clayton
C. T. Clayton, Sr., P. E.

① CODESATE TRAP -?
WHERE ARE LIQUIDS GOING

② DETAIL VERTICAL WELL
w/ ASSOCIATE PIPING.

Permit No.	Date	Document ID No.
41-17	September 15, 2015	24995

DOCUMENT APPROVED FOR PERMIT ISSUANCE
Division of Waste Management
Solid Waste Section
Received Dated: August 13, 2015 and revised through September 10, 2015
Date: September 15, 2015 By: Ming-Tai Chao


Encls.

Cc: Jerry Blanchard, Harnett County
Tyrus Clayton, DAA

Phone: 252 672-0304
Fax: 252 672-8577

PO Box 12794
NEW BERN, NC 28561

Mobile: 252 671-6979
Home: 910 897-0660

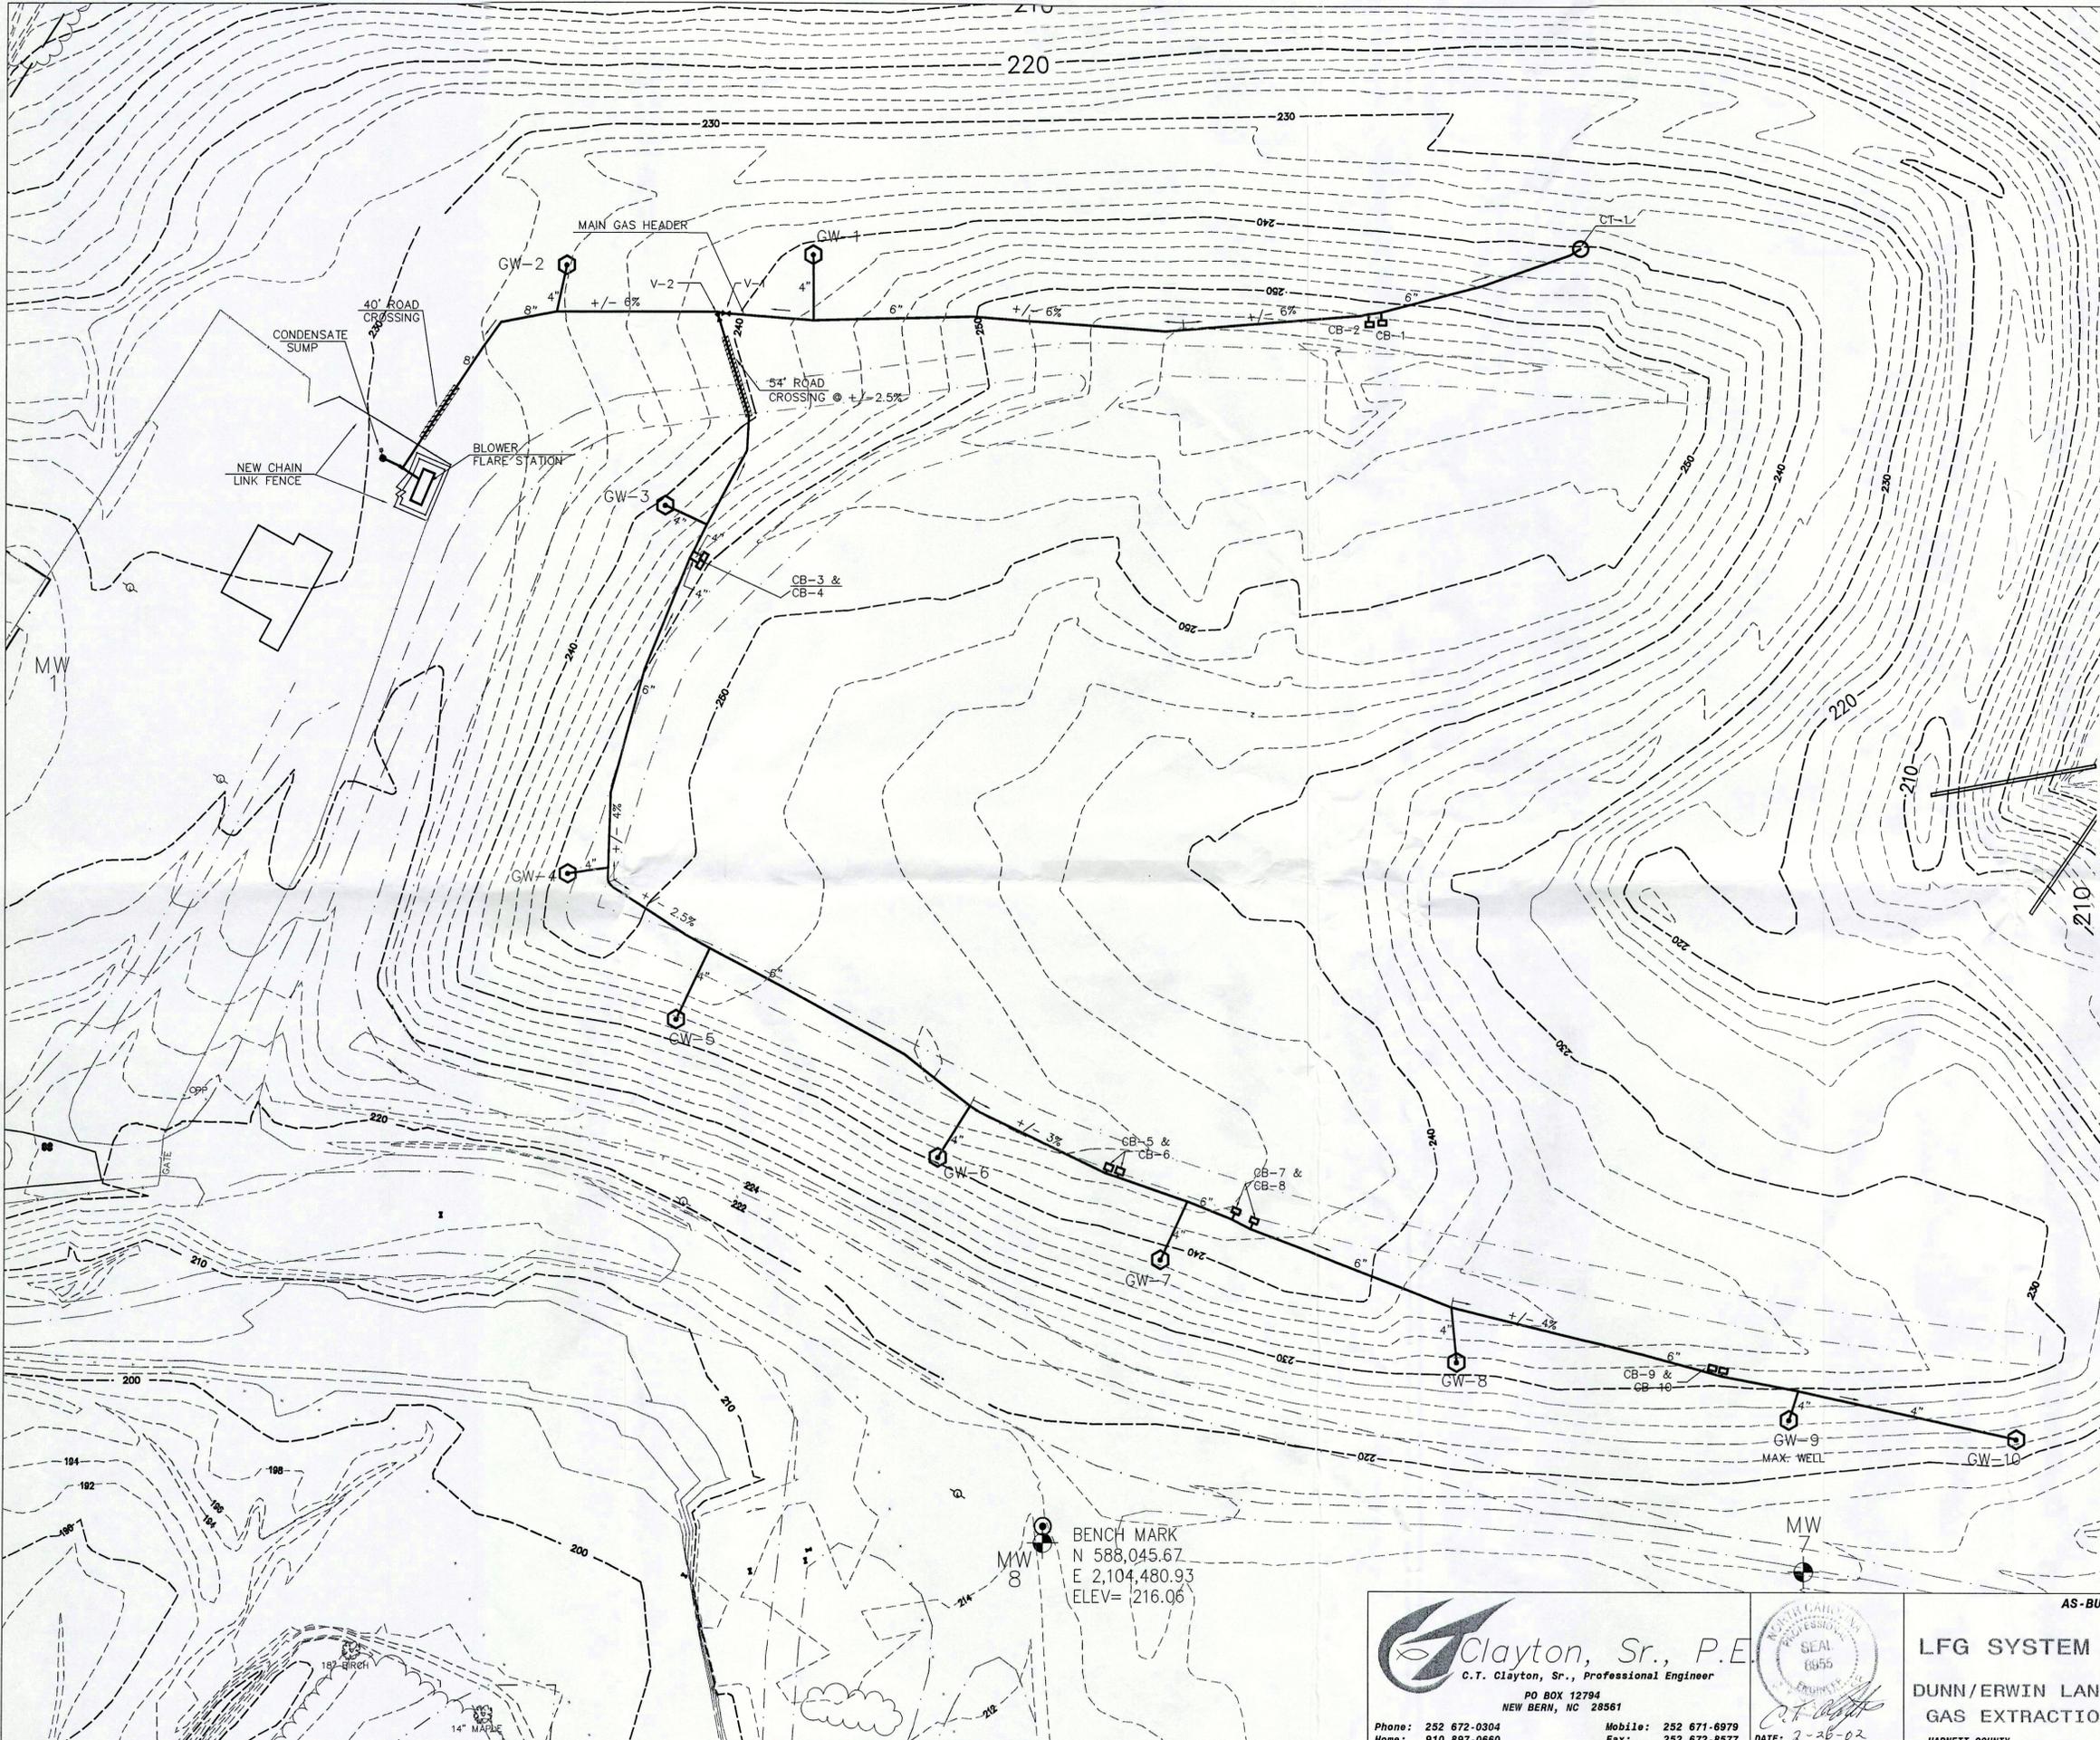

LEGEND

- HDPE GAS HEADER
- GW-1 VERTICAL WELL
- CT-1 CONDENSATE TRAP
- CB-1 HORIZONTAL GAS WELL CONTROL BOX
- ✕ V-1 GAS HEADER VALVE
- X-X- CHAIN LINK FENCE
- LIGHT POLE
- PP POWER POLE
- ⊕ MW1 GAS MONITORING PROBE
- ⊙ BENCH MARK

SOUTHWIND
 SURVEYING AND ENGINEERING, INC.
 281 GLEN ROAD
 GARNER, N.C. 27529
 919-775-0183
 919-775-0148 (FAX)
 SURVEYING/ENGINEERING AND PLANNING

GAS EXTRACTION SYSTEM AS-BUILT PERFORMED BY SOUTHWIND SURVEYING AND ENGINEERING, INC.



BENCH MARK
 N 588,045.67
 E 2,104,480.93
 ELEV= 216.06

Clayton, Sr., P.E.
 C.T. Clayton, Sr., Professional Engineer
 PO BOX 12794
 NEW BERN, NC 28561
 Phone: 252 672-0304 Home: 910 897-0660
 Mobile: 252 671-6979 Fax: 252 672-8577
 DATE: 2-26-02



AS-BUILT SITE PLAN
 of
LFG SYSTEM LAYOUT-PHASE 2
 at
DUNN/ERWIN LANDFILL-CLOSED M.S.W.
GAS EXTRACTION SYSTEM - PHASE 2
 HARNETT COUNTY NORTH CAROLINA

PROJECT # : 0003003
 PROJ. ENG. : CTC
 DRAWN BY : SOUTHWIND
 FIELD BK. :
 CAD FILE : h00218-01a.dwg
 SCALE : 1" = 50'
 DATE : FEBRUARY 12, 2002
 SHEET # : 1 OF 2
 Email: ctc@coxnc.rr.com