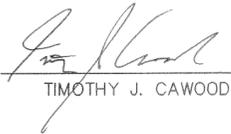




SURVEYOR'S CERTIFICATION

TO:


THIS IS TO CERTIFY THAT THIS "AS BUILT" SURVEY WAS PREPARED FROM A FIELD SURVEY PERFORMED UNDER MY DIRECTION ON FEBRUARY 17, 2006.

SIGNED:  02-03-06
TIMOTHY J. CAWOOD, P.L.S.

BENCHMARK HUB
ELEVATION = 1.47'
NAVD '88
(SEE NOTE 2.)

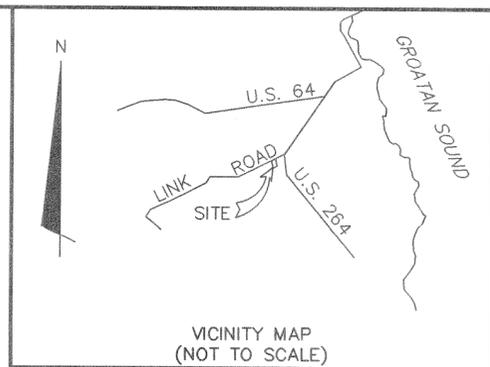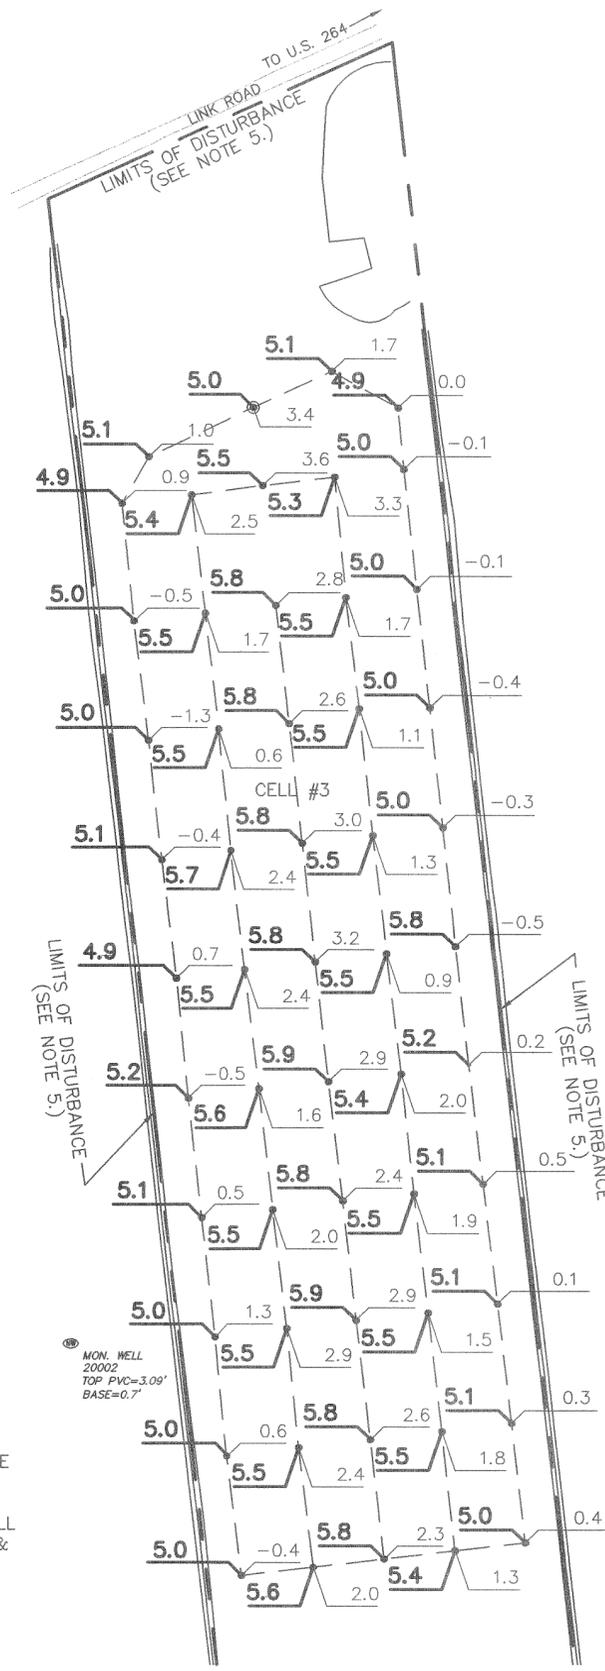


LEGEND

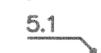-  1.0 EXISTING GRADE
-  5.1 ASBUILT GRADE

NOTES:

1. "AS BUILT" SURVEY DATE 2/17/06 BY MCKIM & CREED.
2. VERTICAL DATUM BASED ON GPS RAPID STATIC SESSION, OPUS REPORT #000237065. DATUM NAVD '88, FEET, BY QUIBLE & ASSOCIATES, PC.
3. PROPERTY LIES WITHIN A PORTION OF PIN 9747-00-32-5320 1531 LINK ROAD, MANNS HARBOR, NORTH CAROLINA.
4. CONDITIONS WITHIN SURVEY AREA MAY HAVE CHANGED SINCE DATE OF SURVEY.
5. BASE MAP DERIVED FROM CONSTRUCTION AND DEMOLITION LANDFILL CELL NO. 3 CONSTRUCTION PLAN, PREPARED BY CAMP DRESSER & MCKEE, DATED JULY 2005.
6. THIS SURVEY DOES NOT REPRESENT A BOUNDARY SURVEY. AND WAS PREPARED WITHOUT BENEFIT OF A TITLE SEARCH.

MON. WELL
20002
TOP PVC=3.09'
BASE=0.7'

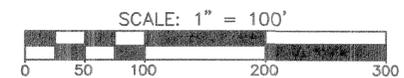

DATE	REVISION	INITIAL



448 Viking Drive, Suite 100
Virginia Beach, Virginia 23452
Phone: (757)431-1002, Fax: (757)431-1032

Internet Site: <http://www.mckimcreed.com>



ASBUILT SURVEY
OF
A PORTION OF CELL #3
OF
COUNTY OF DARE LANDFILL

DATE: FEBRUARY 28, 2006 SCALE: 1" = 100'
COUNTY OF DARE NORTH CAROLINA

PROJECT # : 03160-0010
PROJ. SVYR : TJC
DRAWN BY : mjb
FIELD BK. :
COMP. FILE : COMP EXHIBIT
SHEET # : 1 OF 1

DWG. # :