



**Legend**  
 Proposed Contour 750  
 Existing Contour 750  
 Proposed/Existing Grade Identifier

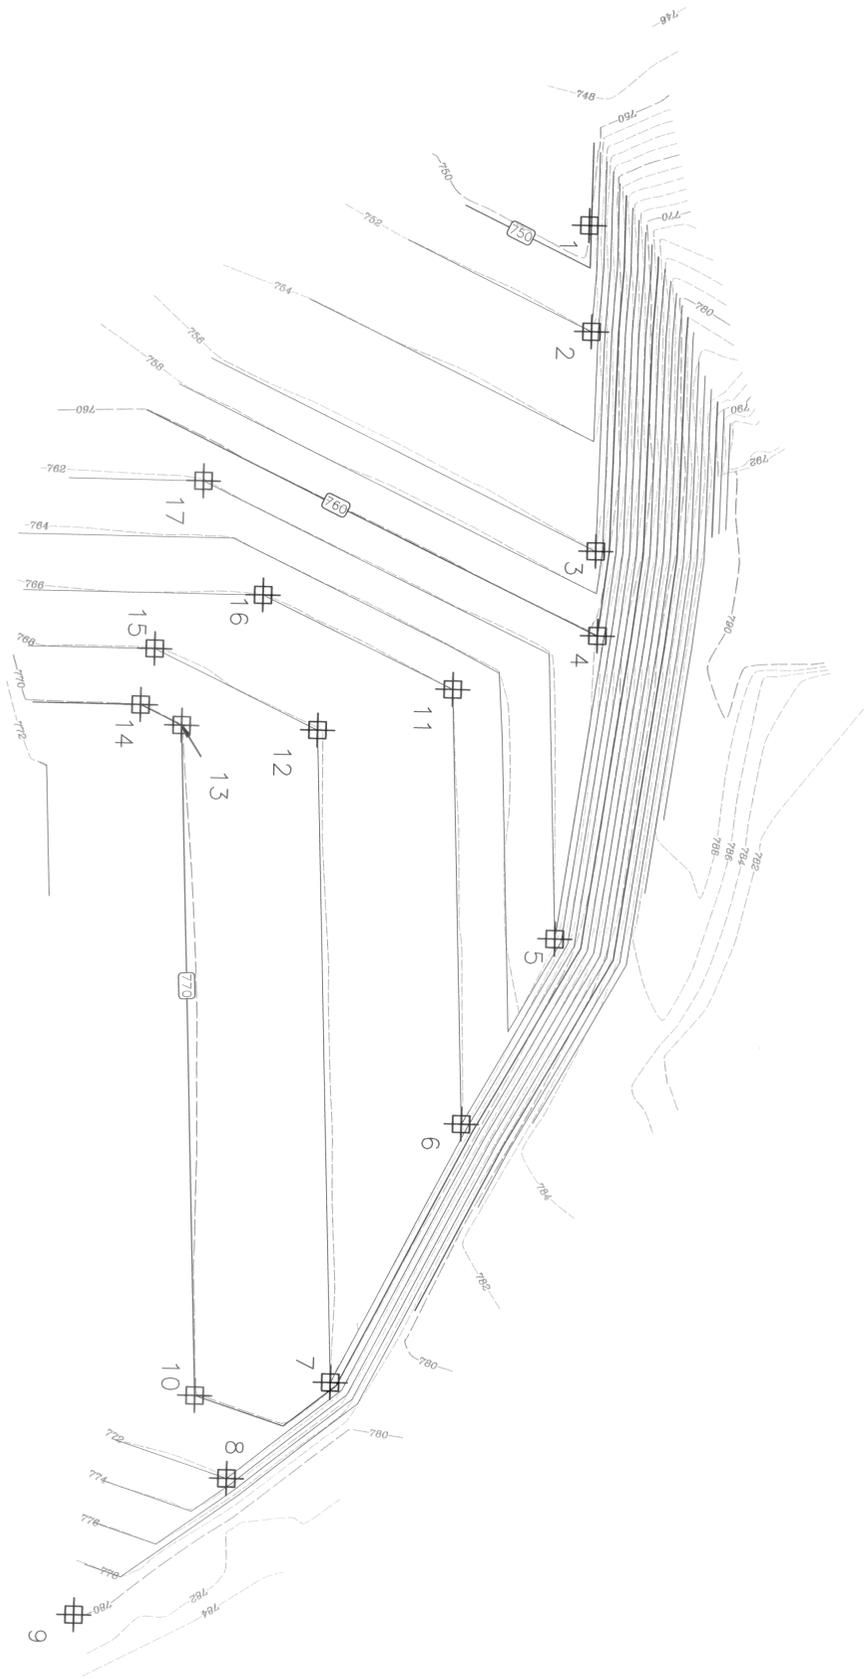

No.	Date	Description	By:
1	5-22-07	add grid spot elev.'s	JWE
2	6-06-07	changed elev. @ point (east side)	JWE
3	7-5-07	updated control points	WMB
4	7-16-07	updated ex. contours	JWE
5	7-26-07	updated ex. contours	JWE


**Notes:**  
 1) Field survey was completed by 6-29-07. This drawing shows topographic conditions of the site at the time of the survey.  
 2) THIS IS NOT A BOUNDARY SURVEY.  
 3) This property is subject to any easements, agreements, or rights-of-way of record prior to the date of this map which were not apparent at the time of my inspection and might otherwise be disclosed by an abstract of title or other records. The survey was conducted and data supplied to Brady Surveying Company, P.A. There may be easements or other matters of record affecting this property not shown hereon.  
 4) Vertical datum: NCGS "Ganna" - NGVD29 Elev. 802.21  
 5) All distances shown are measured horizontal ground distances unless specifically noted otherwise.

Professional Land Surveyor  
 L-4558

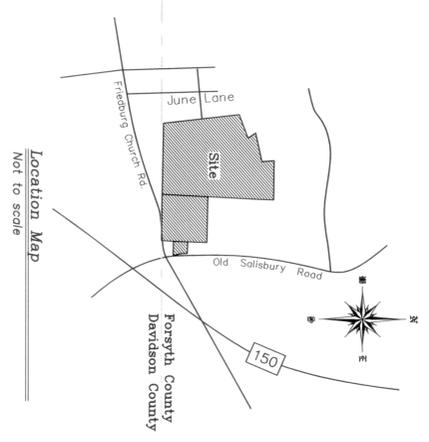

PNT.	NORTHING	EASTING	Proposed As-Built
1	822090.29	1622683.61	749.8
2	822027.74	1622586.35	752.0
3	821898.54	1622592.01	756.0
4	821848.50	1622594.21	760.0
5	821668.87	1622573.47	762.0
6	821528.15	1622444.44	768.0
7	821346.31	1622447.80	768.0
8	821264.05	1622388.06	772.0
9	821394.72	1622300.10	780.0
10	821814.54	1622368.13	770.0
11	821788.77	1622509.89	766.0
12	821788.91	1622430.95	768.0
13	821789.91	1622350.82	770.0
14	821801.51	1622325.39	770.0
15	821868.17	1622398.94	766.0
16	821868.17	1622398.94	766.0
17	821934.83	1622360.15	762.0

**As-Built Survey**  
**OSR Landfill**  
**Phase 5 Excavation As-Built**  
**City of Winston-Salem**  
 Winston Township  
 Forsyth County, North Carolina  
 July 5, 2007

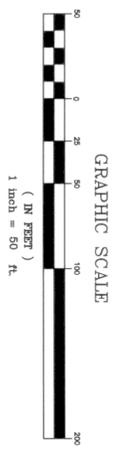

**Brady Surveying Company, P.A.**  
 2990 Bethesda Place, Suite 601-B  
 Winston-Salem, North Carolina 27103  
 (336) 760-2716