



Fac/Perm/Co ID #	Initials Trail	Date	Doc ID #
43-04	Geoffrey H. Little	10/24/2011	15526

October 24, 2011

Mr. Geof Little  
NCDENR Division of Waste Management  
1646 Mail Service Center  
Raleigh, NC 27699-1646

**Re: Central Carolina Tire Monofill  
Phase 3B Expansion  
Partial Certification of Construction**

Dear Mr. Little:

Per discussions held between Garrett & Moore, Inc. and NCDENR, Division of Waste Management, construction of a portion of the Central Carolina Tire Phase 3B expansion has been completed. The partial completion is intended to provide Central Carolina Tire immediate, additional capacity to manage scrap tires that are not able to be recycled. The purpose of this correspondence is to obtain a Permit to Operate for the constructed portion of the Phase 3B expansion indicated herein.

A figure illustrating the location of the completed work relative to the existing Phase 3A disposal area and Phase 3B expansion is attached for your information. Additionally, a certified as-built survey is provided for the completed area.

Based on our review of the enclosed survey and on our observations at the site, it is our opinion that the portion of the base grade construction indicated on the as-built survey was performed in accordance with the Permit to Construct dated August 29, 2011.

Please do not hesitate to contact me should you have any questions.

Sincerely,  
**Garrett & Moore, Inc.**  
NC Firm C-2910

Craig M. Fortner  
Project Manager

Attachments

1. Location of Certified Base Grades
2. As-Built Survey – Phase 3B Final Grades as of October 18, 2011

C:\Documents and Settings\fortner\Desktop\in progress\CCT\PHASE 3B CONSTRUCTION PLAN ADD NO 1 10-04-11.pro Mon Oct 24, 2011 11:07:26AM

GRAPHIC SCALE 1"=200'



BENCHMARK  
N=5490.38,52'  
E=19242.1,40'  
ELE=348.38'

PHASE 3C

ACTIVE PHASE 3A  
TIRE MONOFILL LANDFILL  
(NCDENR PERMIT 43-08)

AREAS  
CONSTRUCTED  
TO PERMITTED  
GRADES AS OF  
10/18/2011

PHASE 3B

PHASE 3D

**GARRETT & MOORE**   
Engineering for the Power and Waste Industries


**CCT PHASE 3B PARTIAL  
BASE GRADE CERTIFICATION  
SEE 10/18/2011 AS-BUILT**

NC DENR/DWM/SWS  
DIN 15526 Page 2 of 3


JOB

FIG

1

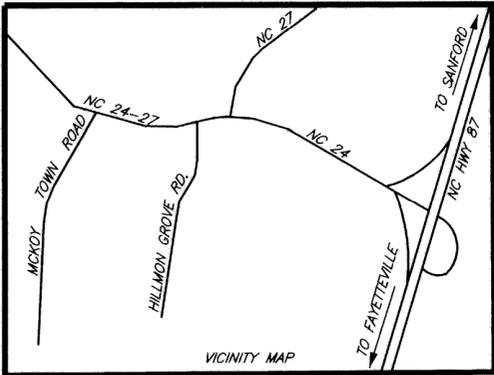

AREAS CONSTRUCTED TO PERMITTED GRADES AS OF 10/18/2011

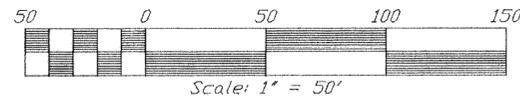

REVISION NO. 	DATE OCTOBER 18, 2011	REVISIONS   	NOTE: 1- HORIZONTAL AND VERTICAL CONTROL ESTABLISHED AND PROVIDED SANFORD CONTRACTORS, INC.	<b>PHASE 3B FINAL GRADES          AS OF OCTOBER 18, 2011</b>	TOPOGRAPHIC SURVEY FOR: <b>CENTRAL CAROLINA HOLDINGS, LLC</b> ADDRESS: 1616 MCKOY TOWN ROAD, CAMERON, NORTH CAROLINA 28326 PROPERTY: JOHNSONVILLE TWP., HARNETT COUNTY, NORTH CAROLINA HARNETT COUNTY PIN = 9554-48-4293	<b>COLE LAND SURVEYS, P.A.</b> 483 WILMER ROAD SANFORD, NORTH CAROLINA 27332 PHONE (919) 258-9340
------------------	--------------------------	-----------------------	---	--	--	--