

**BUNNELL-LAMMONS ENGINEERING, INC.**

GEOTECHNICAL, ENVIRONMENTAL AND CONSTRUCTION MATERIALS CONSULTANTS

# **REPORT OF LIMITED GROUNDWATER CONTAMINATION ASSESSMENT**

**Macon County Lined Landfill - Permit No. 57-03  
Franklin, North Carolina**

*Prepared for*

**NCDENR  
Division of Waste Management  
Environmental Compliance – Solid Waste Section  
1646 Mail Service Center  
Raleigh, North Carolina 27699-1646**

*Prepared by*

**BUNNELL-LAMMONS ENGINEERING, INC.  
6004 Ponders Court  
Greenville, South Carolina 29615**

**December 19, 2007**

**BLE Project Number J07-1101-03**

December 19, 2007

NCDENR  
Division of Waste Management  
Environmental Compliance – Solid Waste Section  
1646 Mail Service Center  
Raleigh, NC 27699-1646

Attention: Mr. Ervin Lane  
Hydrogeologist

Subject: **Report of Limited Groundwater Contamination Assessment**  
**Macon County Lined Landfill, Permit #57-03**  
**Franklin, North Carolina**  
**BLE Project Number J07-1101-03**

Dear Mr. Lane:

Bunnell-Lammons Engineering, Inc. (BLE) is pleased to submit this report to the North Carolina Department of Environment and Natural Resources (NCDENR) on behalf of our client (Macon County, North Carolina). The data presented herein is part of a limited groundwater assessment at the subject site.

#### PROJECT INFORMATION

Macon County owns and operates a recycling center and solid waste disposal facility at 1448 Lakeside Drive in Franklin, North Carolina (Figure 1). The facility includes a network of groundwater monitoring wells which are sampled semi-annually in accordance with the facility permit (Figures 2 and 3). Groundwater sampling and reporting is currently performed by REI Consultants, Inc (REIC) under contract with the county.

Based on the continued detection of volatile organic compounds in two monitoring wells (MW-1A and MW-1B) which exceed North Carolina groundwater standards promulgated under NCAC Title 15A 02L .0202 (2L Standards), the NCDENR required the facility to initiate an assessment monitoring program. The county was notified of the requirement in a NCDENR letter dated August 24, 2007.

The letter required the county to submit a groundwater assessment plan to the NCDENR within 30 days of the receipt of the letter. BLE was retained by Macon County to prepare the work plan which was submitted to the NCDENR on September 13, 2007 (*Groundwater Contamination Assessment Plan*, BLE Project No. J07-1101-02). The work plan was approved by NCDENR on September 14, 2007 in a letter to Chris Stahl of Macon County. BLE was retained by Macon County to perform the required assessment defined in the approved work plan.

This report documents the performance of the limited groundwater assessment and includes well logs, development logs, a potentiometric surface map, laboratory analytical results, and conclusions and recommendations.

#### **SCOPE OF SERVICES PERFORMED**

The required tasks for this assessment were limited to the installation and sampling of three groundwater monitoring wells. These wells were used to establish the on-site groundwater flow direction in the area of concern and to determine if the subject contaminants have impacted groundwater quality.

#### **Monitoring Well Installation, Development, and Survey**

BLE mobilized an ATV-mounted CME-750 drill rig and a truck-mounted Schramm drill rig to install 3 (three) monitoring wells at the locations shown on Figure 2. Groundwater monitoring well MW-23 was installed using the CME rig via hollow stem auger on September 12, 2007. Groundwater monitoring wells MW-1D and MW-5D were installed using the Schramm rig via downhole air hammer on September 20, 2007. The actual well installation locations and depths were dependent on site conditions and were drilled and installed in general accordance with the approved assessment plan. The well drilling and installation procedures are included in Appendices A and B. Each well included a surface completion consisting of a 3 by 3 foot by 4-inch thick concrete pad with a lockable well cap and steel stickup cover. Well logs are included in Appendix B.

BLE provided well development services for each newly installed monitoring well. The monitoring wells were developed to remove fine particles from the sand pack around the well screen. The well development consisted of the following:

1. Place a manual hand pump or bailer in the monitoring well;
2. Purge the well; and
3. Intermittently surge the well with a surge block.

Groundwater turbidity was measured periodically during well development using a HF Scientific model DRT-15 Portable Turbidity Meter, or equivalent. Well development logs are included in Appendix C.

The three new monitoring wells' location and elevation were surveyed by North Carolina registered land surveyor provided by McGill Associates (McGill) under direct contract with the county. The survey data is included in Appendix D.

#### **Groundwater Sampling and Analysis**

Groundwater levels were obtained (by REIC) from the new and previously existing monitoring wells and a potentiometric surface map was prepared by BLE (Figure 2). A well construction and water level summary table has been prepared by REIC (Table 1).

REIC collected groundwater samples from each of the newly installed wells on October 16, 2007. We understand that the groundwater sampling was performed in general accordance with the facility permit. The samples from each of the new wells were analyzed for the NC Appendix I compound list.

As part of the approved groundwater assessment REIC collected samples from a three (3) well subset for NC Appendix II monitoring. Those wells are included MW-17 (background), MW-1A, and MW-1B. Future Appendix II monitoring requirements are to be determined based on the results of this initial event.

The laboratory analysis data is included in Appendix E. A summary table of the laboratory analysis results has been prepared by REIC (Table 2). The data is also summarized on Figure 3.

#### **RESULTS, CONCLUSIONS, AND RECOMMENDATIONS**

Laboratory analysis results indicate that low levels of Appendix I VOCs were detected above the Solid Waste Section Limits (SWSL) in monitoring wells MW-1A, MW-1B, MW-1D, and MW-5D. Appendix I VOCs were not detected above the SWSL in the remaining wells including the downgradient well MW-23 (Figures 2 and 3). Please note that several of the VOCs were detected below SWSLs and that those results are “J-flagged” indicating detections below calibration range (Appendix E). The results are indicated as “J” values, since they are below instrument calibration range and therefore not quantifiable.

Laboratory analysis results also indicate that concentrations of bis(2-ethylhexyl)phthalate (an Appendix II compound) was detected above the SWSL in each of the three wells sampled for Appendix II parameters. These wells included MW-17 (background), MW-1A, and MW-1B. No other Appendix II compounds were detected above SWSLs. Please note that parameters detected below SWSLs are indicated as “J” values in the laboratory report.

We conclude that a release of VOCs into the groundwater has occurred at the site which has impacted a localized area west-northwest of the Phase 1/Phase 2 cell overlap (Figure 3). The horizontal and vertical extent of the release appears to be defined with the data collected from the new assessment wells MW-5D, MW-1D, and MW-23. Areas southeast (MW-2 & MW-3A), northeast (MW-22 & MW-22), and southeast (MW-17 background) have not been affected. Since areas downgradient of the release (MW-23) have not been affected we conclude that it is unlikely that the Little Tennessee River (potential receptor) has been impacted.

We conclude that the “J” values (in the laboratory data) are below calibration range and therefore subject to false positives. We also conclude that the detected phthalate compound is a possible field sampling artifact since it was detected in background well (MW17) at the same magnitude as downgradient wells (MW-1A and MW-1B) and therefore should not be considered sufficient evidence of a release from the landfill.

We recommend that the water quality monitoring plan for the landfill be amended to include substitution of the MW-5D for MW-5 which is often dry. We also recommend that MW-1D and

MW-23 be added to the semi-annual monitoring plan for assessment purposes only. If similar results to those presented herein are obtained after three additional consecutive monitoring events, sampling of MW-1D and MW-23 should be discontinued.

We recommend that Appendix II sampling be discontinued since no evidence of a release of Appendix II compounds from the landfill has been confirmed.

We also recommend that no further assessment be performed at this time since the affected groundwater is limited in extent, appears to be confined to the landfill property, and no receptors appear to be affected. Furthermore we do not recommend implementation of corrective action for this release beyond the changes to the groundwater quality monitoring plan recommended above.

**CLOSING**

BLE appreciates the opportunity to work with NCDENR on this project. Please provide comments on this report at your earliest convenience. Please contact BLE at (864) 288-1265 if you have any questions.

Sincerely,

**BUNNELL-LAMMONS ENGINEERING, INC.**

  
Andrew W. Alexander, P.G.  
Senior Hydrogeologist  
Registered, NC #1475



  
Trevor J. Benton, P.G.  
Staff Hydrogeologist  
Registered, NC #2025




CC: Mr. M. Chris Stahl – Macon County  
Mr. Jeff Bishop, PE – McGill  
Mr. Mike Hofe – REIC

Attachments: Figures  
Tables  
Appendices

c:\awa\active projects\mcgill\macon county landfill\1101-03 well installation for gw assessment\report groundwater assessment macon mswlf 1101-03.doc

**FIGURES**

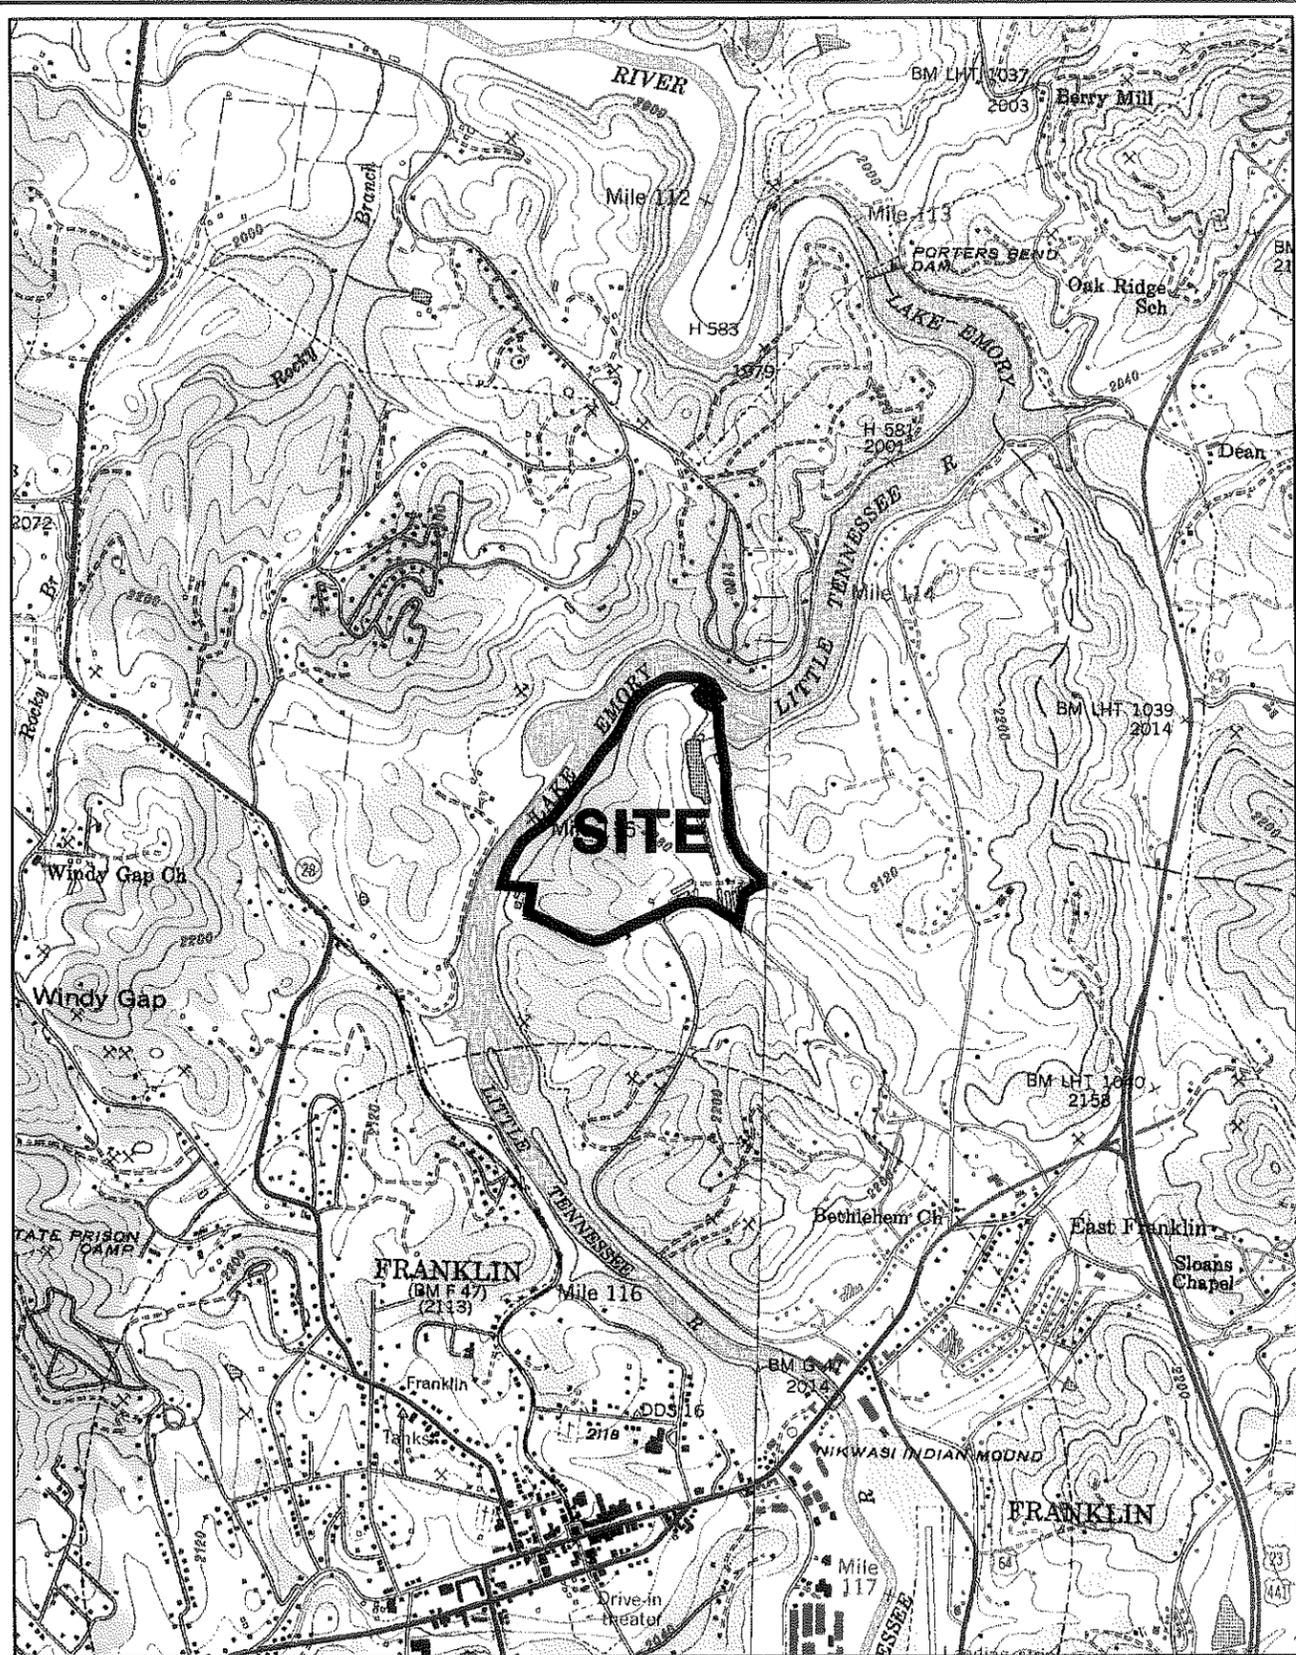

REFERENCE:  
 USGS TOPOGRAPHIC MAP, 7.5 MINUTE SERIES,  
 CORBIN KNOB AND FRANKLIN, N.C. QUADRANGLES,  
 PHOTOREVISED 1978.

DRAWN:	AEH	DATE:	10-11-07
CHECKED:	AWA	CAD:	MACONCOLF-03SLM
APPROVED:		JOB NO:	J07-1101-03

**IBLE** inc.  
**BURNELL-LAMBSON ENGINEERING, INC.**  
 6004 PONDERS COURT  
 GREENVILLE, SOUTH CAROLINA 29615  
 PHONE: (864)288-1265 FAX: (864)288-4430

SITE LOCATION MAP  
 MACON COUNTY LANDFILL  
 FRANKLIN, NORTH CAROLINA

FIGURE  
**1**

**TABLES**

Table 1  
Macon County MSW Landfill  
Permit No. 57-03

Monitoring Wells	Monitoring Point	Northing*	Westing*	Northing**	Easting**	TOC*** (ft amsl)	Depth to Water 10/16-17/07 (below TOC)	Groundwater Elevation (ft amsl)	Well Depth (below TOC)	Screen		Comments
										Top (ft bgs)	Bottom (ft bgs)	
MW-1A		3068.8	-20.7			<b>2012.25</b>	9.58	2002.67	31.10	19.5	29.5	Prior survey TOC=2010.20
MW-1B		3050.1	-5.6			<b>2012.19</b>	9.54	2002.65	17.45	5	15	Prior survey TOC=2010.15
MW-1D		-	-	557540.8	691268.4	<b>2013.65</b>	50.70	1962.95	63.05	-	-	New well
MW-2		2790.0	273.5			<b>2014.78</b>	13.82	2000.96	20.15	8	18	
MW-3A		2283.1	177.4			<b>2070.55</b>	60.65	2009.90	67.62	52	65	
MW-5		2651.1	-8.7			<b>2072.92</b>	-	<2017.72	55.20	38	53	Dry; prior survey TOC=2070.88
MW-5D		-	-	557151.2	691279.4	<b>2075.67</b>	60.50	2015.17	69.82	-	-	New well
MW-10		2859.7	-1083.9			<b>2115.08</b>	58.98	2056.10	67.60	55	65	
MW-14		3708.3	-1370.3			<b>2049.54</b>	35.39	2014.15	42.57	29	39	
MW-15		3344.5	-1483.6			<b>2029.19</b>	13.91	2015.28	17.97	7	17	
MW-17		2496.6	-802.7			<b>2133.30</b>	71.47	2061.83	83.30	66	81	
MW-18		2710.2	-1023.1			<b>2115.40</b>	53.44	2061.96	62.08	48	63	
MW-19		3750.6	-756.4			<b>2021.00</b>	20.20	2000.80	25.80	7	22	
MW-19A		3763.6	-744.0			<b>2020.80</b>	19.62	2001.18	57.09	51.5	54	
MW-20		3552.6	-538.7			<b>2015.40</b>	13.64	2001.76	23.03	6	21	
MW-21		3341.1	-366.7			<b>2020.90</b>	18.21	2002.69	26.93	8.5	23.5	
MW-22		3191.2	-169.2			<b>2020.92</b>	18.48	2002.44	25.10	8	23	Prior survey TOC=2020.60
MW-22A		3200.8	-151.0			<b>2017.94</b>	15.15	2002.79	42.30	36.5	39.5	Prior survey TOC=2017.60
MW-23		-	-	557666.4	691140.8	<b>2007.08</b>	6.20	2000.88	30.95	-	-	New well
<b>Surface Water Locations</b>												
SW-1		2898.1	455.5			NA	NA	NA	NA	NA	NA	NA
SW-2		3952.3	-533.7			NA	NA	NA	NA	NA	NA	NA
SW-3		2578.0	-1899.0			NA	NA	NA	NA	NA	NA	NA
SW-4		4016.5	-1716.5			NA	NA	NA	NA	NA	NA	NA
<b>Other Wells</b>												
MW-3B		2311.2	186.2			NA	NA	NA	NA	NA	NA	Not sampled
MW-4		2503.9	-512.1			NA	NA	NA	NA	NA	NA	Not sampled

\* Coordinates from "Monitoring Well, Surface Water, and Leachate Pond Sample Location Map", Altamont Environmental, Inc., May 14, 2003

\*\* Coordinates from McGill 10/3/07 survey

\*\*\* Bold values from McGill 10/3/07 survey, all others from prior survey, date unknown

TOC - top of casing

amsl - above mean sea level

bgs - below ground surface

NA - not available/not applicable

Table 2  
Macon County MSW Landfill  
Permit #57-03  
2nd Semiannual 2007 Water Quality Monitoring  
Summary of Results

Analyte	Units	SWSL	MW-1A	MW-1A DUP	MW-1B	MW-1D	MW-2	MW-3A	MW-5D	MW-5D DUP	MW-10	MW-14	MW-15	MW-17	MW-18	MW-18 DUP	MW-19	MW-19A	MW-20	MW-21	MW-22	MW-22A	MW-23	SW-1	SW-2	SW-3	SW-4
Arsenic	µg/L	10	-	-	-	-	27.9	-	-	-	-	-	-	-	-	-	-	-	-	-	-	-	-	-	-	-	-
Barium	µg/L	100	-	-	-	317	261	-	1410	1100	226	119	359	125	146	139	965	-	-	-	371	-	128	-	-	-	-
Cobalt	µg/L	10	12.5	12.3	-	12.4	30.4	-	17.1	18.0	-	-	-	-	-	-	-	-	-	-	-	-	-	-	-	-	-
Copper	µg/L	10	-	-	-	-	-	-	13.2	12.0	-	-	-	-	-	-	-	-	-	-	-	-	-	-	-	-	-
Lead	µg/L	10	-	-	-	-	-	-	-	-	-	-	-	-	-	-	13.8	-	-	-	-	-	-	-	-	-	-
Zinc	µg/L	10	29.8	12.7	18.7	19.4	-	14.1	37.2	29.7	-	-	18.0	23.0	29.4	15.5	21.8	10.6	13.7	12.3	29.5	-	26.4	21.9	-	17.6	-
Benzene	µg/L	1.0	2.2	2.3	2.3	-	-	-	-	-	-	-	-	-	-	-	-	-	-	-	-	-	-	-	-	-	-
Chlorobenzene	µg/L	3.0	5.1	5.3	5.0	-	-	-	-	-	-	-	-	-	-	-	-	-	-	-	-	-	-	-	-	-	-
1,4-Dichlorobenzene	µg/L	1.0	5.9	6.6	5.7	1.3	-	-	-	-	-	-	-	-	-	-	-	-	-	-	-	-	-	-	-	-	-
Methylene chloride	µg/L	1.0	-	-	-	-	-	-	1.2	1.2	-	-	-	-	-	-	-	-	-	-	-	-	-	-	-	-	-
Vinyl chloride	µg/L	1.0	2.2	1.8	2.3	-	-	-	-	-	-	-	-	-	-	-	-	-	-	-	-	-	-	-	-	-	-
Xylenes	µg/L	3.0	-	-	-	-	-	-	5.8	4.7	-	-	-	-	-	-	-	-	-	-	-	-	-	-	-	-	-
Bis(2-ethylhexyl)phthalate	µg/L	12	22	18	30	NA	NA	NA	NA	NA	NA	NA	NA	18	NA	NA	NA	NA	NA	NA	NA	NA	NA	NA	NA	NA	NA

SWSL - Solid Waste Section Limit (µg/L)

"-" indicates that the parameter was not quantified, i.e., not detected above the SWSL

NA - not analyzed

Only parameters detected above SWSLs are listed

Samples MW-1A, MW-1A DUP, MW-1B, and MW-17 were analyzed for NCDENR Appendix II parameters; all others were analyzed for NCDENR Appendix I parameters

## APPENDIX A

### DRILLING PROCEDURES

#### **Air Hammer Drilling**

Air drilled borings will be advanced through the unconsolidated and consolidated materials using a downhole air hammer and compressed air to remove the soil and rock cuttings. The pneumatic drill hammer rapidly strikes the soil or rock while the drill pipe is slowly rotated. The drill hammers are typically constructed of alloy steel with tungsten-carbide inserts that provide the chipping or cutting surfaces. An in-line air filter is attached to the air compressor on the rig to remove oil from the air and to prevent oil contamination in the borehole.

Representative portions of the soil samples will be placed in glass jars or plastic bags. The samples will be examined by a geologist to verify the technician's and/or driller's field classifications and Soil Boring Records will be prepared. Soil borings are assumed to be advanced to their required termination depths for monitoring well installation.

#### **Hollow Stem Auger Drilling**

Soil borings will be advanced by mechanically twisting a continuous flight steel auger into the soil. Soil sampling will be performed by collecting samples of the auger cuttings or split spoon sampler, as needed.

#### **General**

To help prevent cross-contamination between borings, all downhole drilling equipment will be steam cleaned prior to drilling each boring.

## APPENDIX B

### WELL INSTALLATION PROCEDURES AND LOGS

#### **Type II Monitoring Well**

Type II ground-water monitoring wells will consist of 2-inch Schedule 40 polyvinyl chloride (PVC) casing with flush-threaded joints installed in a borehole. The bottom 5- or 10-foot section of each well will consist of a manufactured well screen with 0.01-inch wide machined slots. The well screen will be installed to the termination depth of the borehole.

In the Type II wells, a washed sand filter pack will be placed around the outside of the casing from the bottom of the well casing to from one to five feet above the top of the well screen. The sand filter pack is used to stabilize the formation and to help yield a less turbid ground-water sample.

A two-foot thick (minimum) bentonite seal will be installed on top of the sand filter pack to seal the monitoring well at the desired level. The well annulus will then be grouted to the surface with a cement/bentonite grout mixture. A lockable PVC cap and a protective steel cover will be placed over each well.

# KEY TO SOIL CLASSIFICATIONS AND CONSISTENCY DESCRIPTIONS

BUNNELL-LAMMONS ENGINEERING, INC.  
GREENVILLE, SOUTH CAROLINA

## Penetration Resistance\* Blows per Foot

SANDS

0 to 4  
5 to 10  
11 to 20  
21 to 30  
31 to 50  
over 50

## Relative Density

Very Loose  
Loose  
Firm  
Very Firm  
Dense  
Very Dense

## Particle Size Identification

Boulder: Greater than 300 mm  
Cobble: 75 to 300 mm  
Gravel:  
Coarse - 19 to 75 mm  
Fine - 4.75 to 19 mm  
Sand:  
Coarse - 2 to 4.75 mm  
Medium - 0.425 to 2 mm  
Fine - 0.075 to 0.425 mm  
Silt & Clay: Less than 0.075 mm

## Penetration Resistance\* Blows per Foot

SILTS and CLAYS

0 to 2  
3 to 4  
5 to 8  
9 to 15  
16 to 30  
31 to 50  
over 50

## Consistency

Very Soft  
Soft  
Firm  
Stiff  
Very Stiff  
Hard  
Very Hard

\*ASTM D 1586

## KEY TO DRILLING SYMBOLS



Grab Sample



Split Spoon Sample



Undisturbed Sample

NR = No reaction to HCL

NA = Not applicable

NS = No sample



Groundwater Table at Time of Drilling




Groundwater Table 24 Hours after Completion of Drilling


## KEY TO SOIL CLASSIFICATIONS




Well-graded Gravel  
GW

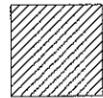

Low Plasticity Clay  
CL

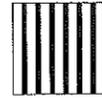


Clayey Silt  
MH

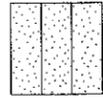


Silty Sand  
SM



Poorly-graded Gravel  
GP

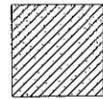


Sandy Clay  
CLS

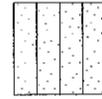


Sandy Silt  
MLS




Topsoil  
TOPSOIL

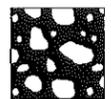


Partially Weathered Rock  
BLDRCBBL

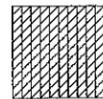

Silty Clay  
CL-ML

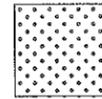

Sand  
SW

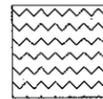


Trash  
MUCKPEAT




High Plasticity Clay  
CH



Silt  
ML

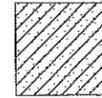

Clayey Sand  
SC

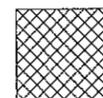


Fill  
FILL



# GROUNDWATER MONITORING WELL NO. MW-1D

**BUNNELL-LAMMONS  
ENGINEERING, INC.**  
GEOTECHNICAL AND ENVIRONMENTAL  
CONSULTANTS

PROJECT: Macon County Landfill PROJECT NO.: J07-1101-03  
 CLIENT: Macon County START: 9-20-07 END: 9-20-07  
 LOCATION: Franklin, North Carolina ELEVATION: 2010.93  
 DRILLER: Landprobe, R. Rowe/F. Caro LOGGED BY: R. Rowe  
 DRILLING METHOD: Air rotary - 6.125-inch air hammer  
 DEPTH TO - WATER> INITIAL: ▽ 48 AFTER 96 HOURS: ▽ 12.18 CAVING> ⊗

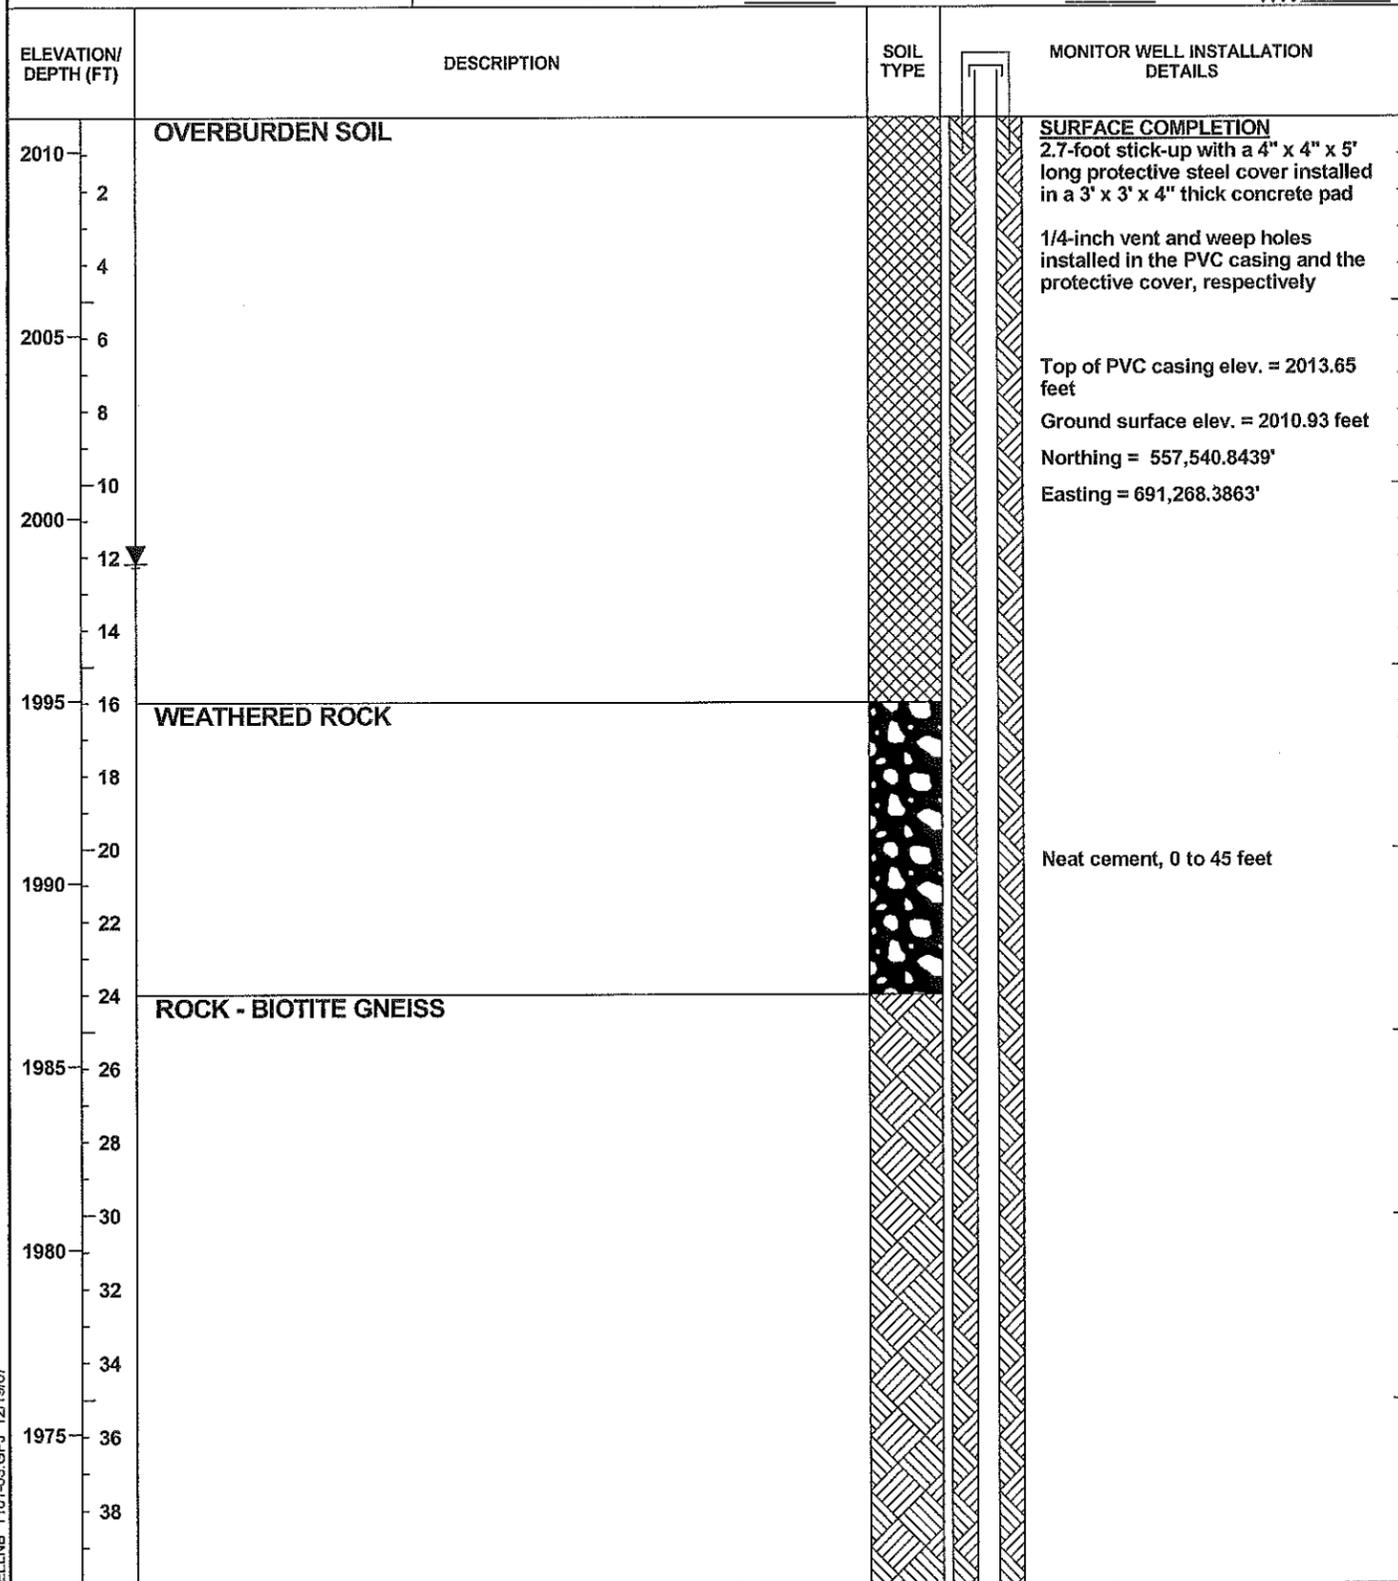




# GROUNDWATER MONITORING WELL NO. MW-1D

**BUNNELL-LAMMONS  
ENGINEERING, INC.**  
GEOTECHNICAL AND ENVIRONMENTAL  
CONSULTANTS

PROJECT: Macon County Landfill PROJECT NO.: J07-1101-03  
 CLIENT: Macon County START: 9-20-07 END: 9-20-07  
 LOCATION: Franklin, North Carolina ELEVATION: 2010.93  
 DRILLER: Landprobe, R. Rowe/F. Caro LOGGED BY: R. Rowe  
 DRILLING METHOD: Air rotary - 6.125-inch air hammer  
 DEPTH TO - WATER> INITIAL: ▽ 48 AFTER 96 HOURS: ▽ 12.18 CAVING> ☒

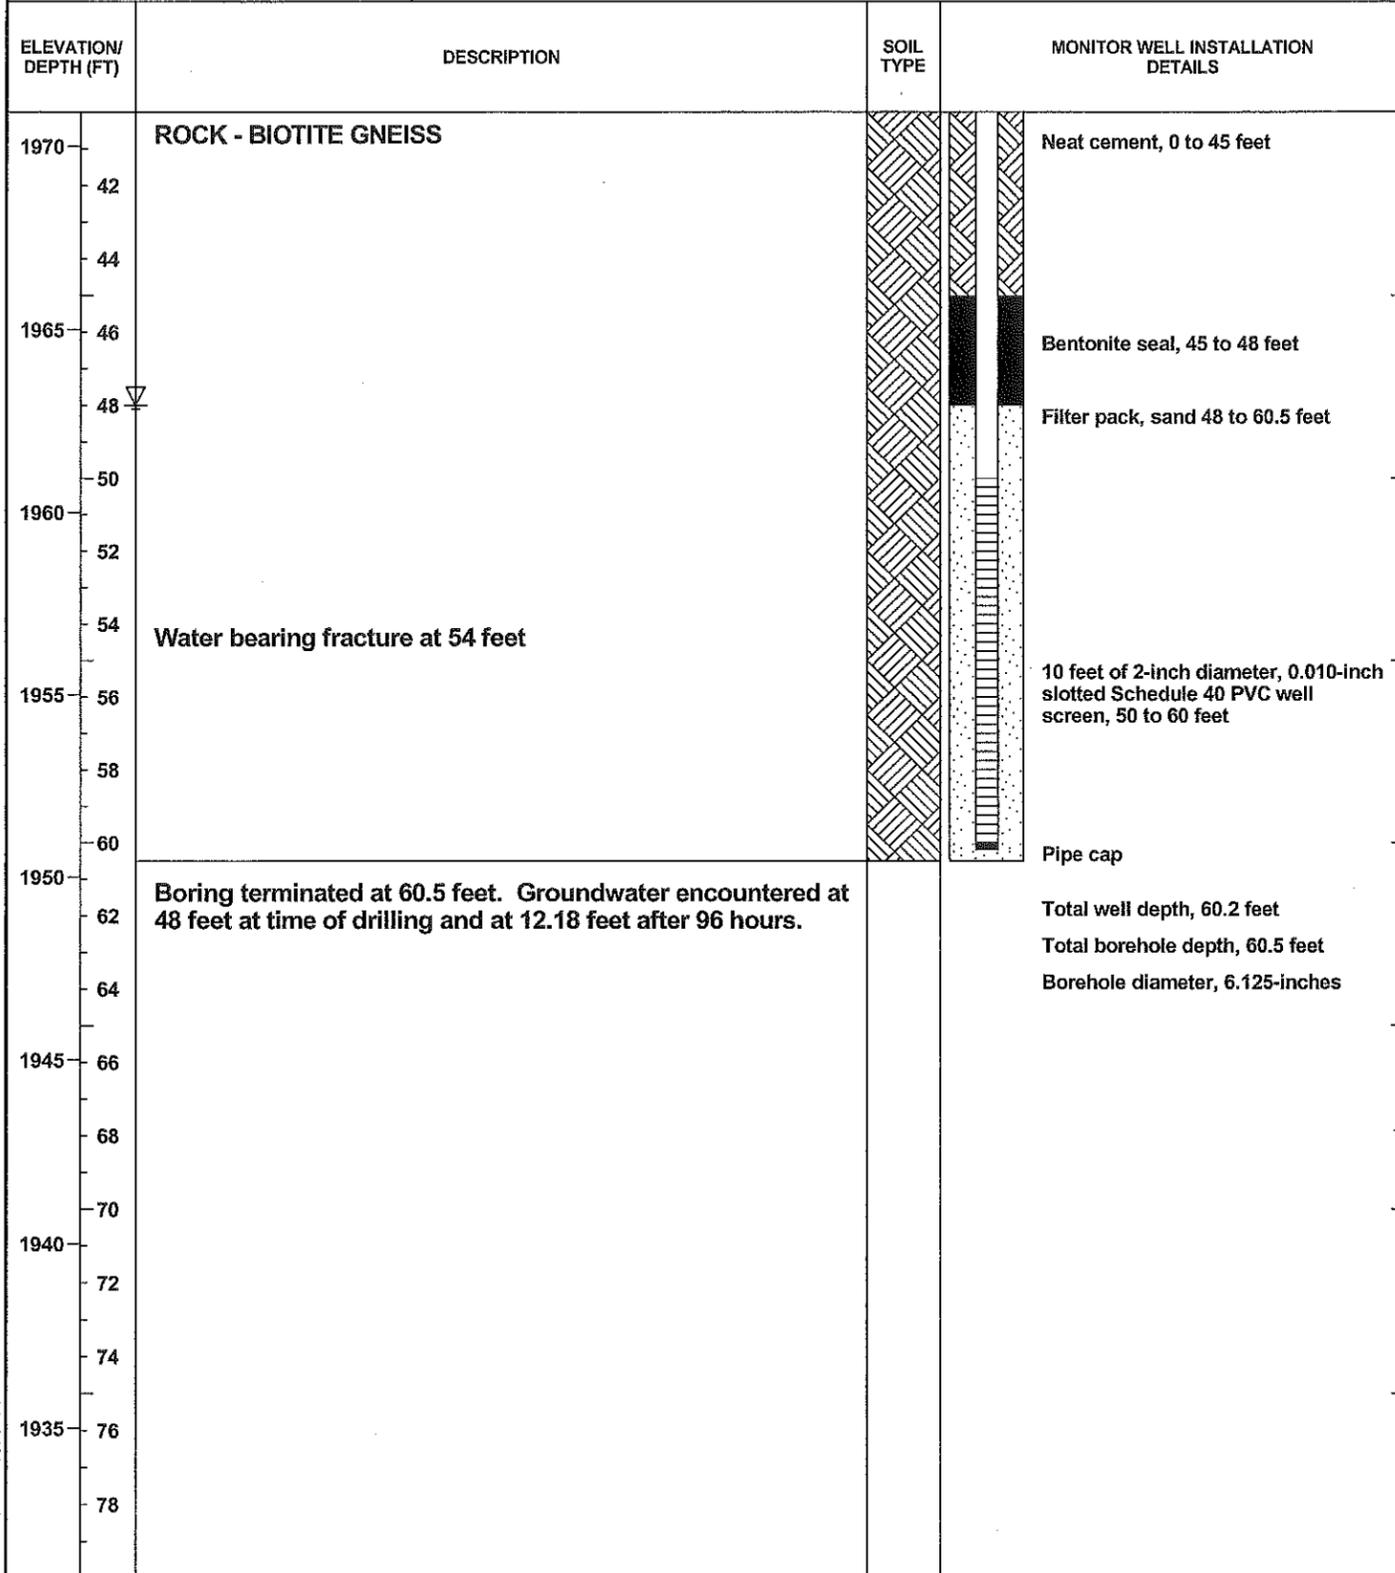




# GROUNDWATER MONITORING WELL NO. MW-5D

**BUNNELL-LAMMONS  
ENGINEERING, INC.**  
GEOTECHNICAL AND ENVIRONMENTAL  
CONSULTANTS

PROJECT: Macon County Landfill PROJECT NO.: J07-1101-03  
 CLIENT: Macon County START: 9-20-07 END: 9-20-07  
 LOCATION: Franklin, North Carolina ELEVATION: 2072.97  
 DRILLER: Landprobe, R. Rowe/F. Caro LOGGED BY: R. Rowe  
 DRILLING METHOD: Air rotary - 6.125-inch air hammer  
 DEPTH TO - WATER> INITIAL: ∇ 51 AFTER 96 HOURS: ∇ 56.92 CAVING> ⊗

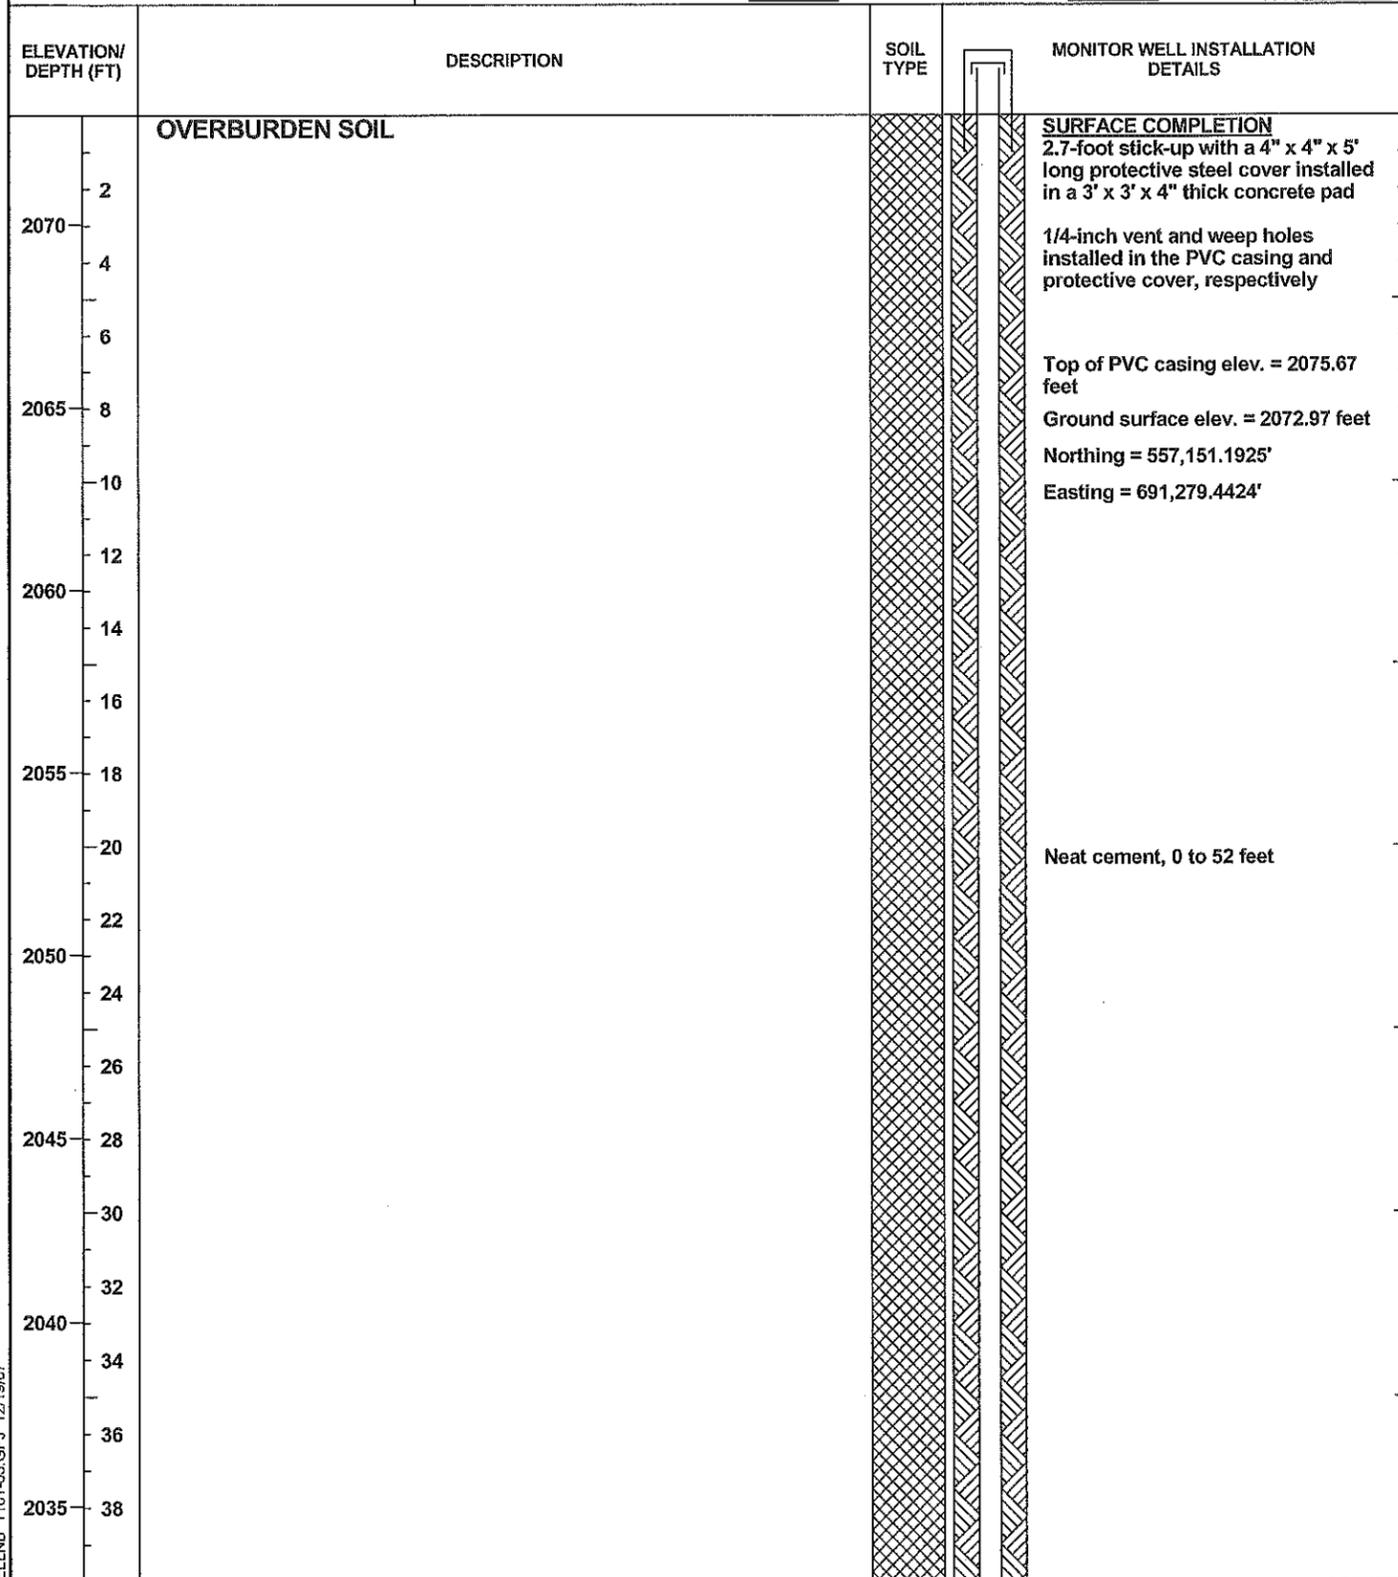


GEOC\_WELLNB 1101-03.GPJ 12/19/07



# GROUNDWATER MONITORING WELL NO. MW-5D

**BUNNELL-LAMMONS  
ENGINEERING, INC.**  
GEOTECHNICAL AND ENVIRONMENTAL  
CONSULTANTS

PROJECT: Macon County Landfill PROJECT NO.: J07-1101-03  
 CLIENT: Macon County START: 9-20-07 END: 9-20-07  
 LOCATION: Franklin, North Carolina ELEVATION: 2072.97  
 DRILLER: Landprobe, R. Rowe/F. Caro LOGGED BY: R. Rowe  
 DRILLING METHOD: Air rotary - 6.125-inch air hammer  
 DEPTH TO - WATER> INITIAL: ▽ 51 AFTER 96 HOURS: ▽ 56.92 CAVING> ☒

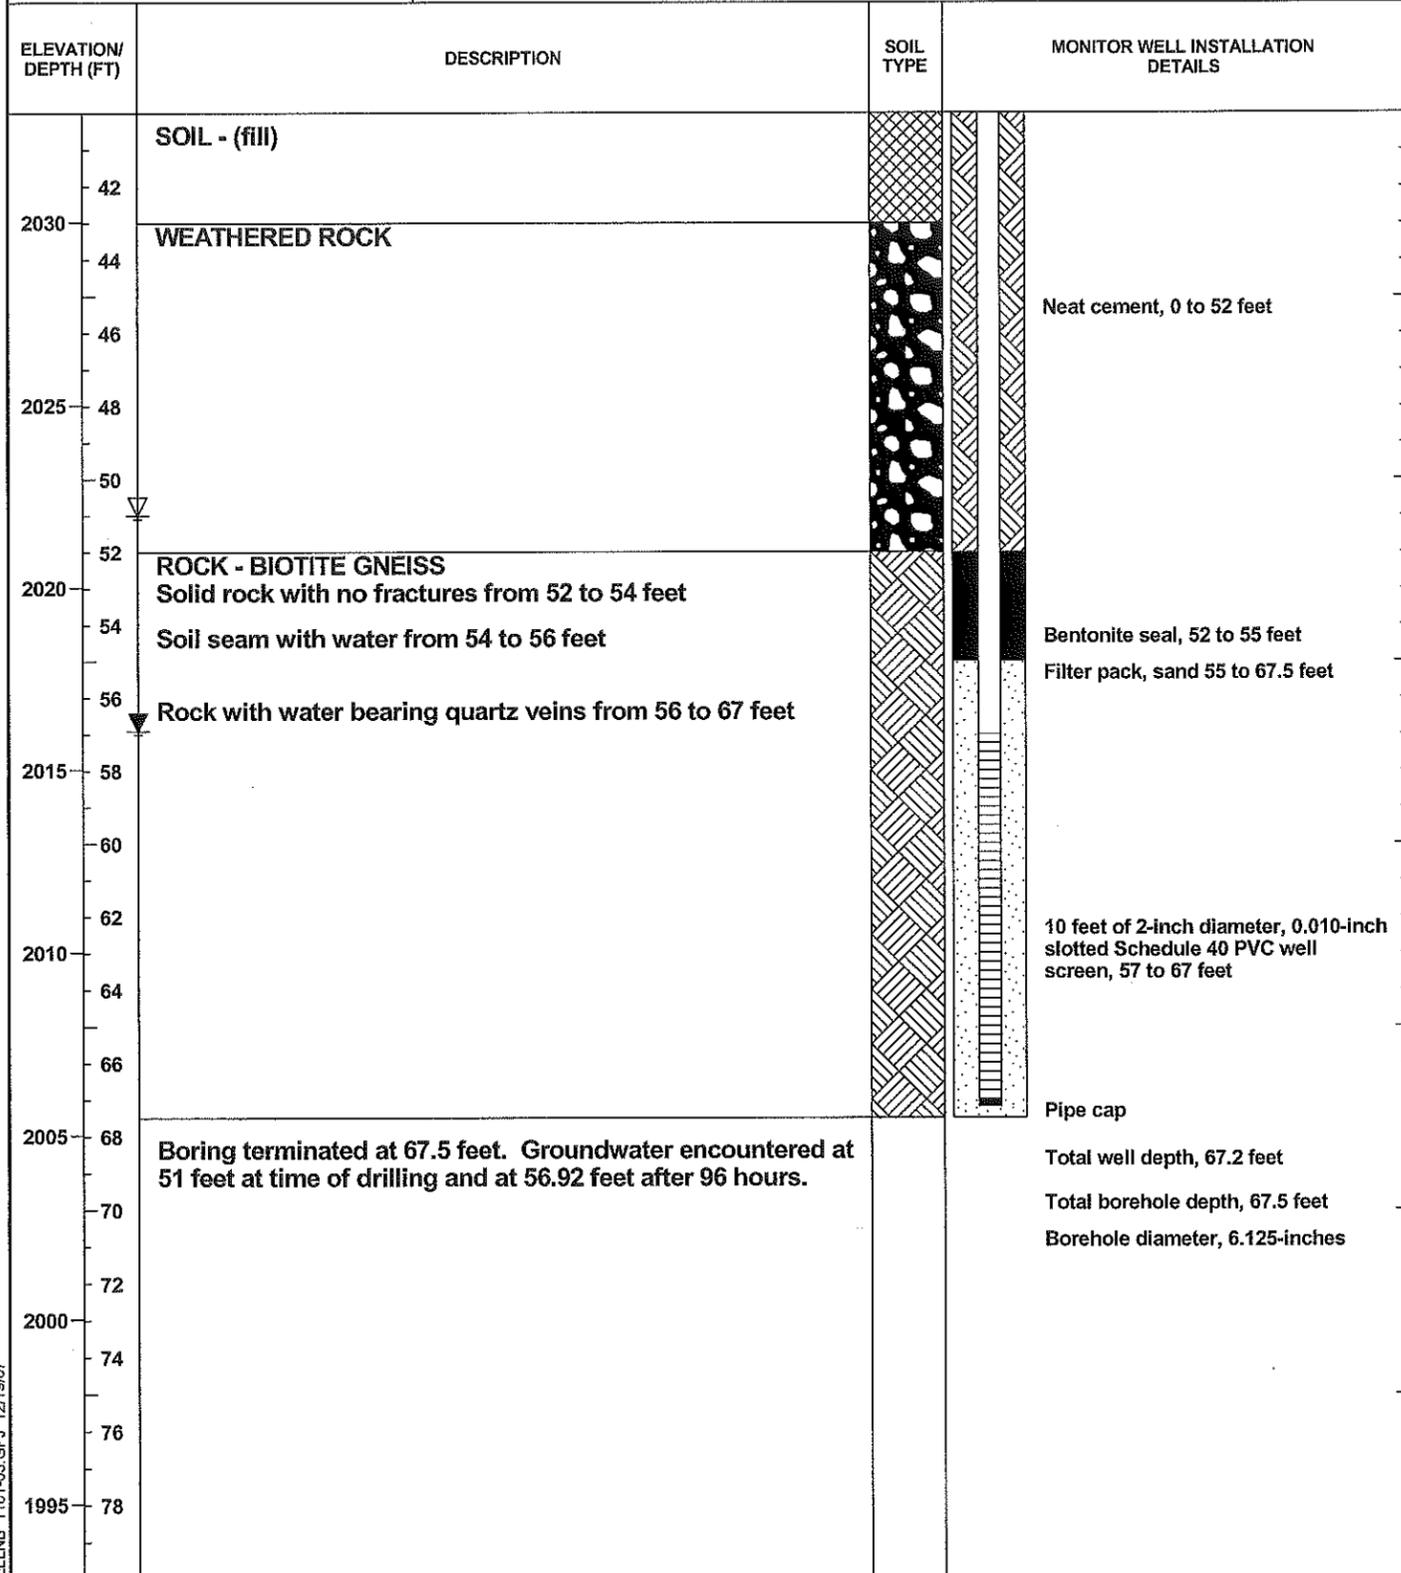




**BUNNELL-LAMMONS  
ENGINEERING, INC.**  
GEOTECHNICAL AND ENVIRONMENTAL  
CONSULTANTS

## GROUNDWATER MONITORING WELL NO. MW-23

PROJECT: Macon County Landfill PROJECT NO.: J07-1101-03  
 CLIENT: Macon County START: 9-12-07 END: 9-12-07  
 LOCATION: Franklin, North Carolina ELEVATION: 2004.34  
 DRILLER: Landprobe, T. Gradwell, BE LOGGED BY: T. Gradwell  
 DRILLING METHOD: 4-1/4 ID inch hollow stem auger (8.25-inch OD)  
 DEPTH TO - WATER> INITIAL: ∇ 3.1 AFTER 96 HOURS: ∇ 3.25 CAVING: ☒

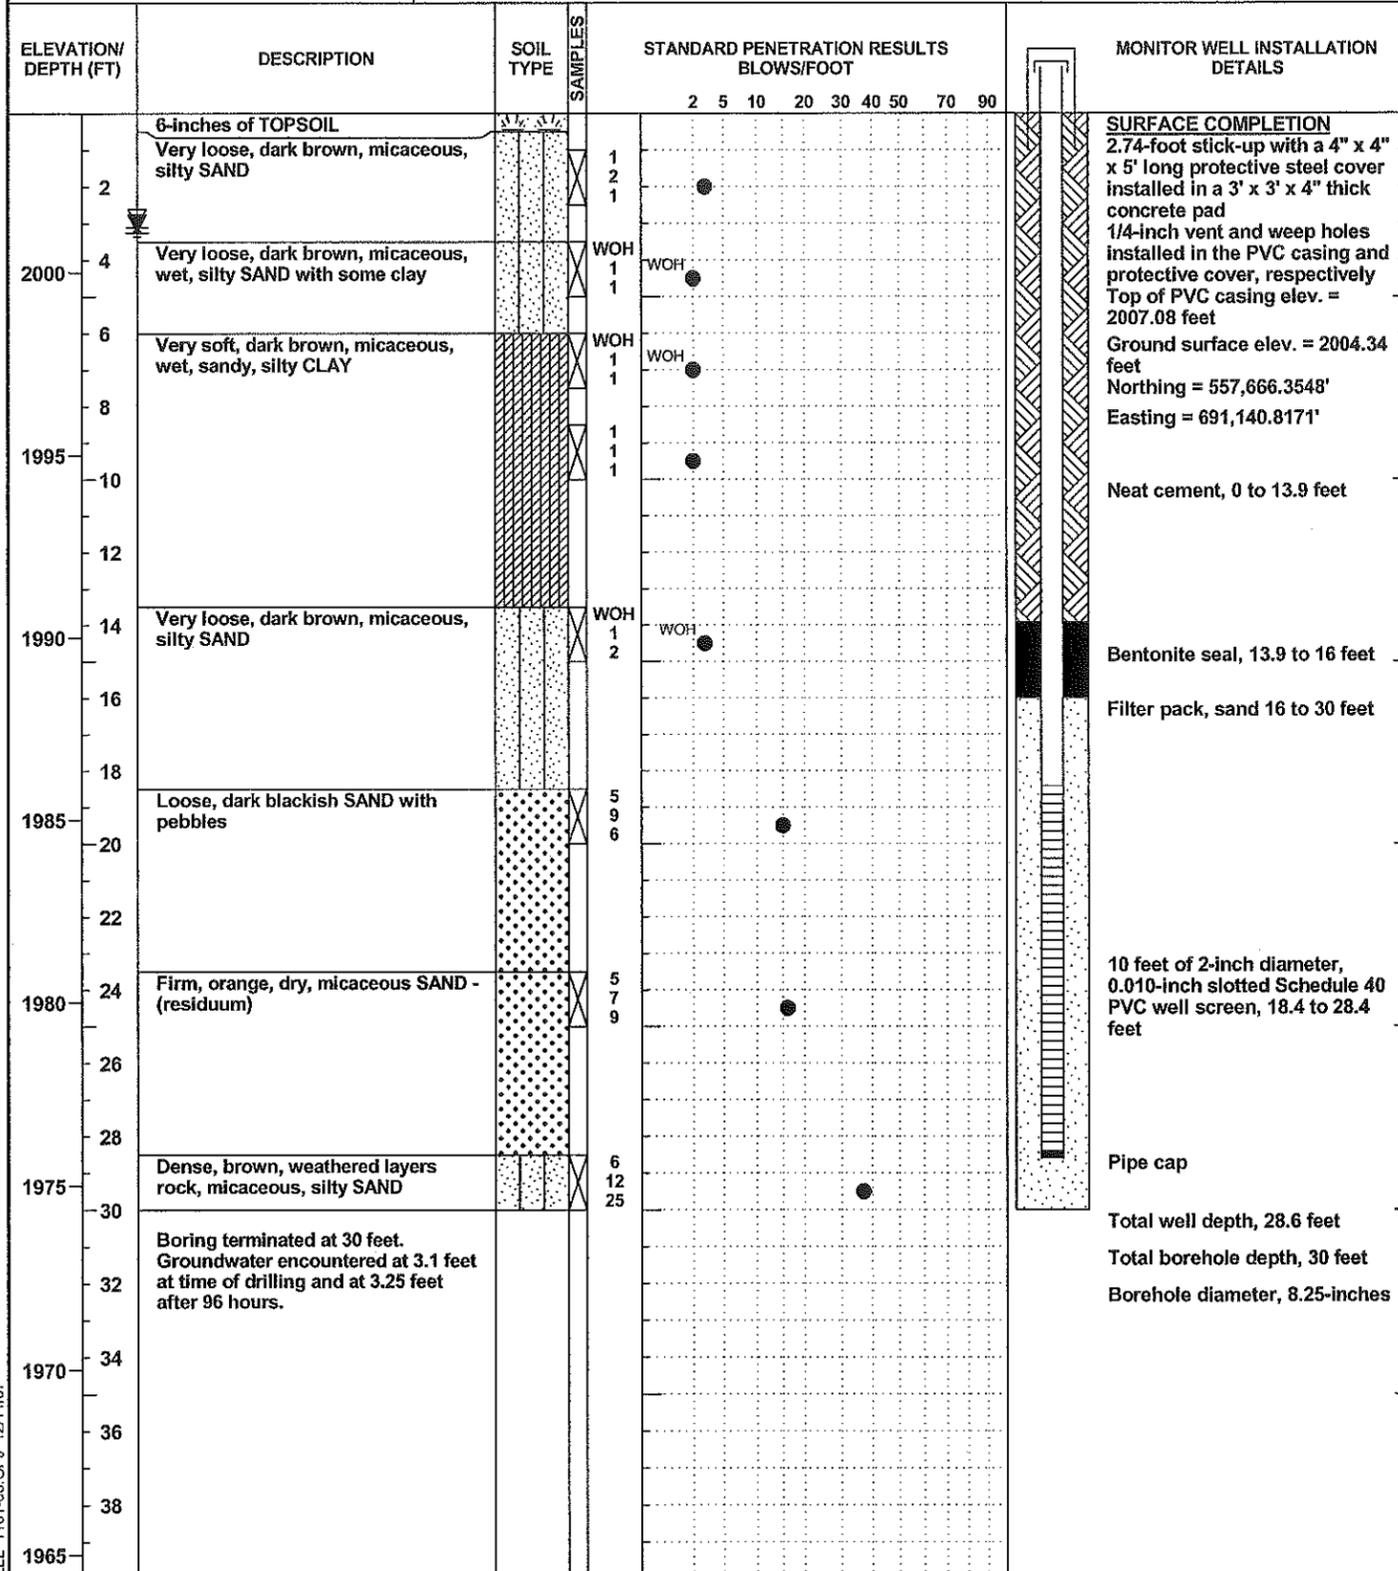

**APPENDIX C**

**MONITORING WELL DEVELOPMENT LOGS**







**APPENDIX D**


**SURVEY MAP AND DATA**

MONITORING WELL SURVEY DATA - OCT. 3, 2007

WELL #	TOP OF CASING ELEV. (FT)	HAUL ELEV. (FT)
MW-1A	2072.25	2010.38
MW-1B	2072.19	2010.30
MW-1D	2072.65	2010.33
MW-5	2072.82	2071.87
MW-5D	2076.87	2072.87
MW-23	2080.82	2071.86
MW-23A	2077.94	2018.17
MW-23	2077.98	2004.34

MONITORING WELL COORDINATE DATA

WELL #	HORTHING	EASTING	LATITUDE	LONGITUDE
MW-1D	807,840,843.8	801,268,384.3	N 35.202877968	W 83.382500430
MW-5D	807,101,192.8	804,270,444.4	N 35.201488744	W 83.382410880
MW-23	807,082,304.8	807,140,877.1	N 35.202887005	W 83.382500387

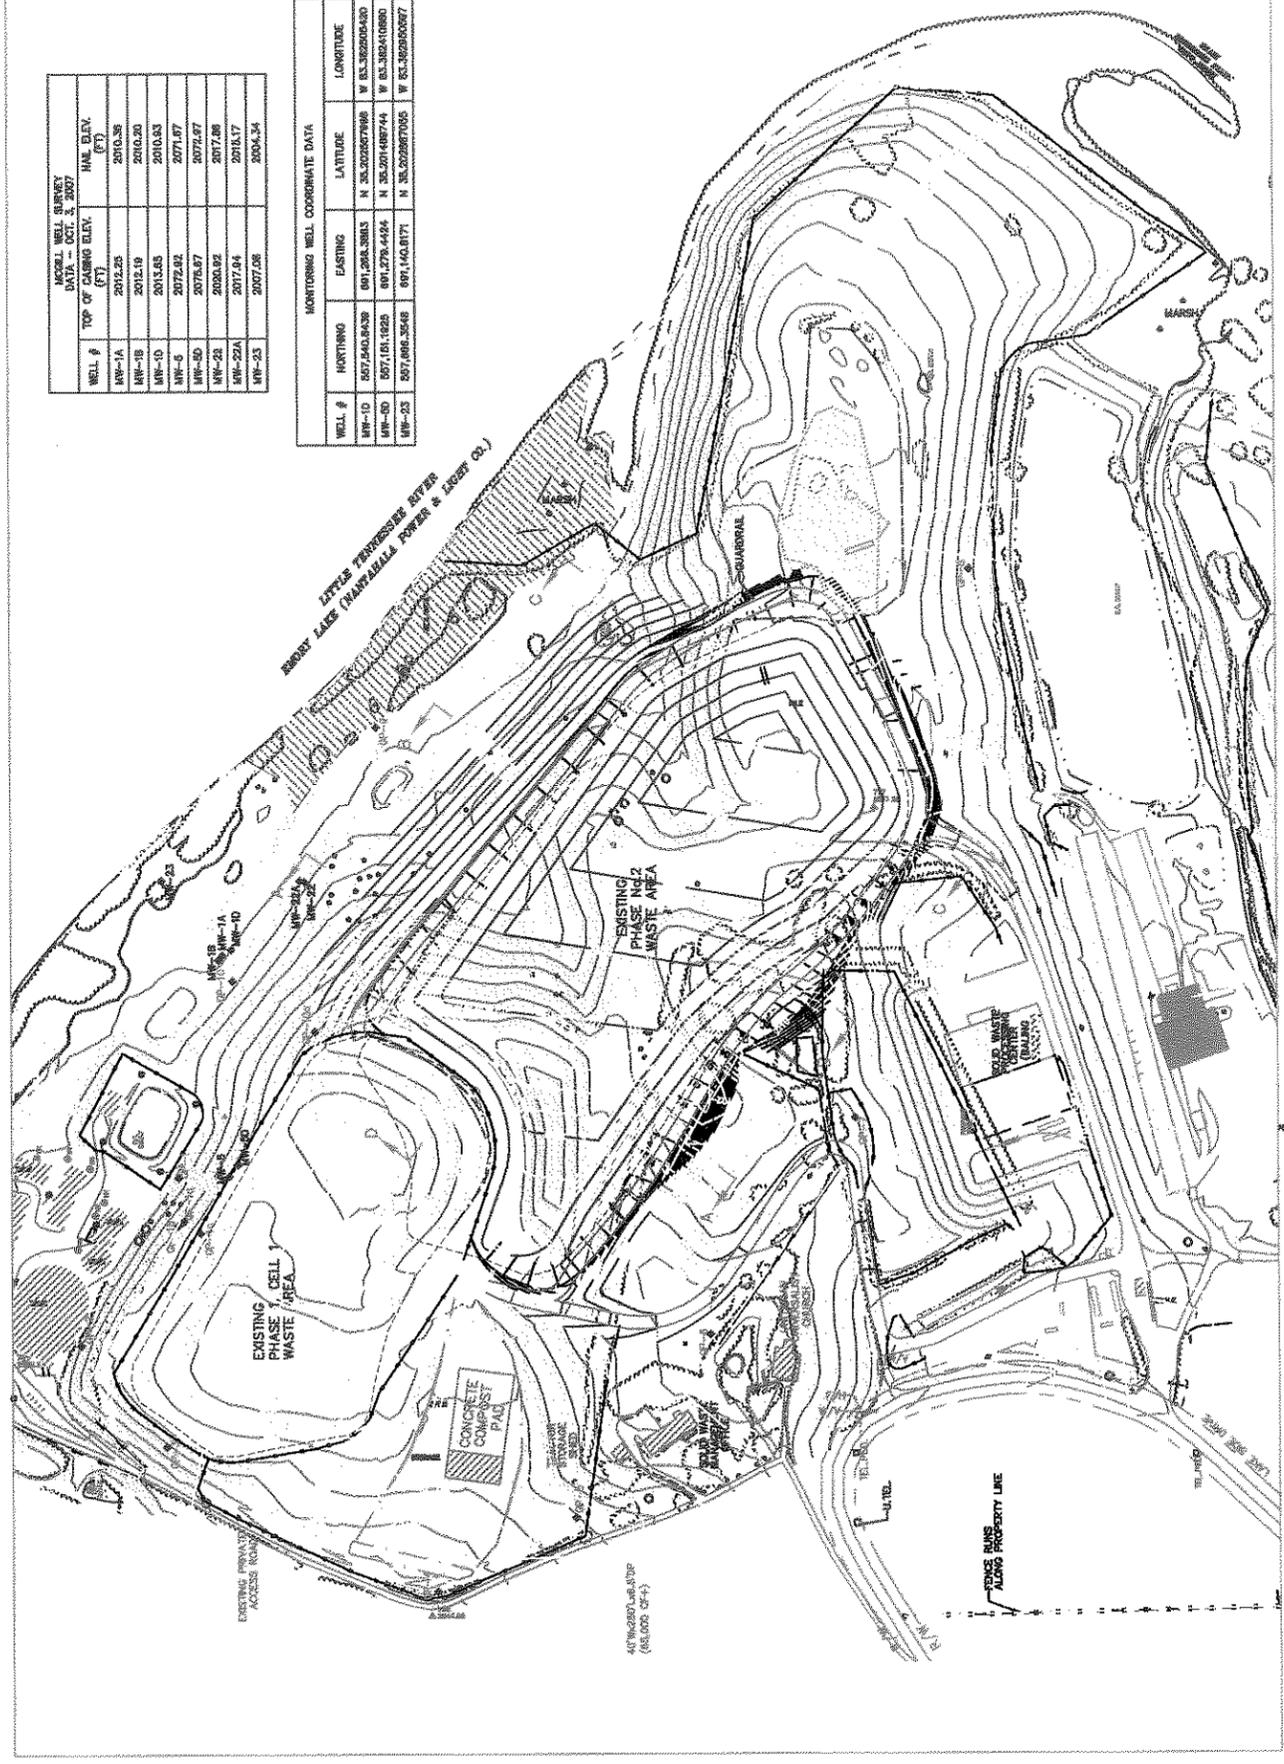

EXISTING PHASE 1 CELL WASTE AREA


CONCRETE COMPOST PILE

EXISTING PHASE 2 WASTE AREA

FENCE RUNS ALONG PROPERTY LINE


LETTER TRANSMISSION SYSTEM

40' WIDE PLANT STOP (BEHIND OFF)

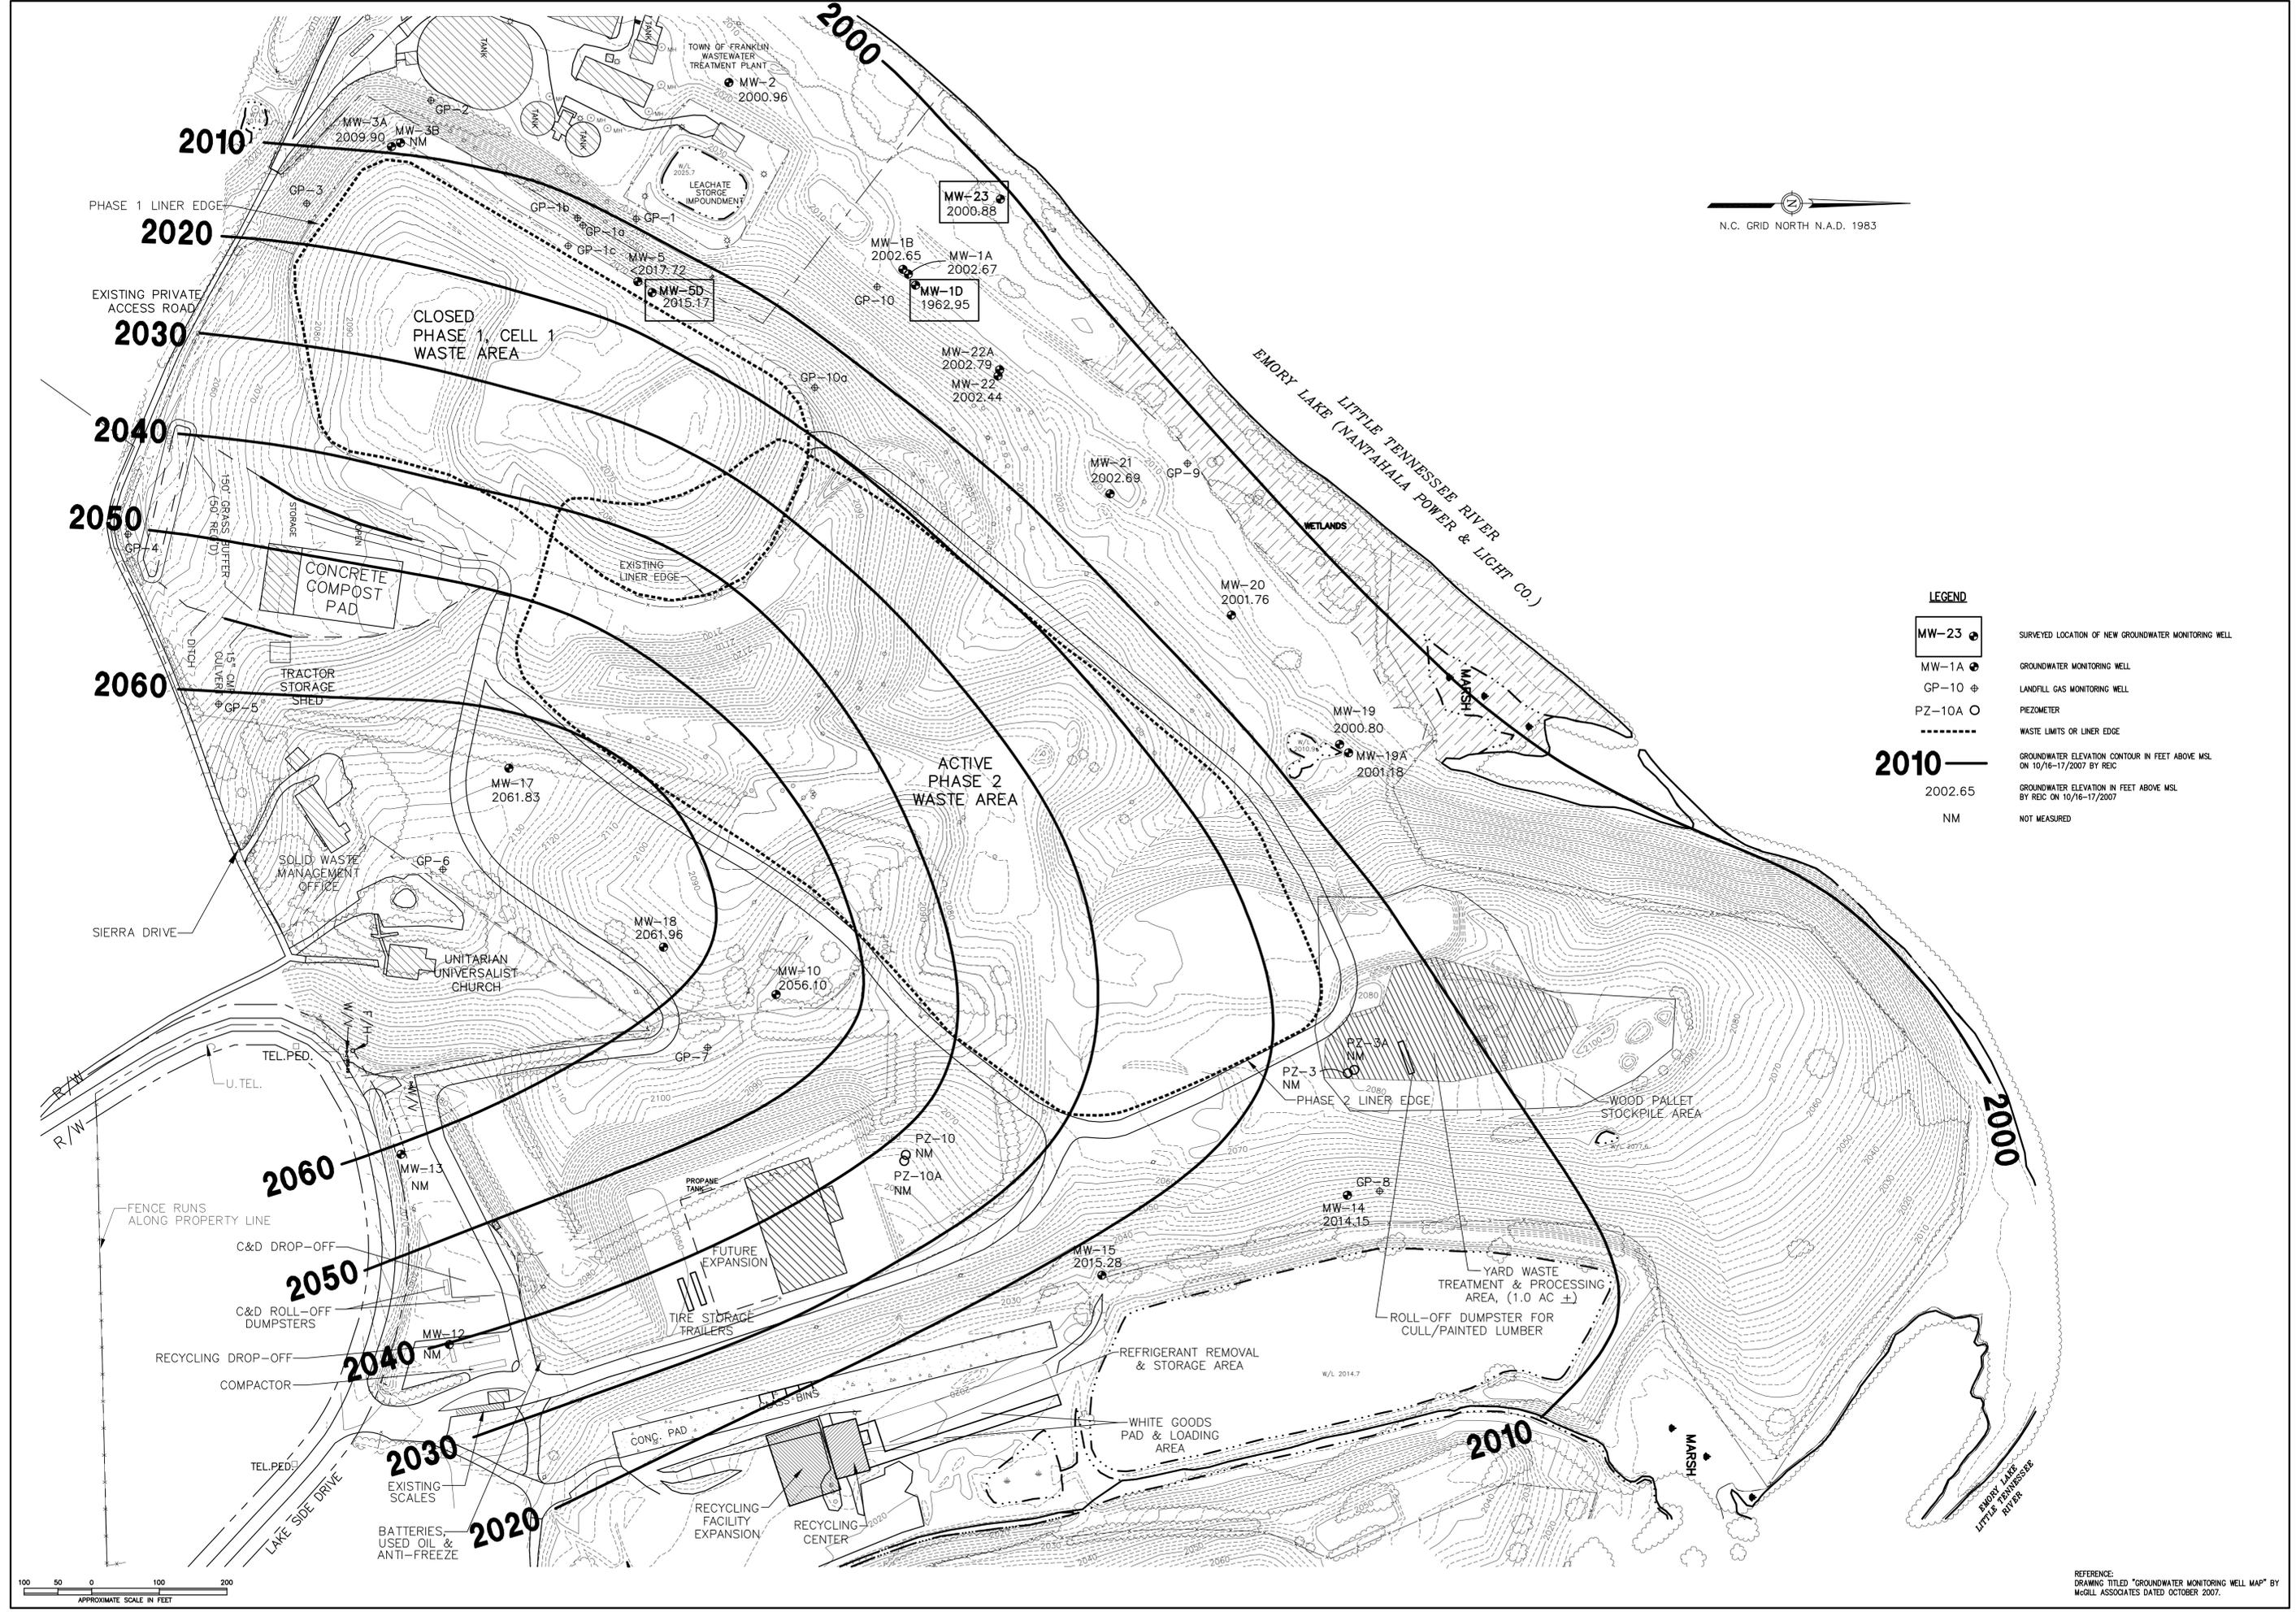

N.C. GRID NORTH N.A.D. 1983

- LEGEND**
- MW-23 SURVEYED LOCATION OF NEW GROUNDWATER MONITORING WELL
  - MW-1A GROUNDWATER MONITORING WELL
  - GP-10 LANDFILL GAS MONITORING WELL
  - PZ-10A PIEZOMETER
  - WASTE LIMITS OR LINER EDGE
  - 2010 GROUNDWATER ELEVATION CONTOUR IN FEET ABOVE MSL ON 10/16-17/2007 BY REIC
  - 2002.65 GROUNDWATER ELEVATION IN FEET ABOVE MSL BY REIC ON 10/16-17/2007
  - NM NOT MEASURED

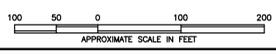

REFERENCE: DRAWING TITLED "GROUNDWATER MONITORING WELL MAP" BY MGLL ASSOCIATES DATED OCTOBER 2007.

No.	REVISIONS DESCRIPTION	BY

DRAWN: AEH	DATE: 11-01-07
CHECKED: AWA	CAD FILE: MACONCLF-03GCWCM
APPROVED:	JOB NO: J07-1101-03

**IBL** INC. **BUNNELL-LAMMONS ENGINEERING, INC.**  
 6004 POWERS COURT GREENVILLE, SOUTH CAROLINA 29615  
 PHONE: (864)258-2258 FAX: (864)258-4430

**LEGEND**

MW-1A ⊕ GROUNDWATER MONITORING WELL  
 GP-10 ⊕ LANDFILL GAS MONITORING WELL  
 PZ-10A ○ PIEZOMETER  
 - - - - - WASTE LIMITS OR LINER EDGE  
 ND NOT DETECTED ABOVE THE SWSL  
 NS NOT SAMPLED  
 NA NOT APPLICABLE/NOT ANALYZED

**NOTES:**

1. WELLS SAMPLED BY REIC ON 10-16-07. APPENDIX II SAMPLING LIST FOR MW-17, MW-1A AND MW-1B.  
 2. REMAINING WELLS SAMPLED FOR APPENDIX I LIST. METALS RESULTS NOT SHOWN.



MONITORING WELL #		MW-1B
BENZENE	ug/l	2.3
CHLOROBENZENE	ug/l	5.0
1,4-DICHLOROBENZENE	ug/l	5.7
METHYLENE CHLORIDE	ug/l	ND
VINYL CHLORIDE	ug/l	2.3
XYLENES	ug/l	ND
BIS(2-ETHYLHEXYL)PHTHALATE	ug/l	30

MONITORING WELL #		MW-1A
BENZENE	ug/l	2.2
CHLOROBENZENE	ug/l	5.1
1,4-DICHLOROBENZENE	ug/l	5.9
METHYLENE CHLORIDE	ug/l	ND
VINYL CHLORIDE	ug/l	2.2
XYLENES	ug/l	ND
BIS(2-ETHYLHEXYL)PHTHALATE	ug/l	22

MONITORING WELL #		MW-1D
BENZENE	ug/l	ND
CHLOROBENZENE	ug/l	ND
1,4-DICHLOROBENZENE	ug/l	1.3
METHYLENE CHLORIDE	ug/l	ND
VINYL CHLORIDE	ug/l	ND
XYLENES	ug/l	ND
BIS(2-ETHYLHEXYL)PHTHALATE	ug/l	NA

MONITORING WELL #		MW-5D
BENZENE	ug/l	ND
CHLOROBENZENE	ug/l	ND
1,4-DICHLOROBENZENE	ug/l	ND
METHYLENE CHLORIDE	ug/l	1.2
VINYL CHLORIDE	ug/l	ND
XYLENES	ug/l	5.8
BIS(2-ETHYLHEXYL)PHTHALATE	ug/l	NA

MONITORING WELL #		MW-17
BENZENE	ug/l	ND
CHLOROBENZENE	ug/l	ND
1,4-DICHLOROBENZENE	ug/l	ND
METHYLENE CHLORIDE	ug/l	ND
VINYL CHLORIDE	ug/l	ND
XYLENES	ug/l	ND
BIS(2-ETHYLHEXYL)PHTHALATE	ug/l	18

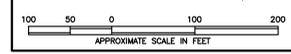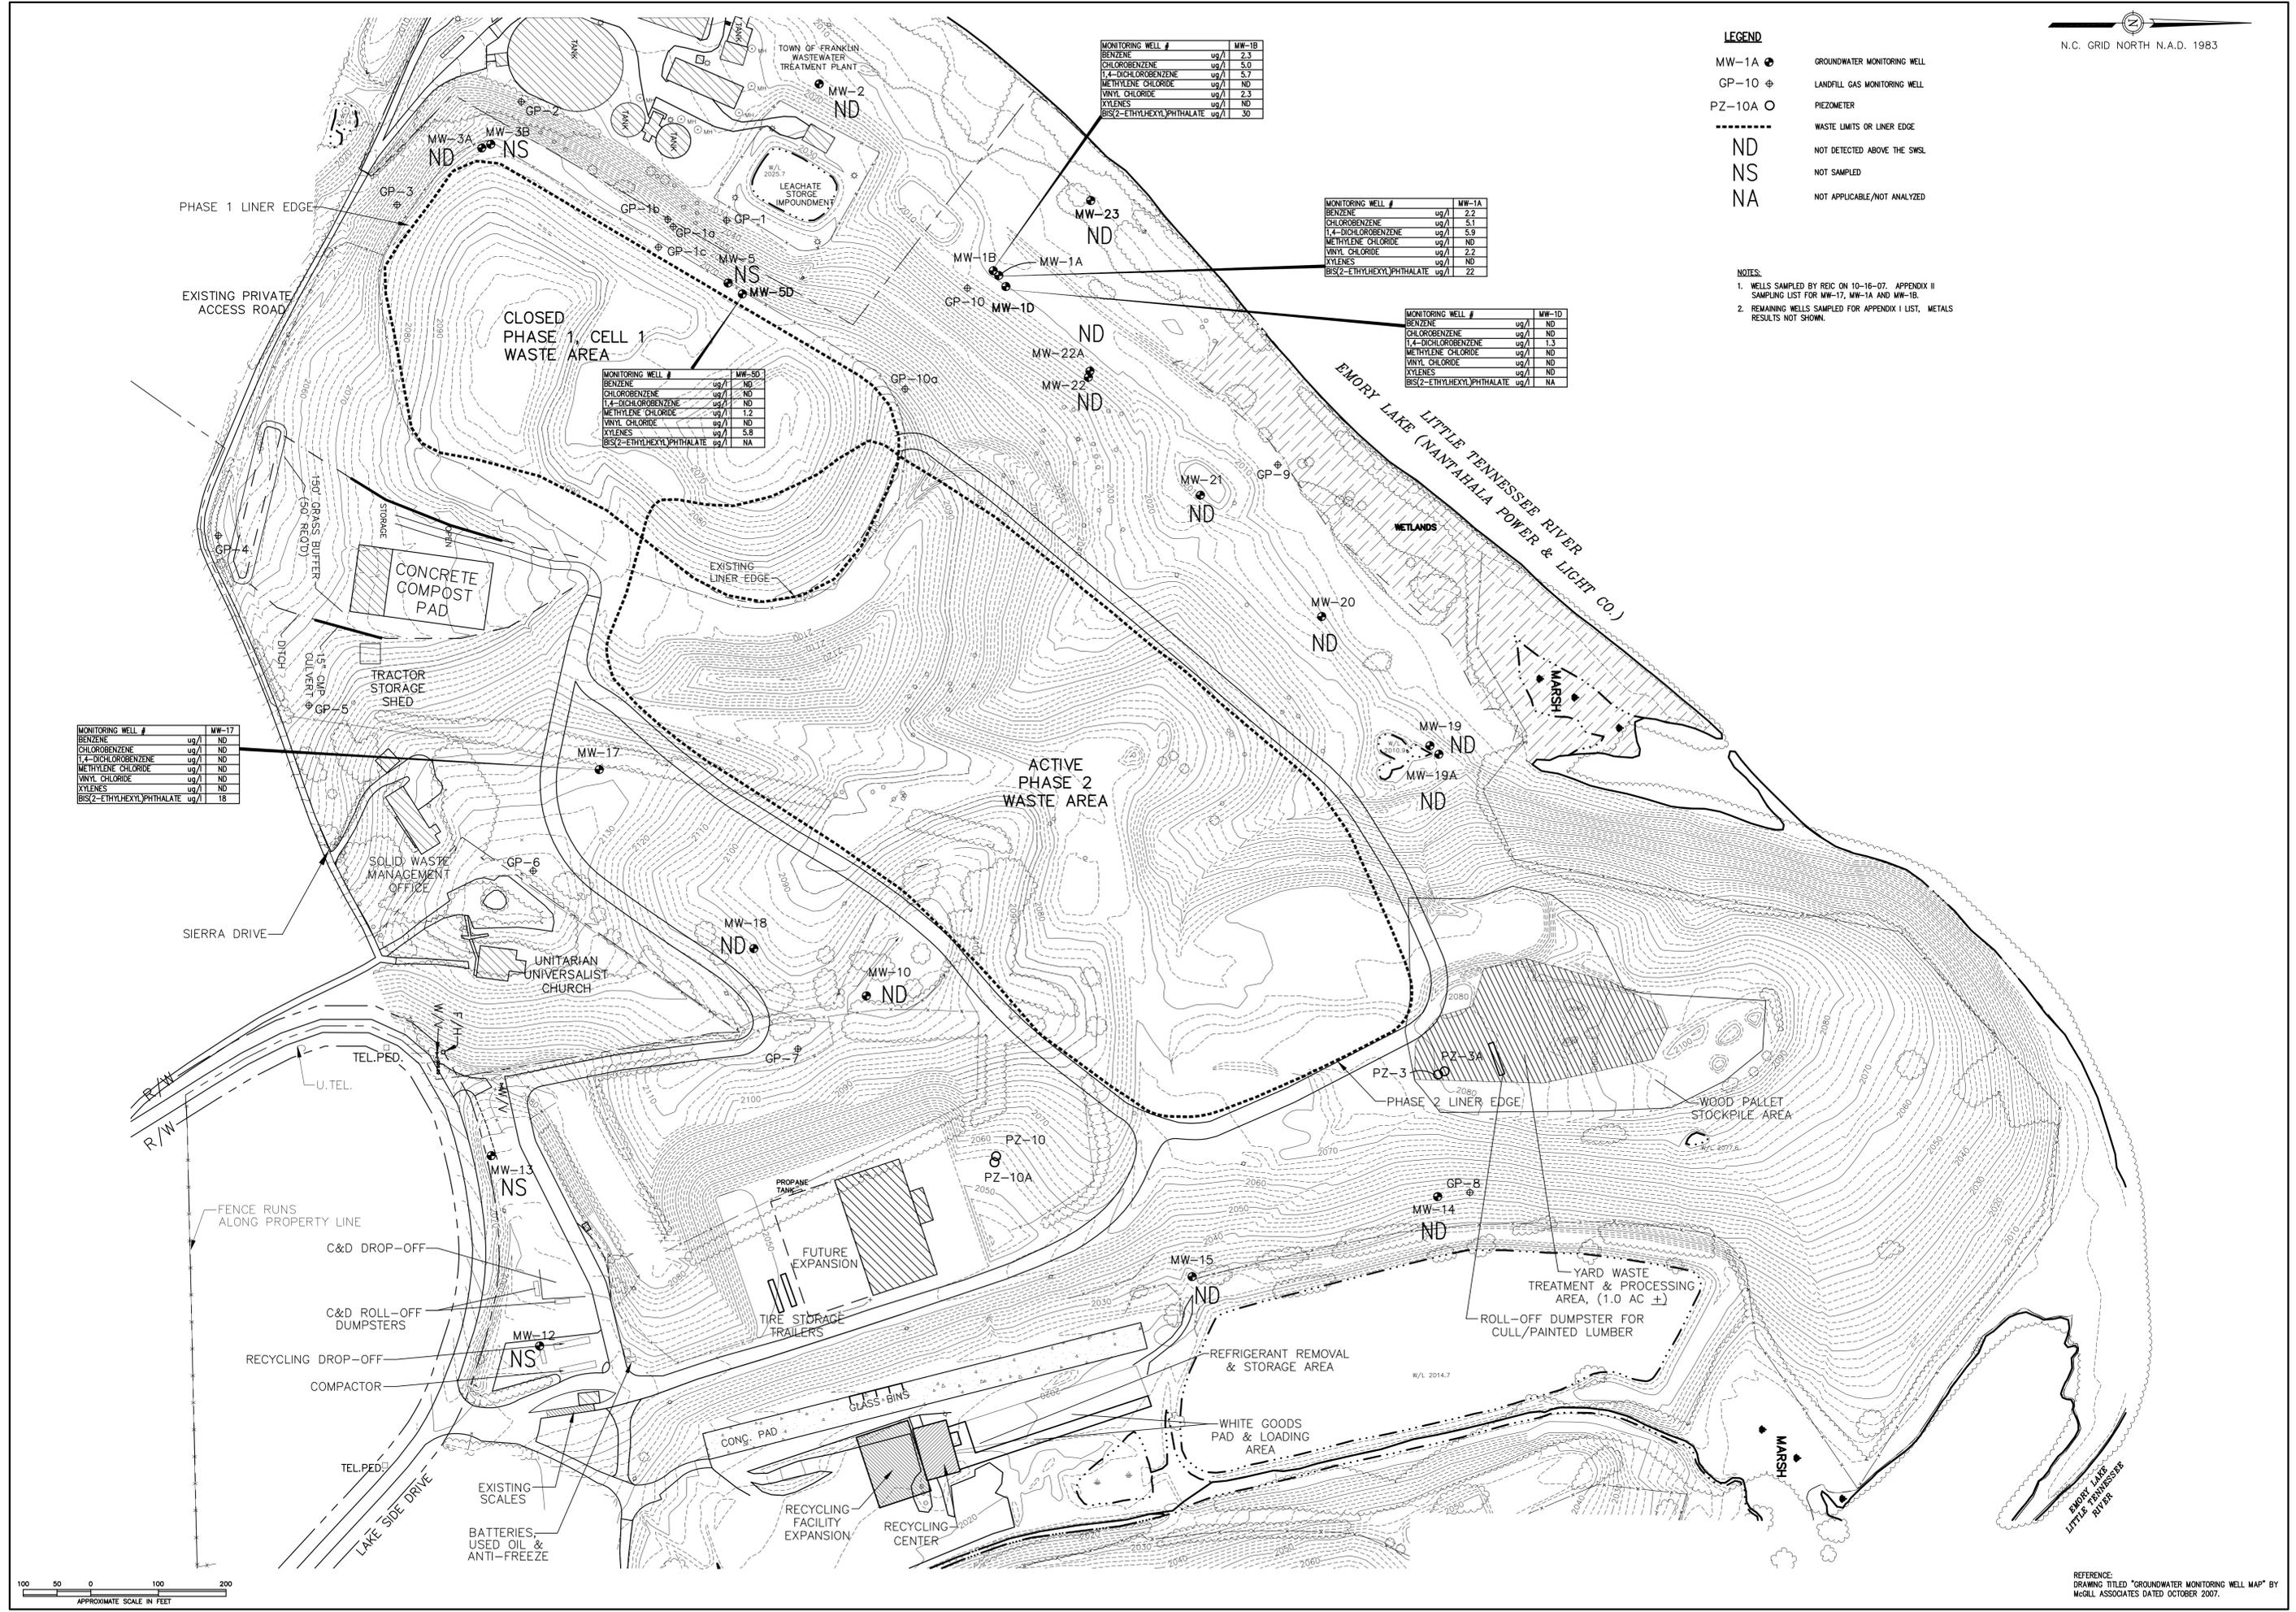

REFERENCE: DRAWING TITLED "GROUNDWATER MONITORING WELL MAP" BY MCGILL ASSOCIATES DATED OCTOBER 2007.

No.	REVISIONS DESCRIPTION	BY

DRAWN: AEH	DATE: 12-03-07
CHECKED: AWA	CAD FILE: MACONCLF-03CWOC
APPROVED:	JOB NO: J07-1101-03

**IBLE INC.**

**BUNNELL-LAMMONS ENGINEERING, INC.**  
 6004 POWERS COURT  
 GREENVILLE, NORTH CAROLINA 28905  
 PHONE: (864)258-2858 FAX: (864)258-4490