



**GENERAL NOTES**

- ALL CONSTRUCTION OUTSIDE RIGHTS-OF-WAY SHALL TAKE PLACE WITHIN THE PERMANENT AND TEMPORARY ACCESS EASEMENTS SHOWN.
- CONTRACTOR SHALL REPAIR ALL DISTURBED AREAS TO EQUAL OR BETTER CONDITION THAN THE ORIGINAL SITE, OR AS NOTED.
- LOCATIONS OF EXISTING UTILITIES AS SHOWN ARE APPROXIMATE ONLY. EXACT LOCATIONS ARE TO BE VERIFIED IN THE FIELD BY THE CONTRACTOR. AT LEAST THREE DAYS PRIOR TO CONSTRUCTION, CONTRACTOR MUST NOTIFY EXISTING UTILITY OWNERS. CALL BEFORE YOU DIG. NORTH CAROLINA ONE CALL (1-800-632-4949).
- ALL WORK NEAR AND AROUND WATERWAYS MUST CONFORM TO THE RULES OF THE STATE OF NORTH CAROLINA.
- CONTRACTOR MUST PROVIDE EROSION CONTROL DEVICES TO CONTROL RUNOFF FROM THE CONSTRUCTION SITE. CONTRACTOR WILL BE RESPONSIBLE FOR ANY FINES THAT MAY BE LEVIED DUE TO POLLUTION CREATED DURING CONSTRUCTION.
- CONTRACTOR SHALL FOLLOW ALL FEDERAL, STATE AND LOCAL HEALTH AND SAFETY REGULATIONS PERTAINING TO CONSTRUCTION OPERATIONS.
- WATER LINES SHALL HAVE 3"-0" MINIMUM COVER UNLESS OTHERWISE SHOWN ON THE DRAWINGS.
- WATER AND SEWER LINES SHALL HAVE A MINIMUM 10' HORIZONTAL SEPARATION OR A MINIMUM 18" VERTICAL SEPARATION WITH THE WATER OVER SEWER, OR BOTH WATER AND SEWER LINES SHALL BE DUCTILE IRON PIPE 10' EITHER SIDE OF THE CROSSING.
- WATER AND STORM SEWER LINES SHALL HAVE A MINIMUM 12" VERTICAL SEPARATION.
- SEE PROJECT SPECIFICATIONS FOR ADDITIONAL INFORMATION.
- LEGAL DESCRIPTIONS FOR PROPOSED EASEMENTS BY OTHERS.
- CONTRACTOR SHALL NOTIFY THE PROPER LOCAL AUTHORITIES 24 HOURS PRIOR TO ANY ROAD BEING CLOSED FOR CONSTRUCTION, INCLUDING BUT NOT LIMITED TO LOCAL NEWSPAPER, RADIO STATION, FIRE DEPARTMENT, COUNTY SHERIFF'S DEPARTMENT, AMBULANCE, AND COUNTY EMERGENCY AGENCY. ALL TRAFFIC CONTROL SHALL CONFORM TO THE REQUIREMENTS OF THE NORTH CAROLINA DEPARTMENT OF TRANSPORTATION.
- CONTRACTOR SHALL NOTIFY THE ENGINEER AFTER EXISTING BURIED UTILITIES HAVE BEEN LOCATED AND 24 HOURS PRIOR TO CONSTRUCTION.
- ALL FENCE DAMAGED DURING CONSTRUCTION SHALL BE REPLACED WITH LIKE MATERIALS IN A WORKMANLIKE MANNER AND IN ACCORDANCE WITH STANDARD FENCE CONSTRUCTION PRACTICES AT THE CONTRACTOR'S EXPENSE.
- CONTRACTOR SHALL FIELD LOCATE ALL BURIED TELEPHONE LINE IN CONFLICT WITH CONSTRUCTION. WHERE NECESSARY, EXISTING BURIED TELEPHONE LINE SHALL BE TEMPORARILY MOVED DURING CONSTRUCTION AND RE-LAID AT NO ADDITIONAL COST TO THE OWNER.
- CONTRACTOR SHALL BE RESPONSIBLE FOR ANY DAMAGE TO EXISTING ROADS DURING CONSTRUCTION AND SHALL REPAIR ROADS PER REQUIREMENTS OF THE NORTH CAROLINA DEPARTMENT OF TRANSPORTATION. NO OPEN CUTS OF EXISTING ROADS SHALL BE ALLOWED EXCEPT WHERE INDICATED ON THE DRAWINGS OR WHERE SPECIFIC PERMISSION IS GRANTED BY THE NORTH CAROLINA DEPARTMENT OF TRANSPORTATION. SAND OR A SIMILAR MATERIAL APPROVED BY THE NORTH CAROLINA DEPARTMENT OF TRANSPORTATION SHALL BE PLACED ON THE ROAD TO AID IN THE CLEAN UP AFTER CONSTRUCTION. A MINIMUM OF 2" OF SAND SHALL BE PLACED ON THE ROAD PRIOR TO STOCKPILING SPOIL MATERIAL ON THE ROAD SURFACE TO FACILITATE CLEANUP.

**GENERAL CONSTRUCTION NOTES**

REVISION DATE - JUNE 16, 2009

- FINISH GRADE TOLERANCES SHALL BE AS NOTED IN THE SPECIFICATIONS. THE ENGINEER MAY MAKE GRADE CHANGES AS REQUIRED IN THE FIELD WITHOUT EFFECTING THE BID PRICE.
- UNLESS OTHERWISE STATED, ALL FILL AREAS SHALL BE CONSTRUCTED IN LAYERS OF 8" MAXIMUM THICKNESS, WITH WATER ADDED OR SOIL CONDITIONED TO THE OPTIMUM MOISTURE CONTENT AS DETERMINED BY THE ENGINEER AND COMPACTED WITH A SHEEP'S FOOT ROLLER TO A COMPACTION EQUAL TO OR GREATER THAN 95% (100% IN THE TOP 2" OF THE SUB GRADE BELOW ROADWAYS AND PARKING LOTS) OF THE DENSITY OBTAINED BY COMPACTING A SAMPLE OF THE MATERIAL IN ACCORDANCE WITH THE STANDARD PROCTOR METHOD OF MOISTURE-DENSITY RELATIONSHIP TEST, ASTM D698 OR AASHTO-99 UNLESS SPECIFIED IN OTHER SPECIFICATIONS.
- ENTIRE AREA TO BE GRADED SHALL BE CLEARED AND GRUBBED. NO FILL SHALL BE PLACED ON ANY AREA NOT CLEARED AND GRUBBED.
- ALL SOIL EROSION CONTROL MEASURES REQUIRED BY THE GRADING PLAN SHALL BE PERFORMED PRIOR TO GRADING, CLEARING OR GRUBBING. ALL EROSION CONTROL DEVICES SUCH AS SILT FENCES, ETC., SHALL BE MAINTAINED IN WORKABLE CONDITION FOR THE LIFE OF THE PROJECT AND SHALL BE REMOVED AT THE COMPLETION OF THE PROJECT ONLY ON THE ENGINEER'S APPROVAL. PAYMENT SHALL BE CONSIDERED INCIDENTAL TO WORK ITEMS LISTED IN BID SCHEDULE AND BID PRICES PROVIDED. LUMP SUM BID PRICE. IF DURING THE LIFE OF THE PROJECT, A STORM CAUSES SOIL EROSION WHICH CHANGES FINISH GRADES OR CREATES "GULLIES" AND "WASHED AREAS", THESE SHALL BE REPAIRED AT NO EXTRA COST, AND ALL SILT WASHED OFF OF THE PROJECT SITE ONTO ADJACENT PROPERTY SHALL BE REMOVED AS DIRECTED BY THE ENGINEER AT NO EXTRA COST. THE CONTRACTOR SHALL ADHERE TO ANY APPROVED EROSION CONTROL PLANS WHETHER INDICATED IN THE CONSTRUCTION PLANS OR UNDER SEPARATE COVER.
- DISPOSABLE MATERIAL
  - CLEARING AND GRUBBING WASTES SHALL BE REMOVED FROM THE SITE AND PROPERLY DISPOSED OF BY THE CONTRACTOR AT HIS EXPENSE, UNLESS SPECIFIED OTHERWISE.
  - SOLID WASTES TO BE REMOVED, SUCH AS SIDEWALKS, CURBS, PAVEMENT, ETC., MAY BE PLACED IN SPECIFIC DISPOSAL AREAS ONLY WHEN DELINEATED ON THE PLANS OR OTHERWISE REMOVED FROM THE SITE AS REQUIRED BY THE SPECIFICATIONS. THE CONTRACTOR SHALL MAINTAIN SPECIFIED COMPACTION REQUIREMENTS IN THESE AREAS, WHEN DISPOSAL SITES ARE NOT PROVIDED, THE CONTRACTOR SHALL REMOVE THIS WASTE FROM THE SITE AND PROPERLY DISPOSE OF IT AT HIS EXPENSE.
  - ABANDONED UTILITIES SUCH AS CULVERTS, WATER PIPE, HYDRANTS, CASTINGS, PIPE APPURTENANCES, UTILITY POLES, ETC., SHALL BE THE PROPERTY OF THE SPECIFIC UTILITY AGENCY, OR COMPANY HAVING JURISDICTION. BEFORE THE CONTRACTOR CAN REMOVE, DESTROY, SALVAGE, REUSE, SELL OR STORE FOR HIS OWN USE ANY ABANDONED UTILITY, HE MUST PRESENT TO THE OWNER WRITTEN PERMISSION FROM THE UTILITY INVOLVED.
- IN THE EVENT EXCESSIVE GROUNDWATER OR SPRINGS ARE ENCOUNTERED WITHIN THE LIMITS OF CONSTRUCTION, THE CONTRACTOR SHALL INSTALL NECESSARY UNDER DRAINS AND STONE AS DIRECTED BY THE ENGINEER.
- THE CONTRACTOR IS RESPONSIBLE FOR THE COORDINATION OF ADJUSTMENT OF ALL UTILITY SURFACE ACCESSES WHETHER HE PERFORMS THE WORK OR A UTILITY COMPANY PERFORMS THE WORK.
- THE CONTRACTOR SHALL CONTROL ALL "DUST" BY PERIODIC WATERING AND SHALL PROVIDE ACCESS AT ALL TIMES FOR PROPERTY OWNERS WITHIN THE PROJECT AREA AND FOR EMERGENCY VEHICLES. ALL OPEN DITCHES AND HAZARDOUS AREAS SHALL BE CLEARLY MARKED IN ACCORDANCE WITH THE SPECIFICATIONS.
- ALL AREAS WHERE THERE IS EXPOSED DIRT SHALL BE SEEDED, FERTILIZED AND MULCHED ACCORDING TO THE SPECIFICATIONS. THE FINISHED SURFACE SHALL BE TO GRADE AND SMOOTH, FREE OF ALL ROCKS LARGER THAN 3", EQUIPMENT TRACKS, DIRT CLODS, BUMPS, RIDGES AND GOUGES PRIOR TO SEEDING; THE SURFACE SHALL BE LOOSENEED TO A DEPTH OF 4"-6" TO ACCEPT SEED. THE CONTRACTOR SHALL NOT PROCEED WITH SEEDING OPERATIONS WITHOUT FIRST OBTAINING THE ENGINEER'S APPROVAL OF THE GRADED SURFACE. ALL SEEDING SHALL BE PERFORMED BY A MECHANICAL "HYDRO-SEEDER". HAND SEEDING SHALL BE AUTHORIZED ON AN AREA BY AREA APPROVAL BY THE ENGINEER. DISTURBED AREAS SHOULD THEN BE MATTED WITH SHORT-TERM PHOTODEGRADABLE EROSION CONTROL MATTING AS SHOWN ON THE PLANS OR IF REQUIRED TO ESTABLISH VEGETATION.
- WHERE SPECIFIED, RCP STORM DRAIN PIPE SHALL BE REINFORCED CONCRETE PIPE (RCP) CONFORMING TO AASHTO M-170, AS CONTAINED IN NCDOT STANDARD SPECIFICATION 1032-9 FOR WALL "B" TYPE.
 

WHERE SPECIFIED, HDPE STORM DRAIN PIPE SHALL BE HIGH DENSITY POLYETHYLENE (HDPE), SMOOTH WALL INTERIOR, WITH WATER TIGHT JOINTS, BACKFILLED WITH # 57 WASHED STONE UP TO MIN. 6" OVER THE TOP OF THE PIPE. HDPE PIPE SHALL BE "HANCOR BLUE SEAL" OR APPROVED EQUAL.

WHERE SPECIFIED, CORRUGATED METAL STORM DRAIN PIPE (CMP) SHALL BE ALUMINIZED TYPE 2 CORRUGATED STEEL MANUFACTURED IN ACCORDANCE WITH THE REQUIREMENTS OF AASHTO M-36. THE PIPE SHALL BE MANUFACTURED FROM ALUMINIZED STEEL TYPE 2 MATERIAL CONFORMING TO THE REQUIREMENTS OF AASHTO M-274. ALL PIPE SHALL BE FURNISHED WITH REROLLED ENDS AND SHALL BE JOINED WITH HUGGER BANDS. THE USE OF DIMPLE BANDS WILL NOT BE ALLOWED. PIPE THROUGH 24" DIAMETER SHALL BE 16 GAUGE, PIPE THROUGH 42" DIAMETER SHALL BE 14 GAUGE, PIPE THROUGH 54" DIAMETER SHALL BE 12 GAUGE.
- CONTRACTOR SHALL VERIFY ALL ELEVATIONS BEFORE INSTALLATION OF FACILITIES.
- CATCH BASIN CAST-IN-PLACE SHALL CONFORM TO THE REQUIREMENTS OF NCDOT STANDARD SPECIFICATIONS FOR ROADS AND STRUCTURES (LATEST EDITION) ARTICLES 840-1 THROUGH 840-3. CURB INLET CATCH BASIN SHALL CONFORM TO NCDOT STANDARD DETAILS 840.02 THROUGH 840.04. DROP INLETS SHALL CONFORM TO STANDARD DETAIL 840.14. JUNCTION BOXES SHALL CONFORM TO STANDARD DETAIL 840.31.
- CURB INLET FRAME, GRATE AND HOOD SHALL BE NEENAH R-3233D, PRODUCTS BY DEWEY BROS., U.S. FOUNDRY OR EQUAL. DROP INLET FRAME AND GRATE SHALL BE NEENAH R-3339A OR EQUAL. FIELD INLET COVER SHALL CONFORM TO NCDOT STANDARD DETAIL 840.04, OPENING FACING UPSTREAM.
- CONCRETE AND MASONRY FOR SITE WORK ELEMENTS SHALL MEET THE REQUIREMENTS OF APPROPRIATE SECTION OF NCDOT STANDARD SPECIFICATIONS FOR ROAD AND STRUCTURES (LATEST EDITION). CONCRETE SHALL BE CLASS A OR B, 4000 PSI MINIMUM, MEETING THE REQUIREMENTS OF SECTION 1000. CONSTRUCTED IN ACCORDANCE WITH SECTION 825. MASONRY SHALL MEET THE REQUIREMENTS OF SECTION 1040, CONSTRUCTED IN ACCORDANCE WITH SECTION 830 AND/OR 834.
- TOPS OF PROPOSED FRAMES AND GRATES SHALL BE FLUSH WITH FINISHED GRADE.
- PRE-CAST CONCRETE BOXES ARE ACCEPTABLE ALTERNATIVES FOR PROPOSED CATCH BASINS.

**NORTH CAROLINA LAND QUALITY SECTION**

**EROSION CONTROL NOTES**

REVISION DATE - NOVEMBER 24, 2008

GENERAL: ALL EROSION CONTROL MEASURES ARE TO BE PERFORMED IN STRICT ACCORDANCE WITH REQUIREMENTS OF THE NORTH CAROLINA DEPARTMENT OF ENVIRONMENT AND NATURAL RESOURCES, DIVISION OF LAND RESOURCES, LAND QUALITY SECTION. THE FOLLOWING CONSTRUCTION SEQUENCE SHALL BE COMPLIED WITH FOR ALL WORK.

- THE GRADING WORK ASSOCIATED WITH THE CAP REPAIR OF THE FRANCIS FARM LANDFILL IS COVERED UNDER THE REQUIREMENTS OF THE NORTH CAROLINA DEPARTMENT OF ENVIRONMENT AND NATURAL RESOURCES, SOLID WASTE SECTION. THE SOURCE OF BORROW MATERIALS FOR THE PROJECT MUST HAVE THE APPROPRIATE EROSION CONTROL PERMITS IN PLACE. IF THE CONTRACTOR CHOOSES TO UTILIZE SOILS FROM THE HAYWOOD COUNTY WHITE OAK LANDFILL, EXISTING EROSION CONTROL PERMITS ARE IN PLACE AND WILL BE PROVIDED TO THE CONTRACTOR.
- INSTALL ALL EROSION CONTROL MEASURES AS REQUIRED BY THE PLANS AND THE NORTH CAROLINA DEPARTMENT OF ENVIRONMENT AND NATURAL RESOURCES, DIVISION OF LAND RESOURCES, LAND QUALITY SECTION.
- NO WORK SHALL BE PERFORMED IN STREAM FROM OCTOBER 15 TO APRIL 15 (TO ACCOMMODATE COE AND DWQ RECOMMENDATIONS CONCERNING WORK IN TROUT WATERS).
- CONTRACTOR IS TO PLACE PERMANENT STAKES MARKING CLEARLY THE 25' BUFFER FOR STREAMS WHERE SHOWN ON THE PLANS AND THE MARKERS ARE TO BE VISIBLE AT ALL TIMES DURING CONSTRUCTION.
- CONSTRUCTION SHALL BE LIMITED TO 2000' OF CONTIGUOUS ROAD CORRIDOR UNTIL ALL CUTS, FILLS, AND DITCHES ARE STABILIZED FOR THAT 2000' SECTION. UPON STABILIZATION OF THAT SECTION ANOTHER 2000' SECTION CAN BE CONSTRUCTED AND STABILIZED.
- PROCEED WITH GRADING, CLEARING AND GRUBBING. NOTE: NO OFF SITE DISPOSAL OF MATERIAL IS ALLOWED UNLESS THE DISPOSAL SITE HAS AN APPROVED EROSION CONTROL PLAN.
- SEED AND PLACE EROSION CONTROL MATTING ON ALL CUT AND FILL SLOPES THAT ARE NOT ROCK IMMEDIATELY UPON COMPLETION OF SLOPE STABILIZATION.
- ALL TEMPORARY STREAM AND CREEK CROSSINGS FOR EQUIPMENT DURING CONSTRUCTION SHALL BE MADE USING TEMPORARY BRIDGES. NO STREAM BANK OR STREAM BED DISTURBANCE SHALL BE ALLOWED FOR EQUIPMENT CROSSINGS.
- SEED AND MULCH DENUDED AREA WITHIN 15 DAYS AFTER FINISHED GRADE IS ESTABLISHED. SEED AND SOIL AMENDMENTS SHALL BE PLACED ON A PREPARED SEEDBED AT THE FOLLOWING RATES PER ACRE. STRAW MULCH SHALL BE TACKED WITH TACKING AGENT APPLIED BY HYDROSEEDER.

LIME	4,000 LBS
FERTILIZER (10-10-10)	1,000 LBS
KY-31 FESCUE	100 LBS
STRAW MULCH	60-80 BALES

FOR SUMMER SEEDING ADD TO THE ABOVE:	
GERMAN MILLET	40 LBS
SMALL-STEMMED SUDAN GRASS	50 LBS

FOR WINTER SEEDING ADD TO THE ABOVE:	
RYE GRASS	120 LBS

IF HYDROSEEDING, WOOD CELLULOSE MAY BE USED IN ADDITION TO STRAW MULCH AT THE RATE OF 1,000 LBS PER ACRE.

ALL SEEDING SHALL BE MAINTAINED, WATERED ETC., UNTIL A PERMANENT VEGETATIVE GROUND COVER IS ESTABLISHED OVER ALL DISTURBED AREAS.

FOR ALL SLOPES 2:1 OR STEEPER ADD TO THE ABOVE:

PURE LIVE SEED SWITCHGRASS	4 LBS
BROWTOP MILLET	8 LBS
GRAIN SORGHUM	2 LBS

ALL SLOPES 3:1 OR STEEPER SHALL BE COVERED BY EROSION CONTROL MATTING.

**NATIVE SEEDING:**

THE CORRECT SEEDBED pH IS 5.5 TO 6.5.

APPLY ZERO NITROGEN AT PLANTING.

INCORPORATE SOIL AMENDMENTS INTO TOPSOIL/ROOT ZONE BEFORE SEEDING.

FIRM SEEDBED BEFORE SEEDING (TRAVEL WITH DOZER CLEATS).

SEEDING DEPTH FOR ALL NATIVE SSP. (EXCEPT E.GAMAGRASS) NEED TO BE 1/4" - 1/2". GREATER DEPTHS CAUSE HIGH SEED MORTALITY.

SPECIALIZED SEEDING IMPLEMENTS ARE REQUIRED. SEED MIXES AND RATES TO MATCH SEEDER USED. A NO-TILL DROP SEEDER OR BROADCASTER WITH PRECISION METERING TO CONTROL SMALL SEED FLOW AND PICKER WHEEL AGITATORS TO HANDLE FLUFFY SEED ARE BEST SUITED FOR NATIVE SEED.

**NATIVE PLANT SEEDING MIX FOR STREAM OR RIVERBANK STABILIZATION**

SEEDING FOR STREAM OR RIVERBANK STABILIZATION SHALL BE A MIXTURE OF NATIVE GRASSES, PLANTS AND TREES. NATIVE PLANT MIX SHALL INCLUDE THE FOLLOWING:

GRASSES - BIG BLUESTEM, INDIAN GRASS, LITTLE BLUESTEM, SWITCHGRASS	5 LBS/ACRE EACH
AUGUST THRU MAY - GREENRYE	25 LBS/ACRE EACH
MAY 1 THRU AUGUST - MILLET	25 LBS/ACRE EACH

TREES - SILKY DOGWOOD (CORNUS AMONUM), SILKY WILLOW (SALIX SERICEA), HAZEL ALDER (ALNUS SERRULATA) AND ELDERBERRY (SAMBUEUS CANADENSIS)

NATIVE PLANT MIX VARIATIONS SHALL BE APPROVED BY ENGINEER.

NOTE: NO FERTILIZER SHALL BE USED WITHIN 10' OF TOP OF STREAM OR RIVER BANK.

- MAINTAIN SOIL EROSION CONTROL MEASURES UNTIL PERMANENT GROUND COVER IS ESTABLISHED.
- REMOVE SOIL EROSION CONTROL MEASURES AND STABILIZE THESE AREAS.

**EXISTING CONDITIONS LEGEND**

TEL PED	TELEPHONE PEDESTAL	△	CALCULATED POINT
ELEC PED	ELECTRIC PEDESTAL	○	1/2" REBAR SET WITH CAP CONCRETE MONUMENT
CATV PED	CABLE TV PEDESTAL	□	RIGHT-OF-WAY MONUMENT
	SIGN	■	D.O.T. CONTROL POINT
	UNDERGROUND CABLE TV SIGN	●	REBAR FOUND
	UNDERGROUND FIBER OPTIC CABLE SIGN	○	PK NAIL FOUND / SET
	UNDERGROUND TELEPHONE CABLE SIGN	○	SPINDLE FOUND / SET
	UNDERGROUND GAS LINE SIGN	○	HUB & TACK SET
	UNDERGROUND ELECTRIC LINE SIGN	○	CONTROL POINT NAIL SET / FOUND
	LIGHT POLE	○	CONTROL POINT/NAIL SET GPS
	UTILITY POLE	○	CONTROL POINT TEMPORARY MARK
	GUY WIRE ANCHOR	○	STAKE FOUND
	MANHOLE	○	INTERSTATE HIGHWAY
	SANITARY SEWER MANHOLE	○	U.S. HIGHWAY
	STORM DRAIN MANHOLE	○	FINISHED FLOOR ELEVATION
	COMMUNICATION MANHOLE	○	MONITORING WELL
	ELECTRICAL MANHOLE	○	PIEZOMETER
	JUNCTION BOX	○	LANDFILL GAS MONITORING PROBE
	SPIGOT/YARD HYDRANT	○	SURFACE WATER SAMPLING LOCATION
	SEWER CLEAN-OUT	○	LANDFILL GAS VENT
	ELECTRIC SERVICE STUB-OUT	○	LANDFILL GAS COLLECTION WELLHEAD
	GAS SERVICE STUB-OUT	○	POTABLE WATER WELL
	CATCH BASIN	○	MAILBOX OR PAPER BOX
	CURB INLET	○	POSTAL DROP BOX
	WATER METER	○	SATELLITE DISH
	FIRE HYDRANT	○	STATUE, BIRD BATHS, ETC.
	WATER VALVE	○	TREES
	BLOW OFF VALVE	○	SHURBS / BUSHES
	GAS METER	○	
	GAS VALVE	○	
	IRRIGATION CONTROL VALVE	○	
	POST INDICATOR VALVE	○	
	ELECTRIC JUNCTION BOX OR OUTLET	○	

=====	CULVERT
=====	FENCE
=====	SILT FENCE
=====	GUARD RAIL
=====	APPROXIMATE LOCATION OF EXISTING SEWER LINES
=====	APPROXIMATE LOCATION OF EXISTING WATER LINES
=====	APPROXIMATE LOCATION OF EXISTING GAS LINES
=====	TOP & TOE LINES
=====	DITCH LINES
=====	APPROXIMATE LOCATION OF UNDERGROUND CABLE TV LINE
=====	APPROXIMATE LOCATION OF OVERHEAD CABLE TV LINE
=====	APPROXIMATE LOCATION OF UNDERGROUND FIBER OPTIC CABLE LINE
=====	APPROXIMATE LOCATION OF UNDERGROUND ELECTRIC LINE
=====	APPROXIMATE LOCATION OF OVERHEAD ELECTRIC LINE
=====	APPROXIMATE LOCATION OF UNDERGROUND TELEPHONE LINES
=====	APPROXIMATE LOCATION OF OVERHEAD TELEPHONE LINES
=====	RIGHT-OF-WAY
=====	TREELINE
=====	SHRUBLINE
=====	PROPERTY LINE NOT SURVEYED
=====	ROCKLINE
=====	STREAM LINE
=====	CENTERLINE ROADS
=====	CENTERLINE OTHER THAN ROADS
=====	SWAMPLINE/METLANDS

IPS	IRON PIN SET
RFB	REBAR FOUND
OTIPF	OPEN TOP IRON PIN FOUND
CTIPF	CRIMPED TOP IRON PIN FOUND
CMU	CONCRETE MASONRY UNIT
R/W	RIGHT OF WAY
CL	CENTERLINE
C	CURVE (SEE CURVE TABLE)
POB	POINT OF BEGINNING
CP	CALCULATED POINT
PB	PLAT BOOK
DB	DEED BOOK
L	LINE (SEE LINE TABLE)
BLDG	BUILDING
CIP	CAST IRON PIPE
CMP	CORRUGATED METAL PIPE
CONC	CONCRETE
CMU	CONCRETE MASONRY UNIT
OPP	CORRUGATED PLASTIC PIPE
DIP	DUCTILE IRON PIPE
E&T	ELECTRIC & TELEPHONE
FOC	FIBER OPTIC CABLE
GIP	GALVANIZED IRON PIPE
O/H	OVERHEAD
RCP	REINFORCED CONCRETE PIPE
U/G	UNDERGROUND
VCP	VITRIFIED CLAY PIPE
PVC	POLYVINYL CHLORIDE PIPE
FFE	FINISHED FLOOR ELEVATION
PG	PAGE
REF	REFERENCE
DOT	DEPARTMENT OF TRANSPORTATION
NGS	NATIONAL GEODETIC SURVEY
NCSF	NORTH CAROLINA STATE PLANE

**RECORD DRAWING**

This Drawing has been modified to reflect changes made during construction based upon information provided by the Contractor and construction observations made by the Owner's Authorized Representative.

By *[Signature]* Date *7/23/12*



**McGill Associates**  
ENGINEERING · PLANNING · FINANCE  
55 BROAD STREET, ASHEVILLE, NC 28801 PH: (828) 252-0575 FIRM LICENSE # C-0459

FRANCIS FARM LANDFILL  
LANDFILL GAS COLLECTION & COMBUSTION SYSTEM  
PHASES 1 - 3  
**HAYWOOD COUNTY**  
HAYWOOD COUNTY, NORTH CAROLINA



JOB NO.: 09.00721  
DATE: APRIL, 2012  
DESIGNED BY: WHS  
CADD BY: KS  
DESIGN REVIEW:  
CONST. REVIEW:  
FILE NAME:  
RD: 09.00721-05-001-Cover-Sheet.dwg

**GENERAL NOTES AND LEGENDS**

**SHEET G-002**

C:\2009\09\_00721\Design\Solid\Notes\Drawings\Record Drawings\RD\_09\_00721\_05\_001-Cover-Sheet.dwg 7/23/2012 1:28 PM KELLY



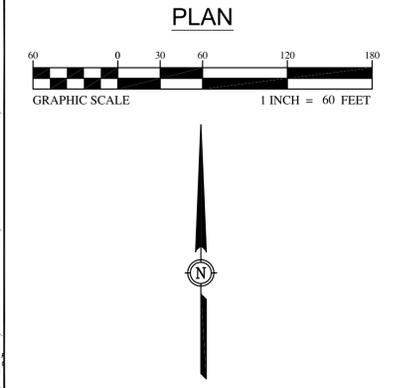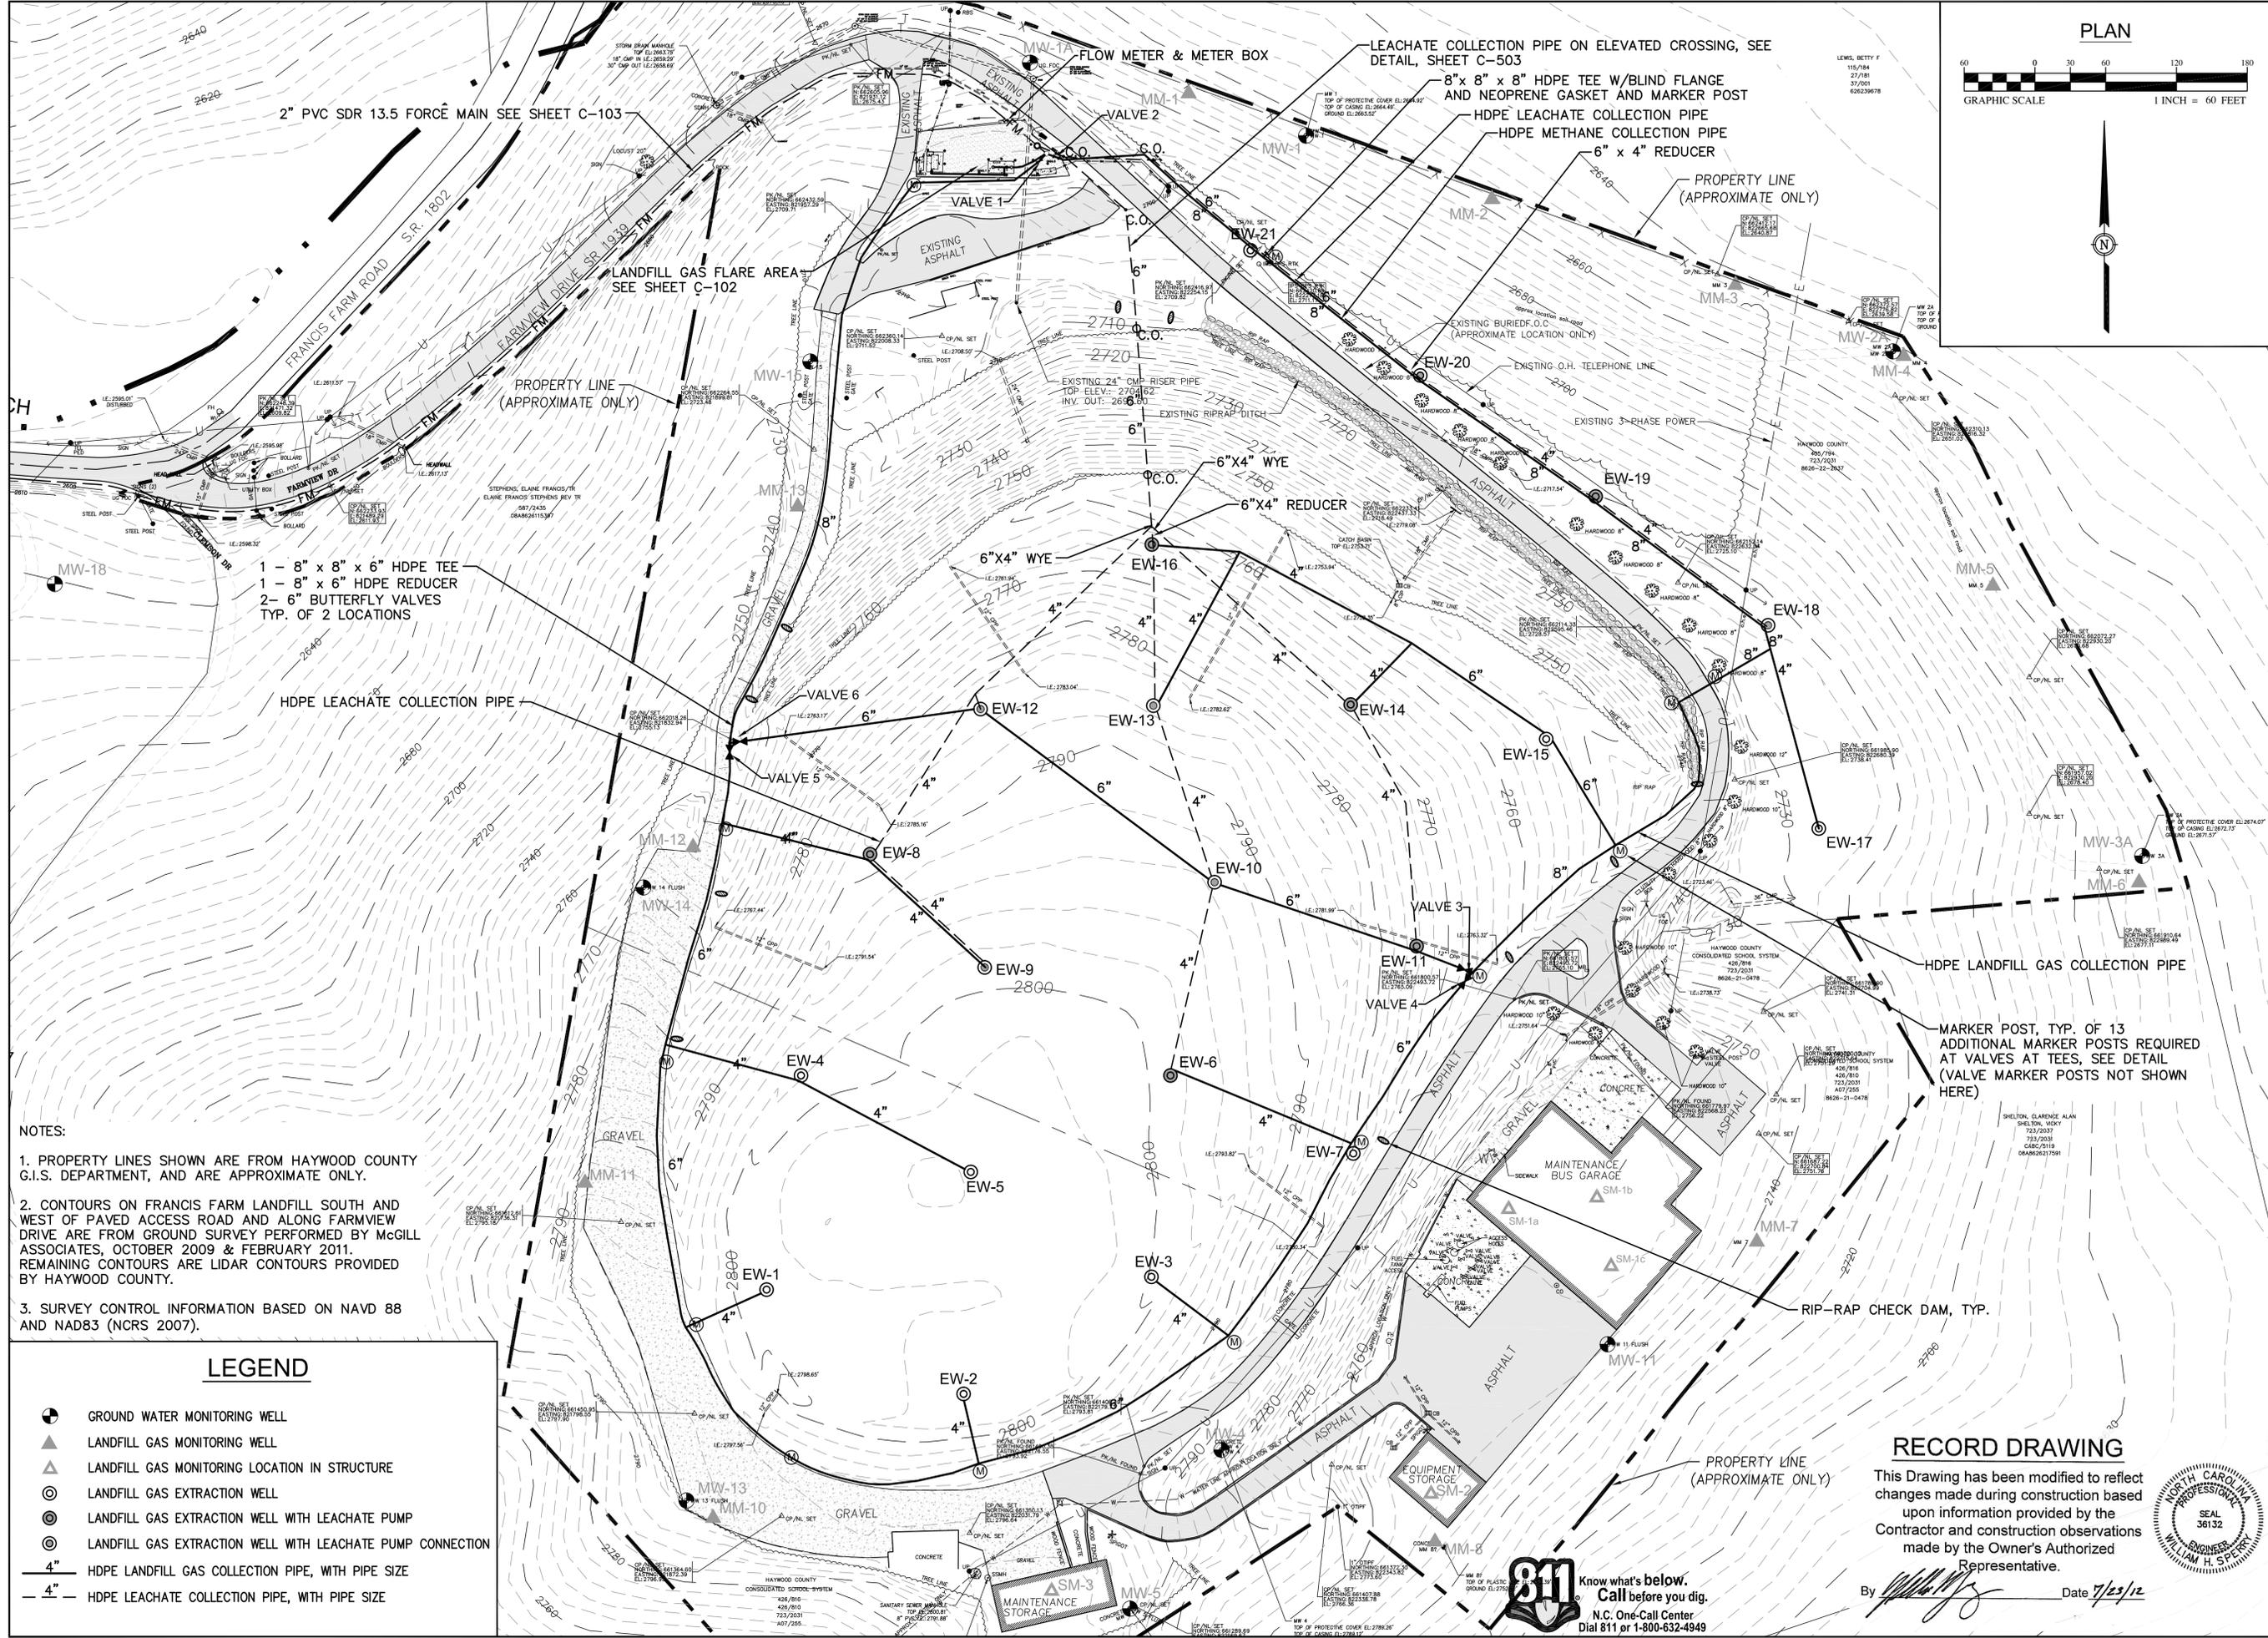

- 1 - 8" x 8" x 6" HDPE TEE
- 1 - 8" x 6" HDPE REDUCER
- 2 - 6" BUTTERFLY VALVES
- TYP. OF 2 LOCATIONS

- NOTES:
1. PROPERTY LINES SHOWN ARE FROM HAYWOOD COUNTY G.I.S. DEPARTMENT, AND ARE APPROXIMATE ONLY.
  2. CONTOURS ON FRANCIS FARM LANDFILL SOUTH AND WEST OF PAVED ACCESS ROAD AND ALONG FARMVIEW DRIVE ARE FROM GROUND SURVEY PERFORMED BY MCGILL ASSOCIATES, OCTOBER 2009 & FEBRUARY 2011. REMAINING CONTOURS ARE LIDAR CONTOURS PROVIDED BY HAYWOOD COUNTY.
  3. SURVEY CONTROL INFORMATION BASED ON NAVD 88 AND NAD83 (NCRS 2007).

**LEGEND**

- GROUND WATER MONITORING WELL
- LANDFILL GAS MONITORING WELL
- LANDFILL GAS MONITORING LOCATION IN STRUCTURE
- LANDFILL GAS EXTRACTION WELL
- LANDFILL GAS EXTRACTION WELL WITH LEACHATE PUMP
- LANDFILL GAS EXTRACTION WELL WITH LEACHATE PUMP CONNECTION
- 4" HDPE LANDFILL GAS COLLECTION PIPE, WITH PIPE SIZE
- 6" HDPE LEACHATE COLLECTION PIPE, WITH PIPE SIZE

**RECORD DRAWING**

This Drawing has been modified to reflect changes made during construction based upon information provided by the Contractor and construction observations made by the Owner's Authorized Representative.

By Date 7/23/12



**McGill ASSOCIATES**  
 ENGINEERING • PLANNING • FINANCE  
 55 BROAD STREET, ASHEVILLE, NC 28801 PH: (828) 252-6575 FAX: (828) 252-6576



FRANCIS FARM LANDFILL  
 LANDFILL GAS COLLECTION & COMBUSTION SYSTEM  
 PHASES 1-3  
**HAYWOOD COUNTY**  
 HAYWOOD COUNTY, NORTH CAROLINA

JOB NO.: 09-00721  
 DATE: APRIL, 2012  
 DESIGNED BY: WHS  
 CADD BY: KS  
 DESIGN REVIEW:  
 CONST. REVIEW:  
 FILE NAME:  
 E:\09-00721\09-00721-1014-Landfill Gas Collection System.dwg

LANDFILL GAS  
 COLLECTION SYSTEM

SHEET  
**C-101**



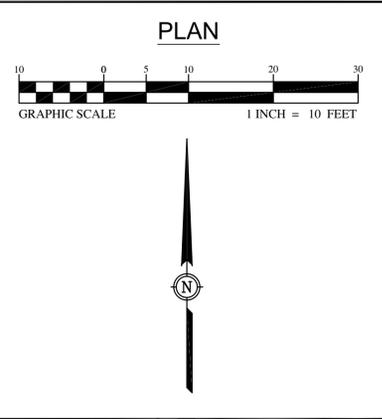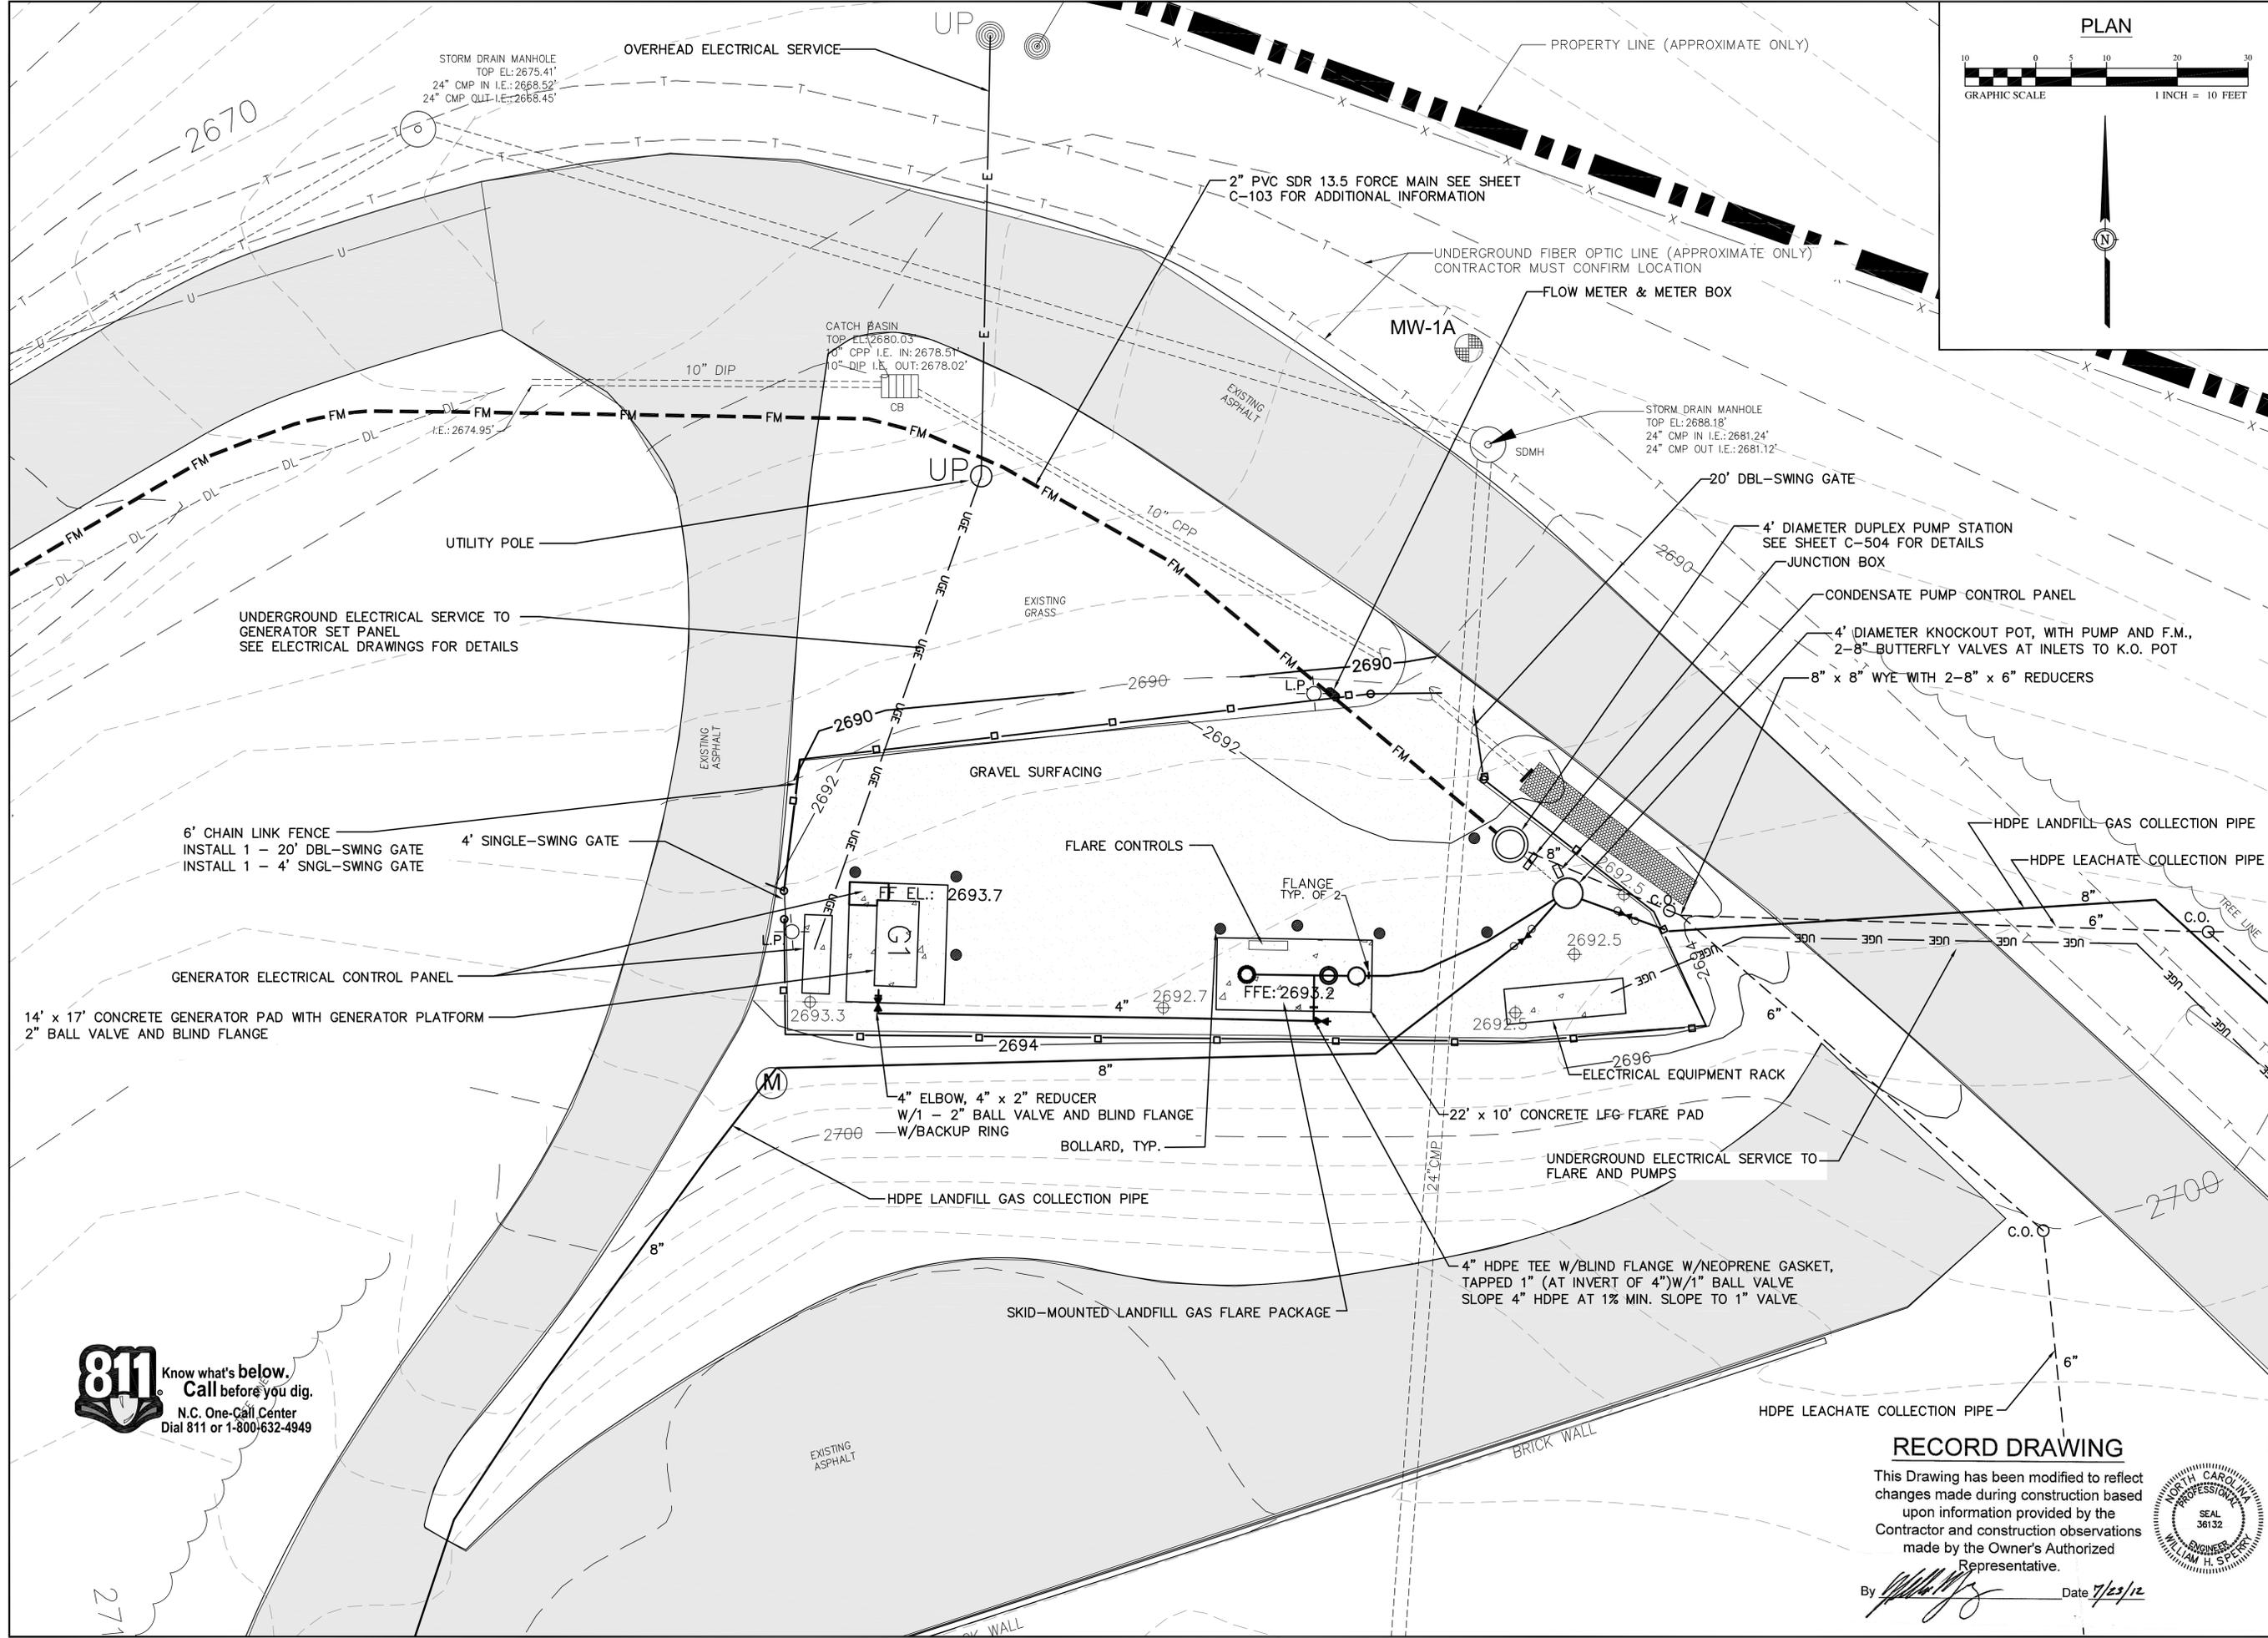

**McGill**  
 ASSOCIATES  
 ENGINEERING · PLANNING · FINANCE  
 55 BROAD STREET, ASHEVILLE, NC 28801 PH: (828) 252-0575 FIRM LICENSE # C0459

FRANCIS FARM LANDFILL  
 LANDFILL GAS COLLECTION & COMBUSTION SYSTEM  
 PHASES 1-3  
**HAYWOOD COUNTY**  
 HAYWOOD COUNTY, NORTH CAROLINA

JOB NO.: 09-00721  
 DATE: APRIL, 2011  
 DESIGNED BY: WHS  
 CADD BY: KS  
 DESIGN REVIEW:  
 CONST. REVIEW:  
 FILE NAME:  
 09-00721-C-102-Flare Area Site  
 Plan.dwg


FLARE AREA SITE PLAN  
 SHEET  
**C-102**

**811** Know what's below.  
 Call before you dig.  
 N.C. One-Call Center  
 Dial 811 or 1-800-632-4949

**RECORD DRAWING**  
 This Drawing has been modified to reflect changes made during construction based upon information provided by the Contractor and construction observations made by the Owner's Authorized Representative.  
 By *[Signature]* Date *7/23/12*



C:\2009\09\_00721\Design\Solid Waste\Drawings\Record Drawings\09-00721-C-102-Flare Area Site Plan.dwg 7/23/2012 11:45 AM KELLY

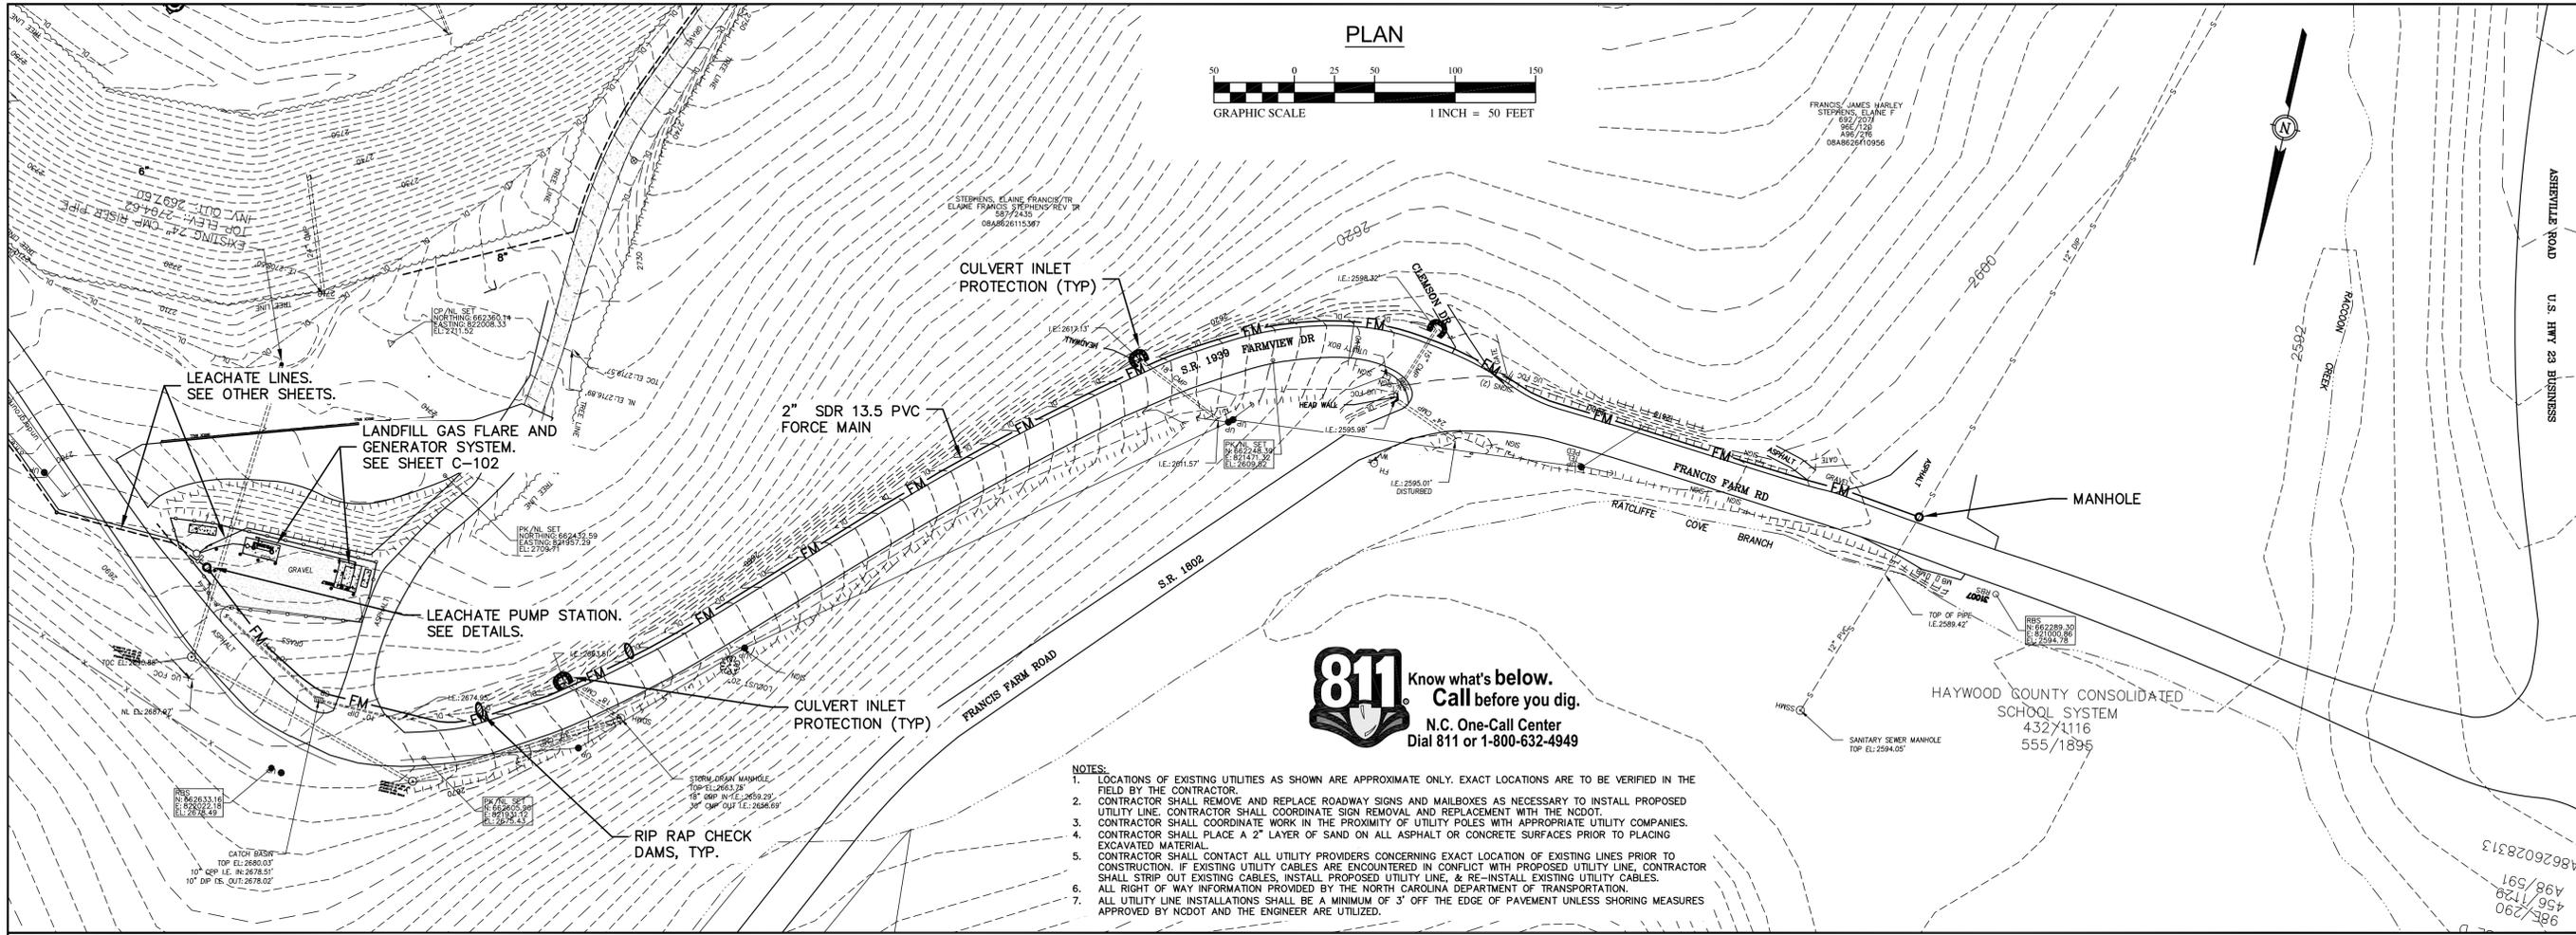


**811** Know what's below.  
Call before you dig.  
N.C. One-Call Center  
Dial 811 or 1-800-632-4949

- NOTES:**
1. LOCATIONS OF EXISTING UTILITIES AS SHOWN ARE APPROXIMATE ONLY. EXACT LOCATIONS ARE TO BE VERIFIED IN THE FIELD BY THE CONTRACTOR.
  2. CONTRACTOR SHALL REMOVE AND REPLACE ROADWAY SIGNS AND MAILBOXES AS NECESSARY TO INSTALL PROPOSED UTILITY LINE. CONTRACTOR SHALL COORDINATE SIGN REMOVAL AND REPLACEMENT WITH THE NCDOT.
  3. CONTRACTOR SHALL COORDINATE WORK IN THE PROXIMITY OF UTILITY POLES WITH APPROPRIATE UTILITY COMPANIES.
  4. CONTRACTOR SHALL PLACE A 2" LAYER OF SAND ON ALL ASPHALT OR CONCRETE SURFACES PRIOR TO PLACING EXCAVATED MATERIAL.
  5. CONTRACTOR SHALL CONTACT ALL UTILITY PROVIDERS CONCERNING EXACT LOCATION OF EXISTING LINES PRIOR TO CONSTRUCTION. IF EXISTING UTILITY CABLES ARE ENCOUNTERED IN CONFLICT WITH PROPOSED UTILITY LINE, CONTRACTOR SHALL STRIP OUT EXISTING CABLES, INSTALL PROPOSED UTILITY LINE, & RE-INSTALL EXISTING UTILITY CABLES.
  6. ALL RIGHT OF WAY INFORMATION PROVIDED BY THE NORTH CAROLINA DEPARTMENT OF TRANSPORTATION.
  7. ALL UTILITY LINE INSTALLATIONS SHALL BE A MINIMUM OF 3' OFF THE EDGE OF PAVEMENT UNLESS SHORING MEASURES APPROVED BY NCDOT AND THE ENGINEER ARE UTILIZED.

**PROFILE**

SCALE: HORIZ. 1"= 50'  
VERT. 1"= 5'

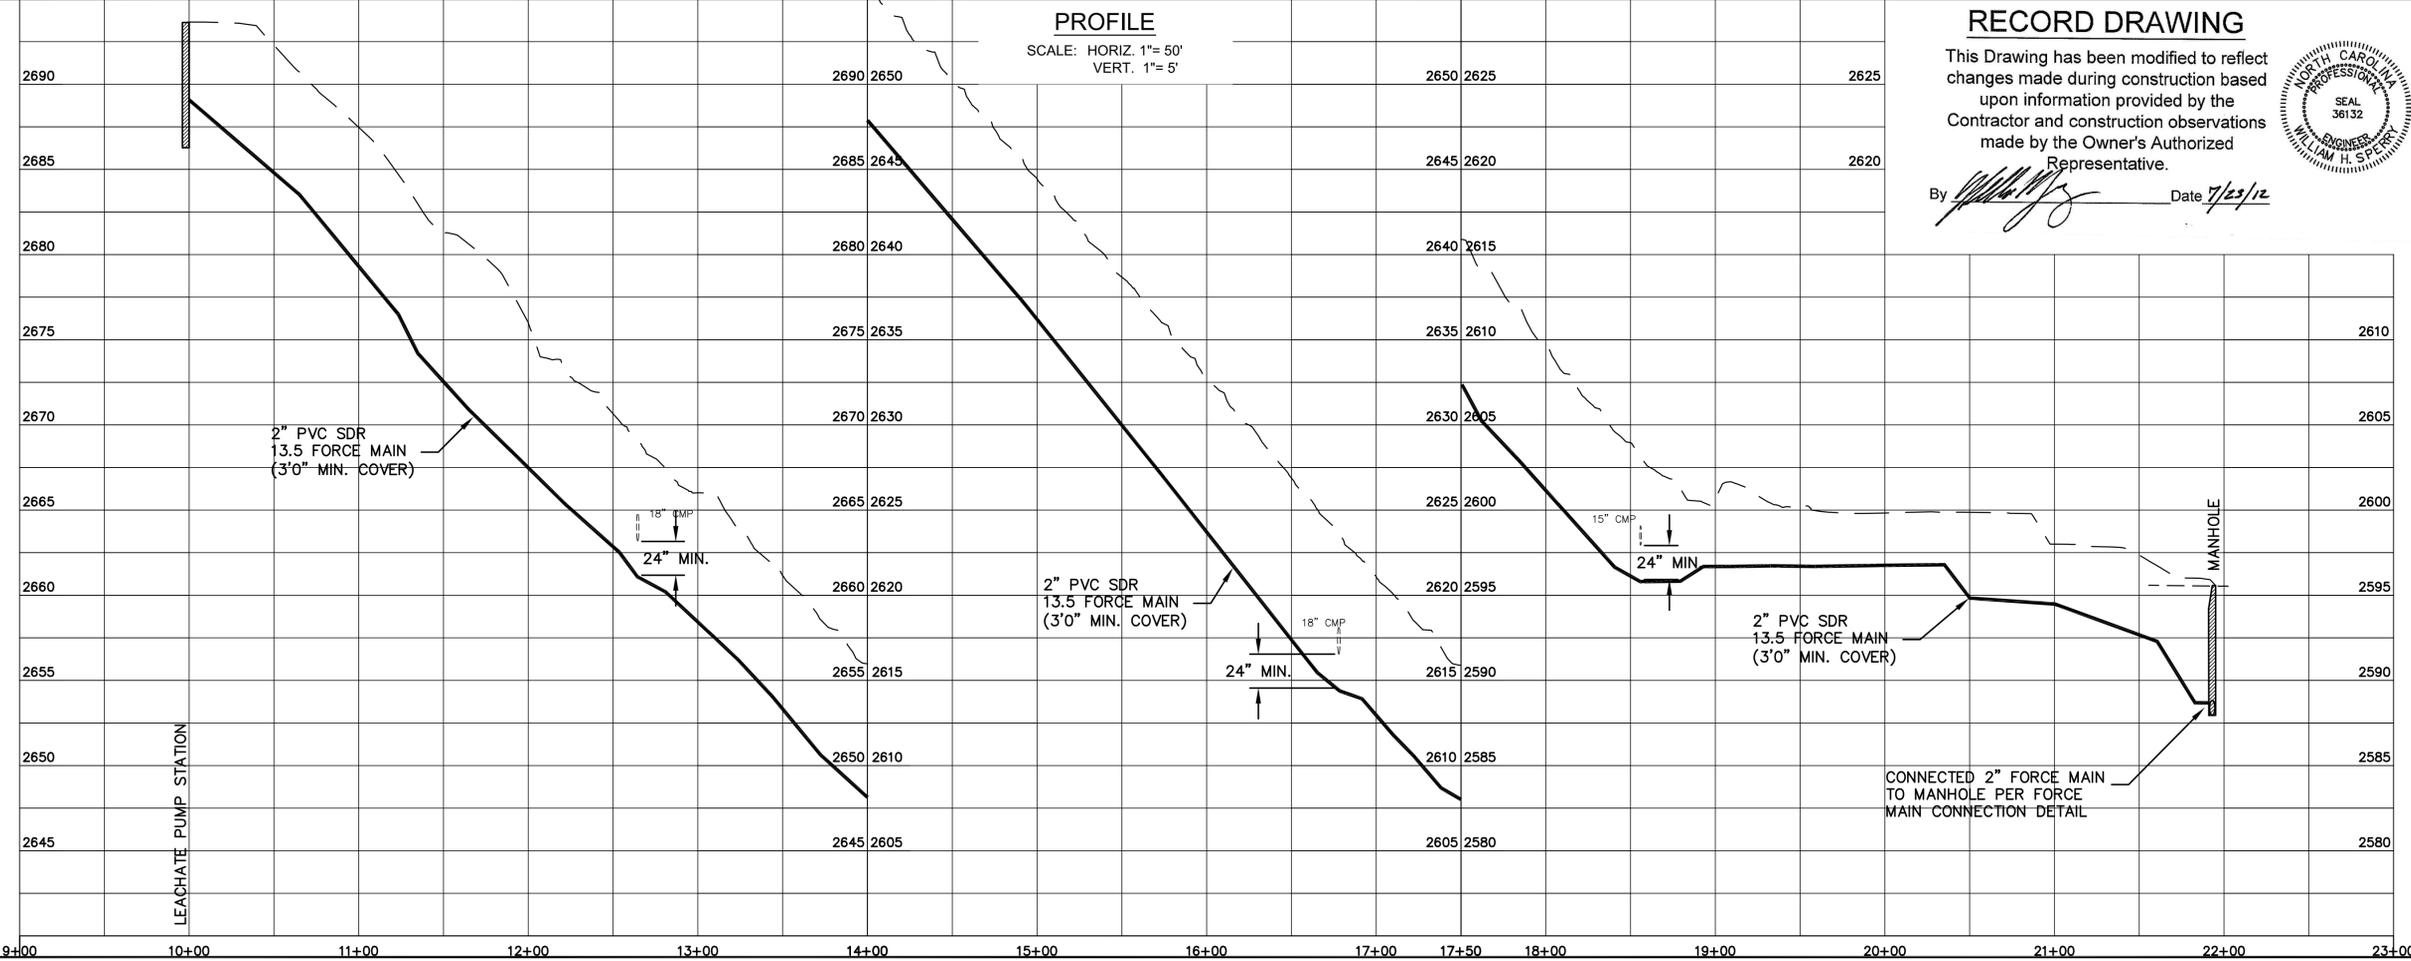


**RECORD DRAWING**

This Drawing has been modified to reflect changes made during construction based upon information provided by the Contractor and construction observations made by the Owner's Authorized Representative.

By *[Signature]* Date 7/23/12




C:\2009\09.00721\Design\Sheet\Waste\Drawings\Record\Drawings\RD-69.00721-C-103-Leachate Pump Station And Force Main.dwg 7/23/2012 11:58 AM KELLY

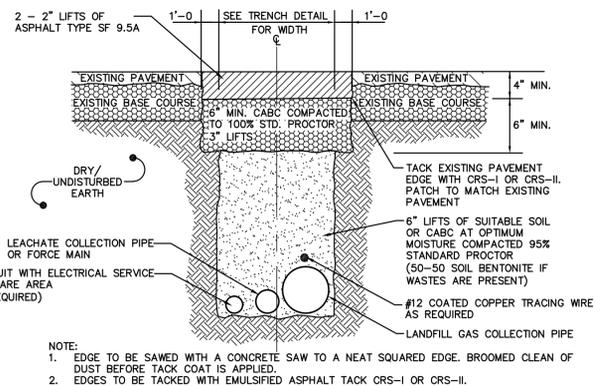

**ASPHALT DRIVE REPAIR**

NOT TO SCALE  
REVISION DATE - NOVEMBER 3, 2008


COMPACTED SOIL/BENTONITE MIXTURE, BENTONITE TO BE APPLIED AT THE RATE OF 1.5% BY WEIGHT" OR "COMPACTED SOIL/BENTONITE PLUG, BENTONITE TO BE APPLIED AT THE RATE OF 1.5% BY WEIGHT".

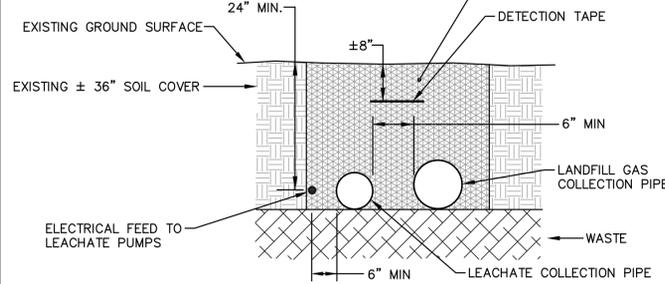

NOTES:  
1. CONSTRUCTION OF TRENCHES SHALL COMPLY WITH ALL FEDERAL, STATE AND LOCAL SAFETY AND HEALTH REGULATIONS WHICH HAVE JURISDICTION AT THE PROJECT SITE. IT IS THE CONTRACTOR'S RESPONSIBILITY TO BE FAMILIAR WITH THE APPLICABLE REGULATIONS AND FOLLOW THEM ACCORDINGLY.

**LANDFILL GAS COLLECTION PIPE / LEACHATE COLLECTION PIPE TRENCH DETAIL**


NOT TO SCALE

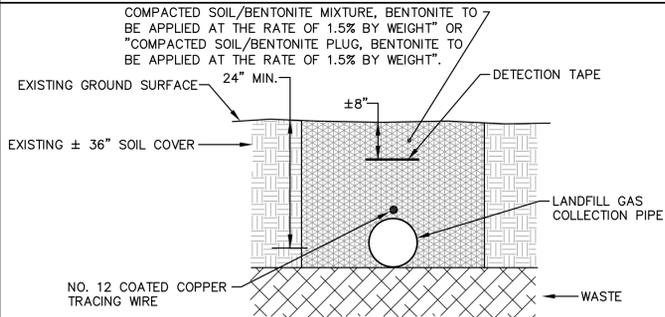

NOTES:  
1. CONSTRUCTION OF TRENCHES SHALL COMPLY WITH ALL FEDERAL, STATE AND LOCAL SAFETY AND HEALTH REGULATIONS WHICH HAVE JURISDICTION AT THE PROJECT SITE. IT IS THE CONTRACTOR'S RESPONSIBILITY TO BE FAMILIAR WITH THE APPLICABLE REGULATIONS AND FOLLOW THEM ACCORDINGLY.

**LANDFILL GAS COLLECTION PIPE TRENCH DETAIL**


NOT TO SCALE

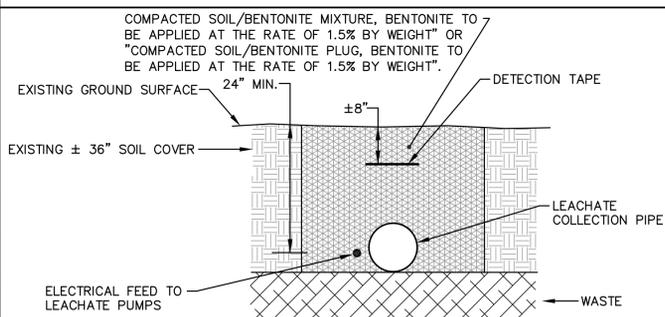

NOTES:  
1. CONSTRUCTION OF TRENCHES SHALL COMPLY WITH ALL FEDERAL, STATE AND LOCAL SAFETY AND HEALTH REGULATIONS WHICH HAVE JURISDICTION AT THE PROJECT SITE. IT IS THE CONTRACTOR'S RESPONSIBILITY TO BE FAMILIAR WITH THE APPLICABLE REGULATIONS AND FOLLOW THEM ACCORDINGLY.

**LEACHATE COLLECTION PIPE TRENCH DETAIL**


NOT TO SCALE

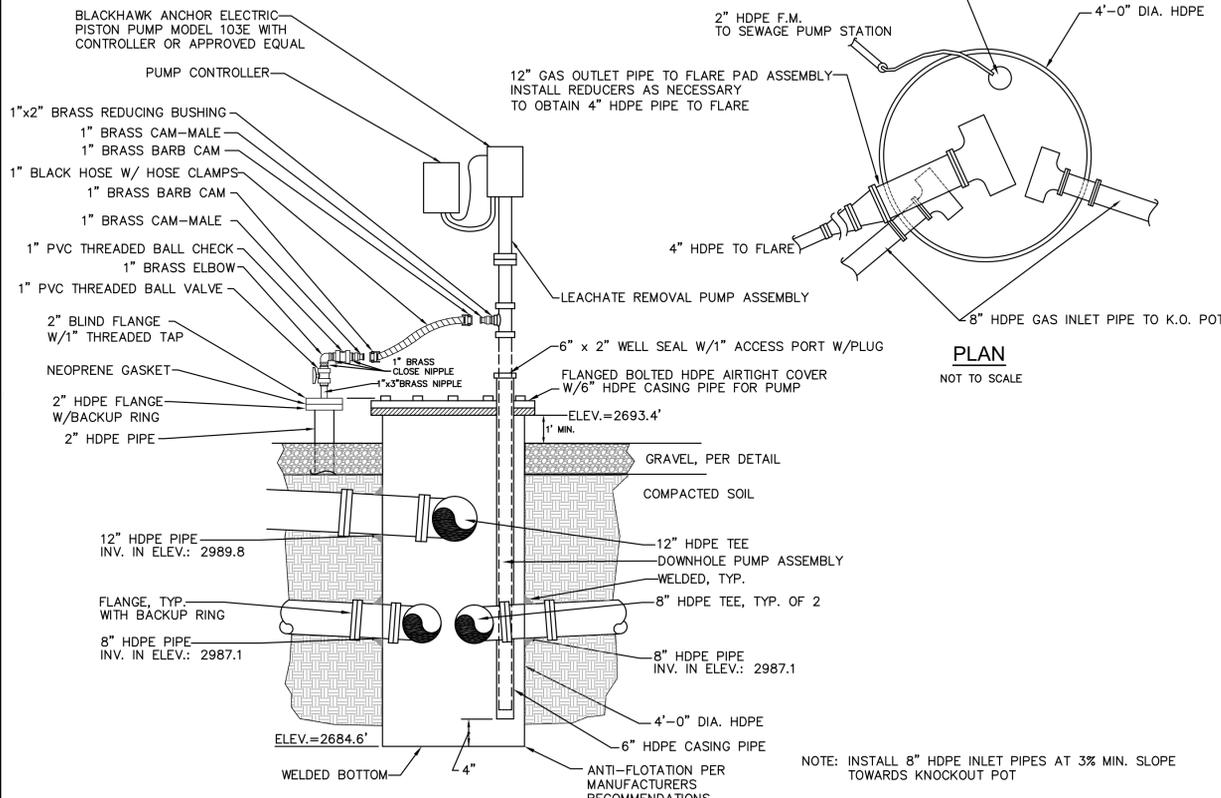


**PREFABRICATED HDPE KNOCKOUT POT**

NOT TO SCALE

NOTE: INSTALL 8" HDPE INLET PIPES AT 3% MIN. SLOPE TOWARDS KNOCKOUT POT  
NOTE: INSTALL 12" HDPE PIPE (AND REDUCED PIPING) AT 1.5% MIN. SLOPE TOWARDS KNOCKOUT POT  
NOTE: MAINTAIN 2' MIN. COVER OVER INLET AND OUTLET PIPING IN FLARE SITE AREA

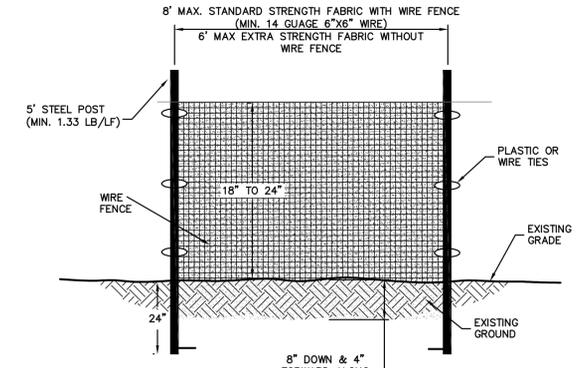

**SECTION VIEW**

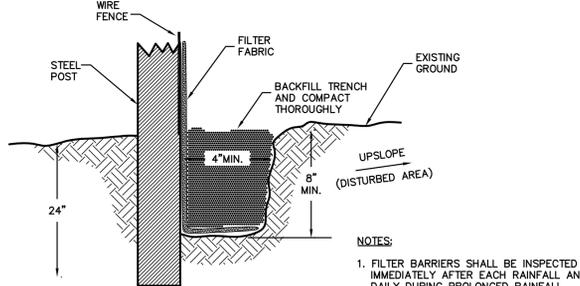


NOTES:  
1. FILTER BARRIERS SHALL BE INSPECTED IMMEDIATELY AFTER EACH RAINFALL AND DAILY DURING PROLONGED RAINFALL. REPAIR SHALL BE MADE AS NECESSARY.  
2. FABRIC SHALL BE REPLACED PROMPTLY IF FOUND TO BE IN DISREPAIR.  
3. SEDIMENT DEPOSITS SHALL BE REMOVED AFTER EACH STORM EVENT AND WHEN DEPOSITS REACH APPROXIMATELY 1/3 HEIGHT OF BARRIER.  
4. REFERENCE NCDENR LAND QUALITY SECTION DESIGN MANUAL: 6.62.

SLOPE	SLOPE LENGTH(FT)	MAXIMUM AREA(SQFT)
<2%	100	10,000
2 TO 5%	75	7,500
5 TO 10%	50	5,000
10 TO 20%	25	2,500
>20%	15	1,500


**SEDIMENTATION/SILT FENCE**

REVISION DATE - NOVEMBER 3, 2008

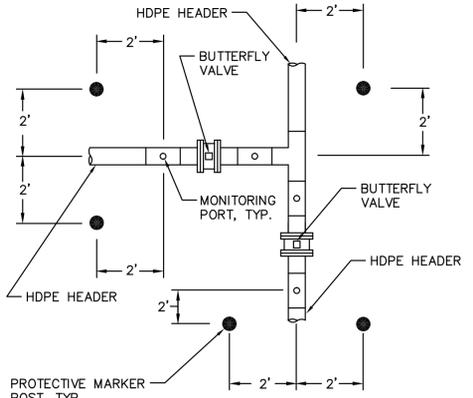


**PROTECTIVE MARKER POST LOCATION AT TYPICAL TEES**

NOT TO SCALE

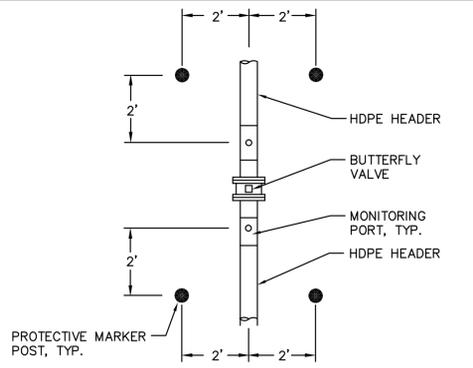

**PROTECTIVE MARKER POST LOCATION IN LINE**


NOT TO SCALE

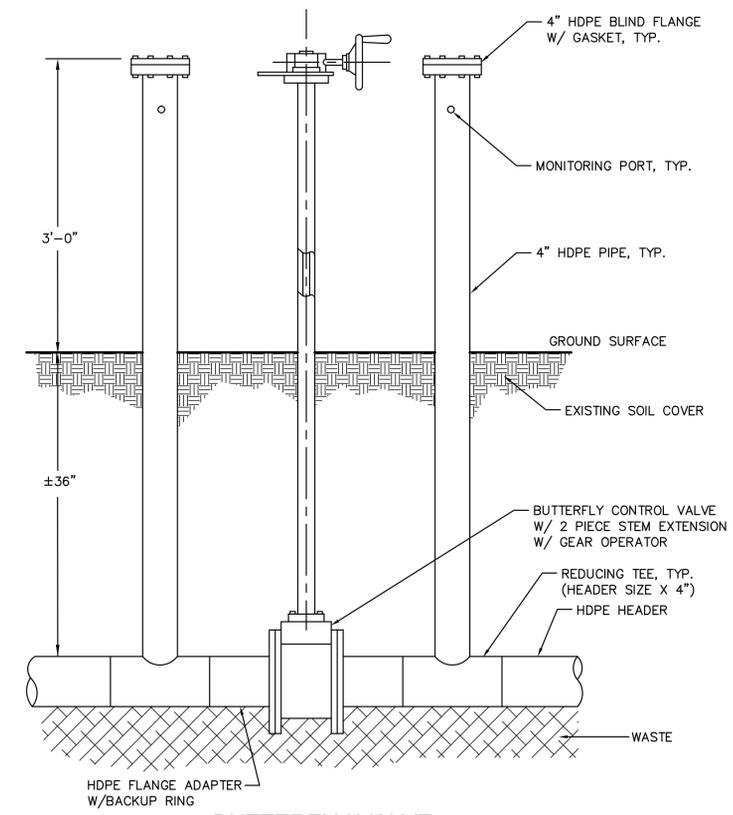

**BUTTERFLY VALVE**

**WITH 2-PIECE STEM EXTENSION AND MONITORING PORTS**

NOT TO SCALE

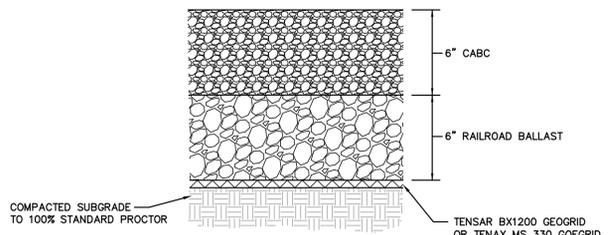

**GRAVEL SURFACING SECTION DETAIL**

NOT TO SCALE

**RECORD DRAWING**


This Drawing has been modified to reflect changes made during construction based upon information provided by the Contractor and construction observations made by the Owner's Authorized Representative.

By *[Signature]* Date *7/23/12*



C:\2009\09\_07\21\Design\Solid\Waste\Drawings\Record Drawings\RD\_09\_00721-C-501-Miscellaneous-Details.dwg 7/23/2012 1:20 PM KELLY

0:202008 007211\Design\Solid Waste\Drawings\Record Drawings\RD 09 00721-C-502-Miscellaneous Details.dwg 7/23/2012 1:20 PM KELLY

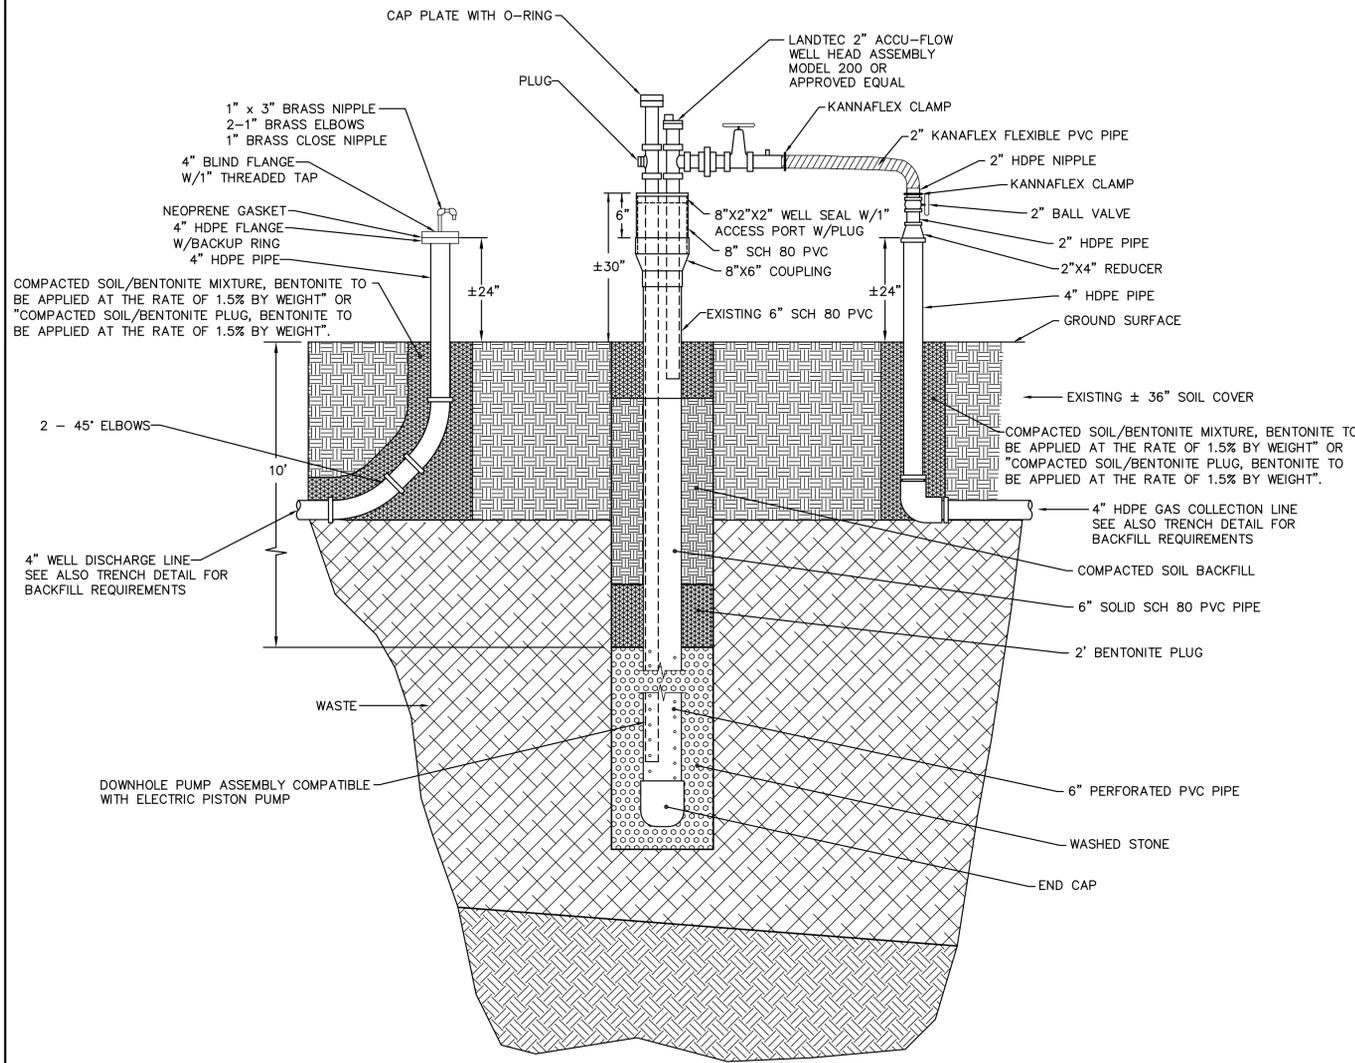


NOTE: SEE EXISTING EXTRACTION WELL INFORMATION ON SHEET C-503 TO DETERMINE DEPTHS OF DE-WATERING EQUIPMENT

**LANDFILL GAS EXTRACTION WELL W/ CONNECTION FOR FUTURE LEACHATE PUMP**

EW WELL NUMBERS: 9,10,12,13,18&20

NOT TO SCALE

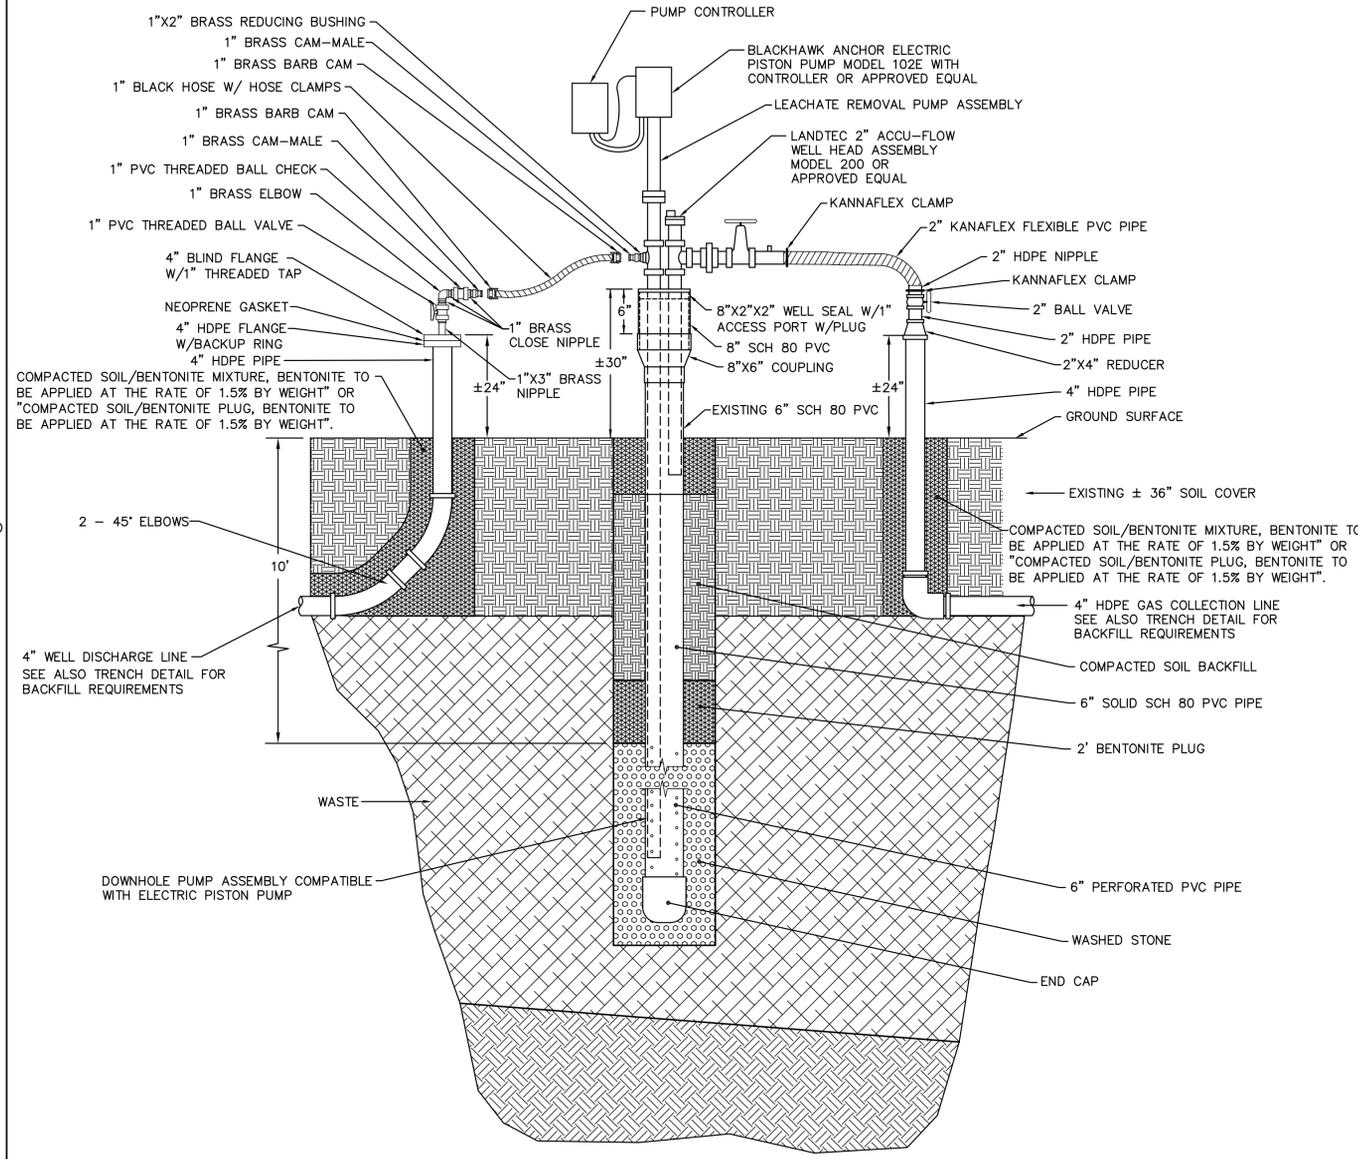


NOTE: SEE EXISTING EXTRACTION WELL INFORMATION ON SHEET C-503 TO DETERMINE DEPTHS OF DE-WATERING EQUIPMENT

**LANDFILL GAS EXTRACTION WELL W/ LEACHATE PUMP**


EW WELL NUMBERS: 6,8,11,14,16&19

NOT TO SCALE

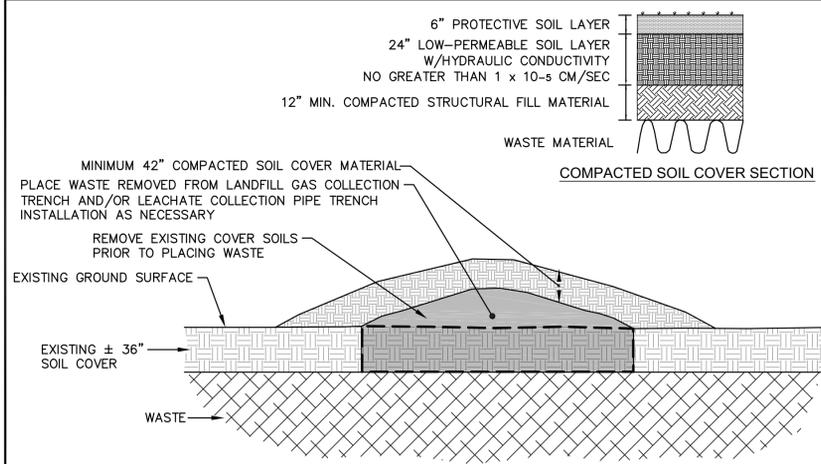


**CAP REPAIR AND WASTE FILL COVER DETAIL**

NOT TO SCALE

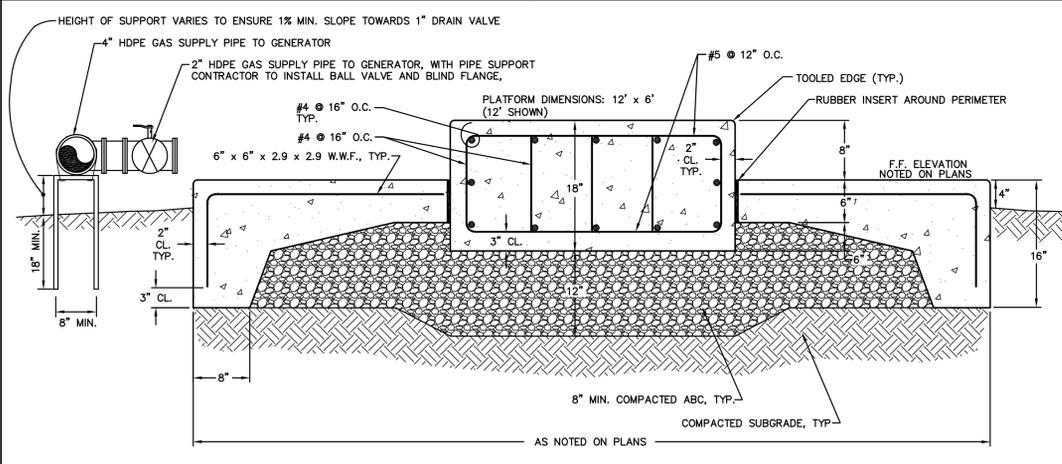

**GENERATOR PAD DETAIL**

NOT TO SCALE

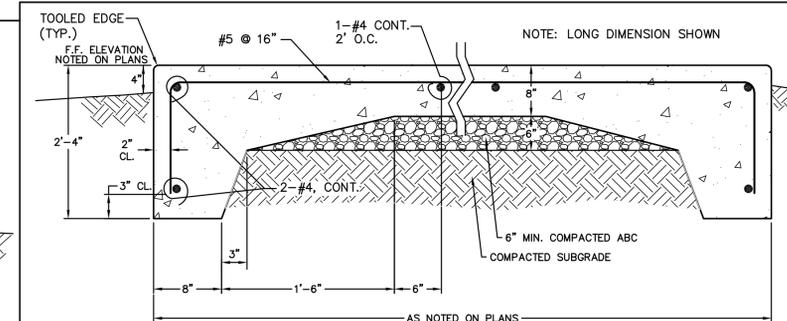







**CONCRETE LFG FLARE PAD DETAIL**

**RECORD DRAWING**

This Drawing has been modified to reflect changes made during construction based upon information provided by the Contractor and construction observations made by the Owner's Authorized Representative.

By *[Signature]* Date 7/23/12

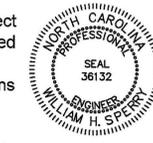

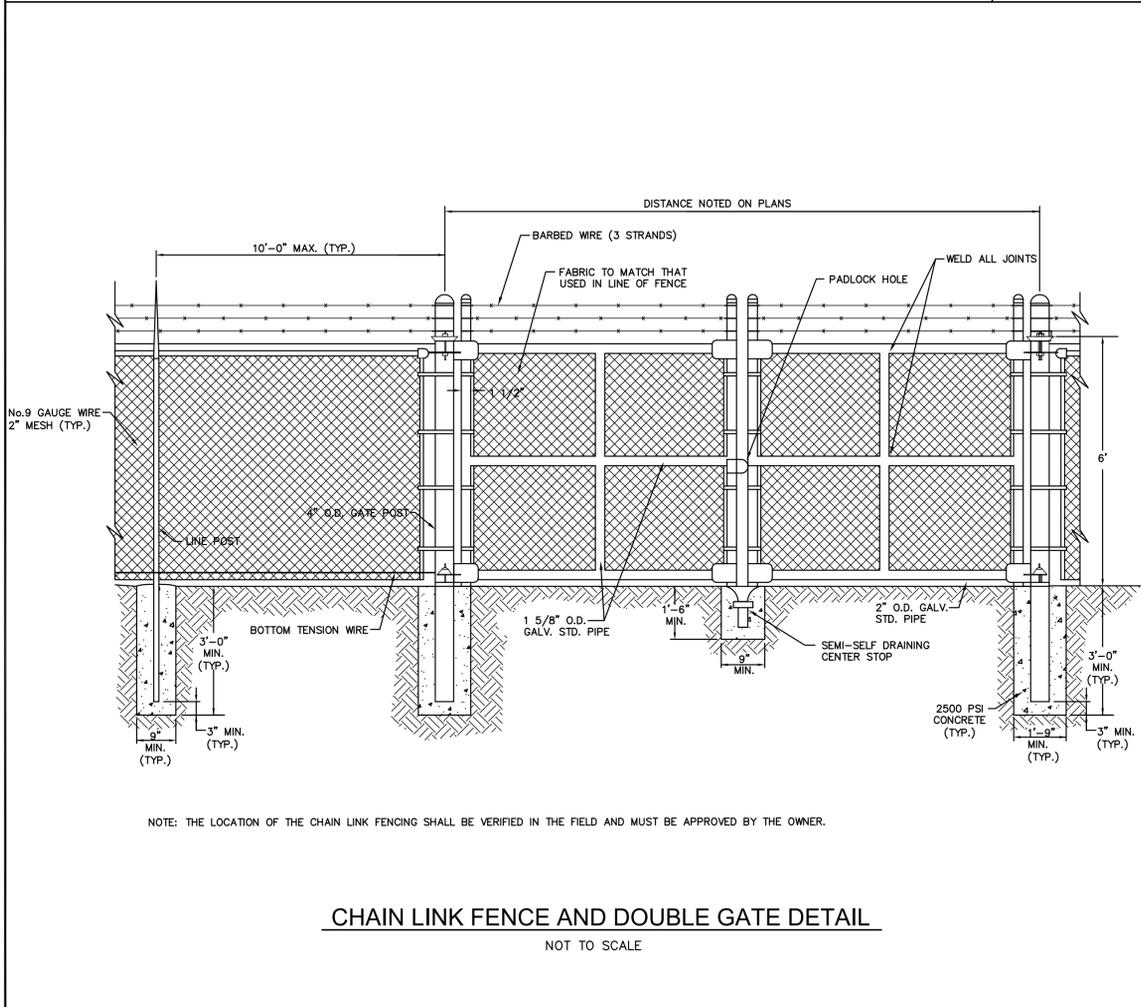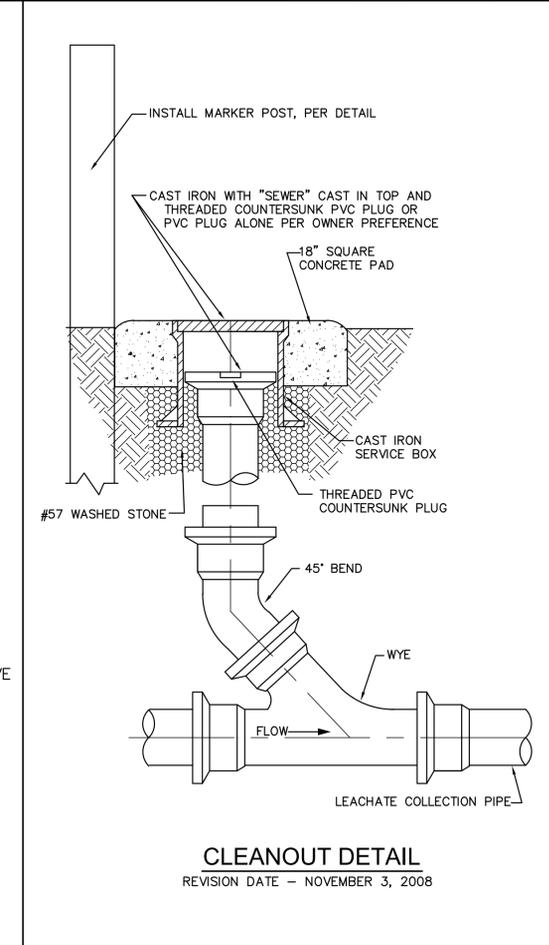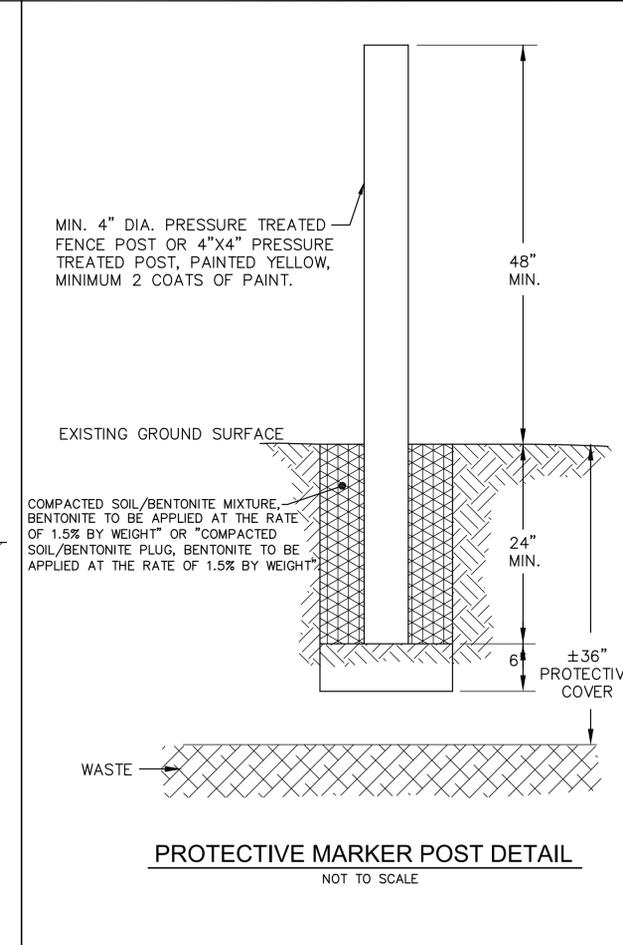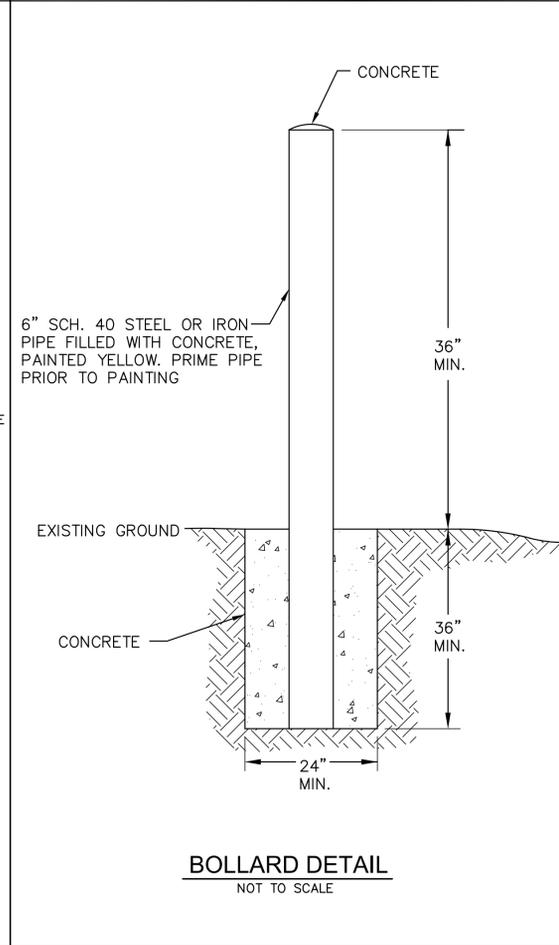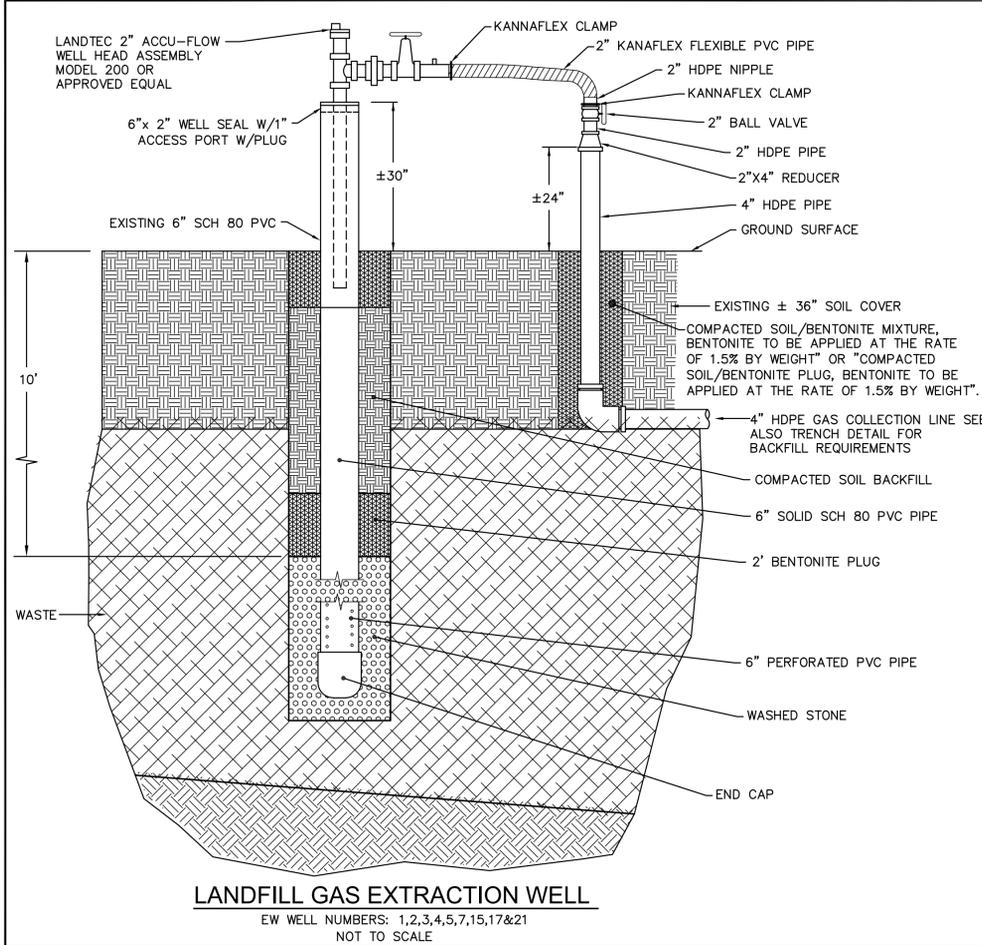

**LANDFILL GAS EXTRACTION WELLS**

**FITTED WITH LEACHATE REMOVAL PUMPS AND DOWN-HOLE PUMP ASSEMBLY**

Well No.	Northing	Easting	Top of Casing Elevation	Approximate Ground Surface Elevation	Drilled Well Depth (From Gr. Surface) (Vert Ft)	Bottom of Well Elevation	Screen Depth (BGS - Ft)	Screen Elevation
EW-6	661,736.17	822,202.22	2801.41	2799.33	56	2743	10 - 56	2789 - 2743
EW-8	661,922.84	821,947.50	2791.01	2789.07	50	2739	10 - 50	2779 - 2739
EW-11	661,845.22	822,410.81	2777.83	2775.81	50	2726	10 - 50	2766 - 2726
EW-14	662,049.11	822,354.97	2771.01	2769.05	49	2720	10 - 49	2759 - 2720
EW-16	662,184.21	822,186.41	2766.32	2764.27	50	2714	10 - 50	2754 - 2714
EW-19	662,224.72	822,562.62	2723.86	2721.92	45	2677	10 - 45	2712 - 2677

**LANDFILL GAS EXTRACTION WELLS**

**FITTED FOR FUTURE LEACHATE REMOVAL PUMPS**

Well No.	Northing	Easting	Top of Casing Elevation	Approximate Ground Surface Elevation	Drilled Well Depth (From Gr. Surface) (Vert Ft)	Bottom of Well Elevation	Screen Depth (Below Ground Surface) (Vert Ft)	Screen Elevation
EW-9	661,827.34	822,044.64	2801.52	2799.37	52	2747	10 - 52	2789 - 2747
EW-10	661,899.24	822,239.54	2796.45	2794.41	66	2728	10 - 66	2784 - 2728
EW-12	662,045.34	822,041.19	2787.56	2785.66	45	2741	10 - 45	2776 - 2741
EW-13	662,048.23	822,187.89	2787.85	2785.99	60	2726	10 - 60	2776 - 2726
EW-18	662,116.02	822,708.85	2728.07	2726.18	45	2681	10 - 45	2716 - 2681
EW-20	662,326.82	822,413.92	2718.25	2716.33	35	2681	10 - 35	2706 - 2681

**LANDFILL GAS EXTRACTION WELLS**

**LANDFILL GAS EXTRACTION ONLY**

Well No.	Northing	Easting	Top of Casing Elevation	Approximate Ground Surface Elevation	Drilled Well Depth (From Gr. Surface) (Vert Ft)	Bottom of Well Elevation	Screen Depth (Below Ground Surface) (Vert Ft)	Screen Elevation
EW-1	661,555.49	821,859.83	2803.72	2801.56	30	2772	10 - 30	2792 - 2772
EW-2	661,497.47	822,026.74	2805.52	2803.23	30	2773	10 - 30	2793 - 2773
EW-3	661,566.28	822,186.05	2802.57	2800.45	40	2760	10 - 40	2790 - 2760
EW-4	661,736.12	821,889.02	2799.96	2798.07	40	2758	10 - 40	2788 - 2758
EW-5	661,654.72	822,032.92	2807.22	2805.08	40	2765	10 - 40	2795 - 2765
EW-7	661,670.35	822,357.16	2782.66	2780.55	30	2751	10 - 30	2771 - 2751
EW-15	662,020.00	822,520.81	2756.87	2755.11	31	2724	10 - 31	2745 - 2724
EW-17	661,944.57	822,751.82	2731.57	2729.67	25	2705	10 - 25	2720 - 2705
EW-21	662,432.43	822,270.03	2713.00	2710.32	30	2680	10 - 30	2700 - 2680

**EXISTING EXTRACTION WELL INFORMATION**

NOTE: EXISTING INFORMATION FOR LFG EXTRACTION WELLS PROVIDED TO ASSIST WITH DETERMINING DEPTHS OF DE-WATERING SYSTEM, PER THE DETAILS ON SHEET C-502

**RECORD DRAWING**

This Drawing has been modified to reflect changes made during construction based upon information provided by the Contractor and construction observations made by the Owner's Authorized Representative.

By *[Signature]* Date *7/23/12*

Seal: NORTH CAROLINA PROFESSIONAL ENGINEER SEAL 36132 WILLIAM H. SPERRY





**McGill ASSOCIATES**  
ENGINEERING · PLANNING · FINANCE  
55 BROAD STREET ASHEVILLE, NC 28801 PH. (828) 252-0575 FIRM LICENSE # C-0459

FRANCIS FARM LANDFILL  
LANDFILL GAS COLLECTION & COMBUSTION SYSTEM  
PHASES 1 - 3  
**HAYWOOD COUNTY**  
HAYWOOD COUNTY, NORTH CAROLINA

MISCELLANEOUS DETAILS  
**SHEET C-503**

0:120908 00721\Design\Solid Waste\Drawings\Record Drawings\RD 09 00721 C-503 Miscellaneous Details.dwg 7/23/2012 1:20 PM KELLY

NOTE: PUMP CONTROL PANEL WITH WARNING LIGHT FURNISHED BY PUMP STATION SUPPLIER.  
 PUMP CONTROL PANEL INCLUDES CONNECTION FOR EMERGENCY PORTABLE GENERATOR.  
 SEE ELECTRICAL DRAWINGS FOR DETAILS.

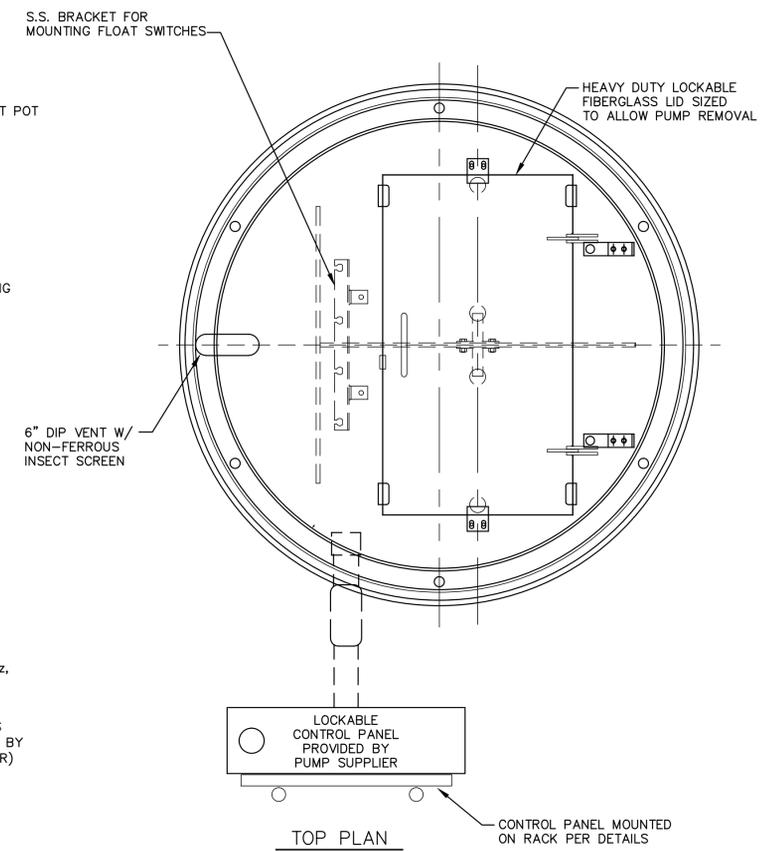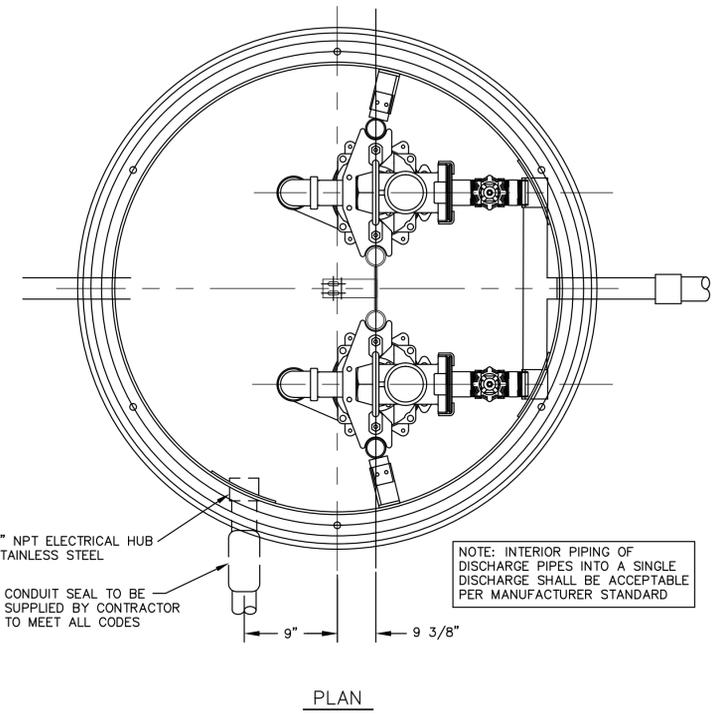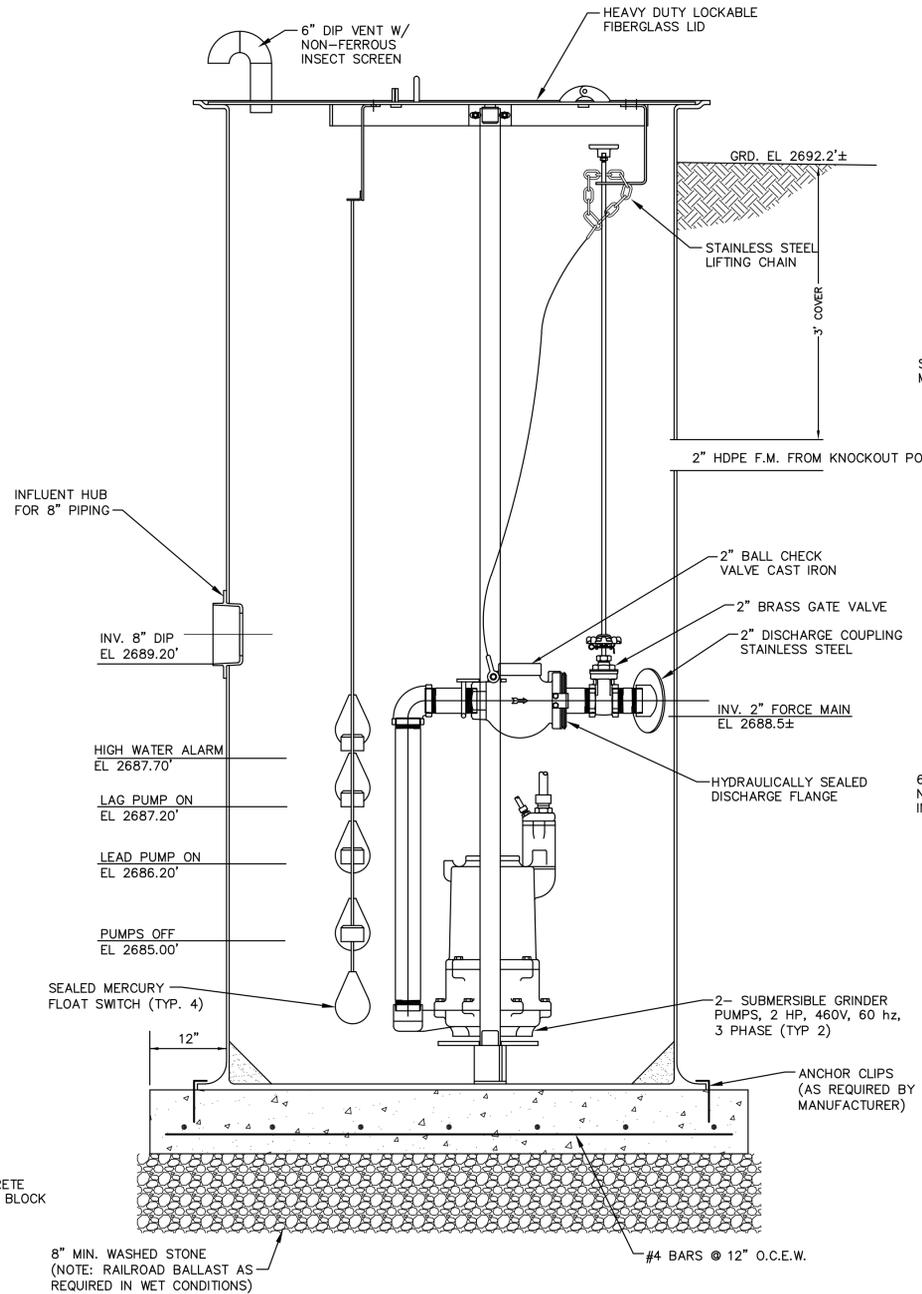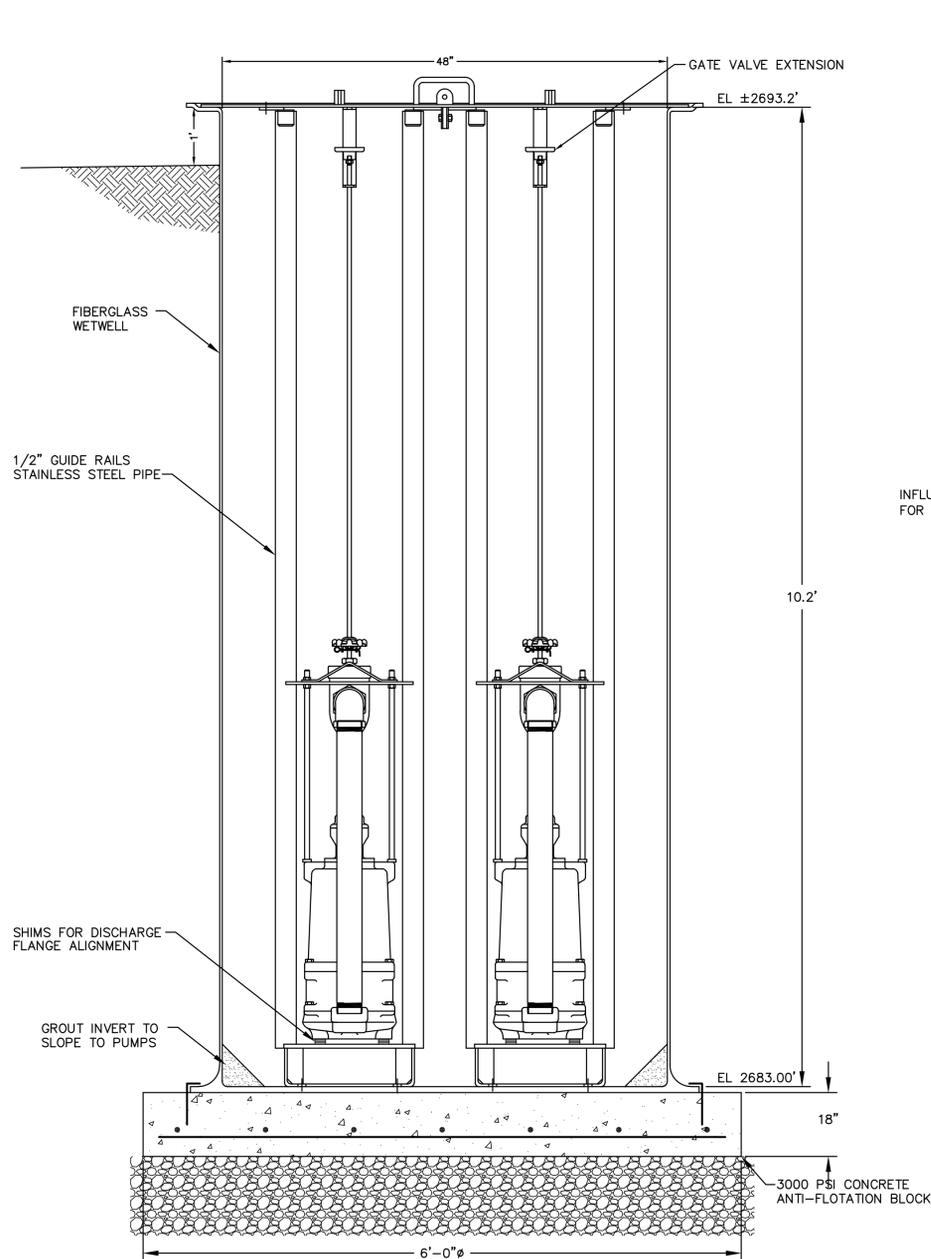

**PACKAGE LEACHAGE PUMP STATION**  
 REVISION DATE - MARCH, 2011

**RECORD DRAWING**

This Drawing has been modified to reflect changes made during construction based upon information provided by the Contractor and construction observations made by the Owner's Authorized Representative.

By *[Signature]* Date *7/23/12*



0:200908 00721 Design/Build Wetwell Drawings/Record Drawings/RD 09.00721-C-504-Miscellaneous-Details.dwg 7/23/2012 1:20 PM KELLY



### LIGHTING MOUNTING AS NOTED

SYMBOL	DESCRIPTION
	CEILING MOUNTED FLUORESCENT FIXTURE; LETTER INSIDE OR BESIDE DENOTES FIXTURE TYPE
	CEILING MOUNTED FLUORESCENT LIGHTING FIXTURE, WIRED FOR NORMAL/STANDBY POWER OPERATION; LETTER INSIDE OR BESIDE FIXTURE DENOTES FIXTURE TYPE
	WALL MOUNTED FLUORESCENT FIXTURE
	CEILING MOUNTED INCANDESCENT OR H.I.D. FIXTURE
	WALL MOUNTED INCANDESCENT OR H.I.D. FIXTURE
	POLE STANDARD LIGHT FIXTURE UNIT - SINGLE ARM
	POLE STANDARD LIGHT FIXTURE UNIT - DOUBLE ARM
	POLE LANTERN TYPE LIGHT FIXTURE UNIT
	EXIT SIGN
	EXIT SIGN (DOUBLE FACE)
	EXIT SIGN WITH DIRECTIONAL ARROW
	EMERGENCY BATTERY PACK UNIT
	REMOTE HEAD FOR EMERGENCY BATTERY PACK UNIT

### SWITCHING

SYMBOL	MOUNTING	DESCRIPTION
S	48" AFF	SWITCH, SINGLE POLE
S <sub>2</sub>	48" AFF	SWITCH, DPDT
S <sub>3</sub>	48" AFF	SWITCH, 3-WAY
S <sub>4</sub>	48" AFF	SWITCH, 4-WAY
S <sub>d</sub>	48" AFF	SWITCH, DIMMER
S <sub>p</sub>	48" AFF	SWITCH WITH PILOT LIGHT
S <sub>M</sub>	48" AFF	SWITCH, MANUAL MOTOR STARTER, RATING AND THERMAL OVERLOADS TO MATCH MOTOR NAME PLATE DATA
S <sub>Mi</sub>	48" AFF	SWITCH, MANUAL MOTOR STARTER WITH IVORY, ILLUMINATED HANDLE
S <sub>MP</sub>	48" AFF	SWITCH, MANUAL MOTOR STARTER WITH PILOT LIGHT
S <sub>f</sub>	48" AFF	MANUAL MOTOR STARTER SWITCH FRACTIONAL HORSEPOWER
	AS NOTED	PHOTOELECTRIC CONTROL
R <sub>1</sub>	48" AFF	LIGHTING CONTACTOR
LC-1		LIGHTING CONTACTOR REMOTE PUSH-BUTTON "ON-OFF" CONTROL REPRESENTS LIGHTING CONTACTOR BEING CONTROLLED
DS	AS NOTED	DOOR SWITCH
MC	AS NOTED	MOTION CONTROL
M	CEILING	MOTION SENSOR
OS	CEILING	OCCUPATION SENSOR

### INTRUSION ALARM SYSTEM

SYMBOL	MOUNTING	DESCRIPTION
D	AS NOTED	INTRUSION ALARM MAGNETIC DOOR CONTACTS
K	48" AFF	INTRUSION ALARM KEY PAD
M	AS NOTED	INTRUSION ALARM MOTION DETECTOR
D EXP	AS NOTED	INTRUSION ALARM MAGNETIC DOOR CONTACTS, EXPLOSION PROOF
	AS NOTED	INTRUSION ALARM BELL
IACP	48" AFF	INTRUSION ALARM CONTROL PANEL

### TELECOMMUNICATION

SYMBOL	MOUNTING	DESCRIPTION
AD	AS NOTED	AUTO DIALER
#	36" AFF	PHONE PORT (# = NUMBER OF VOICE PORTS)
#	36" AFF	DATA PORT (# = NUMBER OF DATA PORTS)
#	36" AFF	COMBINATION DATA/PHONE PORT (# = NUMBER OF DATA PORTS/VOICE PORTS)
#	FLOOR	PHONE PORT- FLOOR BOX-FLUSH (# = NUMBER OF DATA PORTS/VOICE PORTS)

### HVAC

SYMBOL	MOUNTING	DESCRIPTION
M	AS NOTED	MOTOR OPERATED DAMPER
	AS NOTED	UNIT HEATER
T	48" AFF	THERMOSTAT; FURNISHED AND INSTALLED UNDER DIVISION 15 WIRED UNDER DIVISION 16

### POWER

SYMBOL	MOUNTING	DESCRIPTION
WF	36" AFF	DUPLEX RECEPTACLE, 20A RATED FOOTNOTE DELINEATES SPECIFIC DEVICE
		DENOTES MOUNTED 6" ABOVE COUNTERTOP REQUIREMENT - SEE ABBREVIATIONS
	36" AFF	SPECIAL PURPOSE OUTLET (SIZE INDICATED ON PLANS)
	36" AFF	SINGLE RECEPTACLE, 20A RATED
	36" AFF	DUPLEX RECEPTACLE-FLUSH-WITH GROUND FAULT CIRCUIT INTERRUPTER
	36" AFF	DOUBLE DUPLEX RECEPTACLE, 20A RATED
	18" AFF	DUPLEX RECEPTACLE-FLUSH - SURGE-PROTECTIVE DEVICE (SPD)
	FLOOR	DUPLEX RECEPTACLE- FLOOR BOX-FLUSH
	FLOOR	DUPLEX RECEPTACLE- FLOOR BOX-FLUSH - SURGE-PROTECTIVE DEVICE (SPD)
	FLOOR	COMBINATION DUPLEX RECEPTACLE (SPD)/VOICE OUTLET PORT- (# DESIGNATES NUMBER OF VOICE PORTS) - FLOOR BOX-FLUSH
	48" AFF	COMBINATION DISCONNECT SWITCH/MOTOR STARTER
	AS NOTED	MOTOR (HORSEPOWER INDICATED ON PLANS)
	AS NOTED	JUNCTION BOX
	T-1	TRANSFORMER DESIGNATION
CM	AS NOTED	CIRCUIT MONITOR
VR	AS NOTED	VOLTAGE REGULATOR
SPD	AS NOTED	SURGE-PROTECTIVE DEVICE
	48" AFF	EMERGENCY POWER SHUT-OFF SWITCH
	48" AFF	LOCKABLE ON-OFF-AUTO SELECTOR SWITCH W/RED INDICATOR LIGHT
	48" AFF	DISCONNECT SWITCH
	480V	TRANSFORMER
	50KVA	SIZE
	120V	VOLTAGES
		SHIELDED ISOLATION TYPE TRANSFORMER


### PANELBOARDS

SYMBOL	MOUNTING	DESCRIPTION
	TOP BREAKER NEW PANELBOARD - SURFACE MOUNTED 6"-0" AFF	
	TOP BREAKER NEW PANELBOARD - FLUSH MOUNTED 6"-0" AFF	
	---	EXISTING PANELBOARD - SURFACE MOUNTED
	---	EXISTING PANELBOARD - FLUSH MOUNTED

### TYPICAL ANNOTATION

	DRAWING KEYNOTE
	DEMOLITION KEYNOTE
	REVISION TAG
	REVISION CLOUD
	INSTRUMENTATION TAG
	PROCESS EQUIPMENT TAG
	HVAC EQUIPMENT TAG
	AREA NEMA DESIGNATION TAG

### PROCESS & INSTRUMENTATION LEGEND

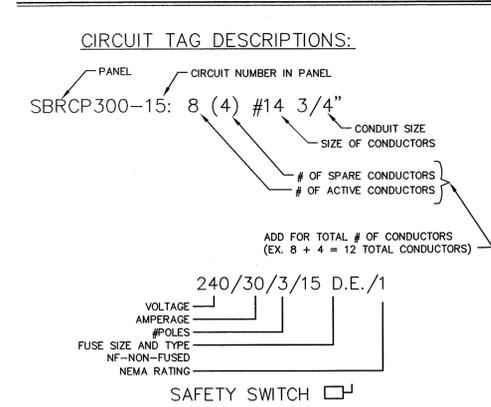

**SAFETY SWITCH DESIGNATOR**  
NOT TO SCALE

NOTES:  
1. INSTALL ALL FUSES SO THAT LABELS ARE RIGHT-SIDE UP AND FACING OUTWARD.  
2. INSTALL OXIDATION INHIBITING COMPOUND SUCH AS PENETROX IN ALL FUSE CLIPS OF SAFETY SWITCHES LOCATED OUTDOORS OR IN WET ENVIRONMENTS.


### CONDUIT FEEDERS AND BRANCH CIRCUITS

SYMBOL	DESCRIPTION
E	OVERHEAD ELECTRIC SERVICE
PE	OVERHEAD PRIMARY ELECTRIC SERVICE
SE	OVERHEAD SECONDARY ELECTRIC SERVICE
T	OVERHEAD TELEPHONE SERVICE
FO	OVERHEAD FIBER OPTIC
CTV	OVERHEAD TELEVISION SERVICE
EU	CONDUIT - EMBEDDED IN FLOOR OR EARTH UNDERGROUND ELECTRIC SERVICE
PEU	UNDERGROUND PRIMARY ELECTRIC SERVICE
SEU	UNDERGROUND SECONDARY ELECTRIC SERVICE
TU	UNDERGROUND TELEPHONE SERVICE
FOU	UNDERGROUND FIBER OPTIC UNDERGROUND TELEVISION SERVICE
CTVU	CONDUIT - IN WALL, CEILING OR EXPOSED CONDUIT WITH IDENTIFIER
XX	CONDUIT TURNED UP
NE	CONDUIT TURNED DOWN
//	CONDUIT CAPPED
F2	BRANCH CIRCUIT WRING
	CIRCUIT HOME RUN
	IN-LINE HOME RUN
	CIRCUIT NUMBER
E	EMERGENCY ONLY CIRCUIT
NE	NORMAL EMERGENCY CIRCUIT
//	DEVICES ON SAME CIRCUIT, SEPARATELY CONTROLLED
F2	ELECTRIC FEEDER LEGEND INDICATION

### FIRE ALARM SYSTEM

SYMBOL	MOUNTING	DESCRIPTION
FACP	48" AFF	FIRE ALARM CONTROL PANEL
FAA	AS NOTED	FIRE ALARM ANNUNCIATOR
A	AS NOTED	FIRE ALARM AUDIBLE/VISIBLE SIGNAL WALL MOUNTED AT 6"-8" A.F.F. OR 6" BELOW CEILING; WHICHEVER IS LOWER
F	48" AFF	FIRE ALARM MANUAL PULL STATION
S	CEILING	FIRE ALARM SMOKE DETECTOR
H	CEILING	FIRE ALARM HEAT DETECTOR, FIXED TYPE
A EXP	AS NOTED	FIRE ALARM AUDIBLE ALARM, EXPLOSION PROOF WALL MOUNTED AT 6"-8" A.F.F. OR 6" BELOW CEILING; WHICHEVER IS LOWER
V EXP	AS NOTED	FIRE ALARM VISIBLE ALARM, EXPLOSION PROOF, WALL MOUNTED AT 6"-8" A.F.F. OR 6" BELOW CEILING; WHICHEVER IS LOWER
F EXP	48" AFF	FIRE ALARM MANUAL PULL STATION, EXPLOSION PROOF
H EXP	CEILING	FIRE ALARM HEAT DETECTOR, FIXED TYPE, EXPLOSION PROOF
TS	48" AFF	FIRE SUPPRESSION SYSTEM TAMPER SWITCH
FS	48" AFF	FIRE SUPPRESSION SYSTEM FLOW SWITCH
PS	48" AFF	FIRE SUPPRESSION SYSTEM PRESSURE SWITCH


### PROCESS EQUIPMENT TAGGING

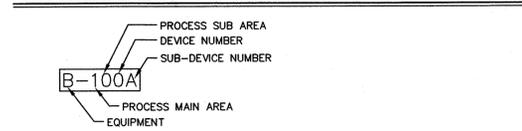

### EQUIPMENT:

AC	AIR COMPRESSOR	MX	MIXER
B	BLOWER	P	PUMP
C	COMMUNICATOR	S	SAMPLER
CFD	CHEMICAL FEEDER	SC	SCREEN
CP	CONTROL PANEL	SV	SOLENOID VALVE
D	DECANTER	T	TANK
DPC	DEFINITE PURPOSE CONTACTOR	V	VALVE
G	GRINDER	ZS	POSITION SWITCH


### INSTRUMENT & FUNCTION TAGGING

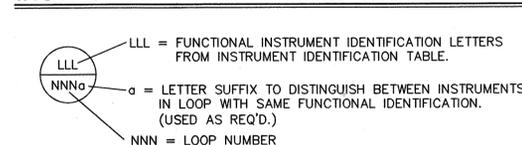

### ABBREVIATIONS

A OR AMP	AMPERE	GFCI	GROUND FAULT CIRCUIT INTERRUPTER	NPT	NOMINAL PIPE THREADS
A.C.	ALTERNATING CURRENT	GND. or GRD.	GROUND	OE	OVERHEAD ELECTRIC
AF	FRAME AMPERE	H.I.D.	HIGH INTENSITY DISCHARGE	P	# OF POLES IN CIRCUIT BREAKER
A.F.F.	ABOVE FINISHED FLOOR	HP	HORSEPOWER	PH or Ø	PHASE
A.F.G.	ABOVE FINISHED GRADE	H.P.S.	HIGH PRESSURE SODIUM	PM	POWER MONITOR
A.I.C.	AMPERE INTERRUPTING CURRENT	HSPS	HIGH SERVICE PUMP STATION	PMT	PAD MOUNTED TRANSFORMER
AS	AMMETER SELECTOR SWITCH	HVAC	HEAT-VENT-AIR CONDITIONING	PNL	PANEL
AT	TRIP AMPERE	I.G.	ISOLATED GROUND	PSI	POUNDS PER SQUARE INCH
A.T.S.	AUTOMATIC TRANSFER SWITCH	I.D.	INNER DIAMETER	PT	POTENTIAL TRANSFORMER
AUTO	AUTOMATIC	IMC	INTERMEDIATE METAL CONDUIT	PVC	POLYVINYL CHLORIDE
AWG	AMERICAN WIRE GAUGE	IND.	INDUSTRIAL	QTY.	QUANTITY
B.F.G.	BELOW FINISHED GRADE	JB	JUNCTION BOX	RGS	RIGID GALVANIZED STEEL
BLDG.	BUILDING	J.I.C.	JOINT INDUSTRIAL COUNCIL	RVSS	REDUCED VOLTAGE SOLID STATE
C	COUNTERTOP RECEPTACLE	KA	KILOAMPERE	SC	SURGE CAPACITOR
C. or COND.	CONDUIT	KCML	1000 CIRCULAR MILS	SCC	SYSTEM CONTROL CENTER
CB	CIRCUIT BREAKER	KV	KILOVOLT	SER	SERVICE ENTRANCE RATED
CKT	CIRCUIT	KVA	KILOVOLT AMPERE	SM	SUB-METER
CP	CONTROL PANEL	KW	KILOWATT	SP	SPARE
CPT	CONTROL PANEL TRANSFORMER	LA	LIGHTNING ARRESTOR	SPD	SURGE-PROTECTIVE DEVICE
CR	CONTROL RELAY	LC	LIGHTING CONTACTOR	S.S.	STAINLESS STEEL
DESIG	DESIGNATION	LTG	LIGHTING	SWBD	SWITCHBOARD
DIA.	DIAMETER	MAX	MAXIMUM	TBA	TO BE ABANDONED
DIV.	DIVISION	MCB	MAIN CIRCUIT BREAKER	TBR	TO BE REMOVED
DPDT	DOUBLE POLE, DOUBLE THROW	mA	MILI-AMP	TCC	TELECOMMUNICATIONS CLOSET
DS	DISCONNECT SWITCH	MC	MANUFACTURER'S CABLE	TDC	TELECOMMUNICATIONS DISTRIBUTION CLOSET
E.C.	ELECTRICAL CONTRACTOR	MCC	MOTOR CONTROL CENTER	TYP.	TYPICAL
EHH	ELECTRIC HANDHOLE	MFR	MANUFACTURER	UE	UNDERGROUND ELECTRIC
EMH	ELECTRIC MANHOLE	MIN.	MINIMUM	UH	UNIT HEATER
EP	EXPLOSION PROOF	M.L.O.	MAIN LUG ONLY	UL	UNDERWRITERS LABORATORY
E.T.R.	EXISTING TO REMAIN	M.O.D.	MOTOR OPERATED DAMPER	U.O.N.	UNLESS OTHERWISE NOTED
EUH	ELECTRIC UNIT HEATER	MS	MOTOR STARTER	UE	UNDERGROUND ELECTRIC
E.W.	EACH WAY	MTD.	MOUNTED	UT	UNDERGROUND TELEPHONE
EX	EXAMPLE	N/A	NOT APPLICABLE	UV	ULTRAVIOLET
EXH	EXHAUST FAN	N.C.	NORMALLY CLOSED	V	VOLT
FU	FUSE	NEMA	NATIONAL ELECTRICAL MANUFACTURER'S ASSOCIATION	VAC	VOLTS ALTERNATING CIRCUIT
FRE	FIBERGLASS REINFORCED EPOXY	NID	NETWORK INTERFACE DEVICE (4 POSITION)	VS	VOLTMETER SELECTOR SWITCH
G.C.	GENERAL CONTRACTOR	N.O.	NORMALLY OPEN	W	WIRE
GEN	GENERATOR	No.	NUMBER	WP	WEATHERPROOF
				XFMR	TRANSFORMER

### DUCTBANK SYMBOL KEY

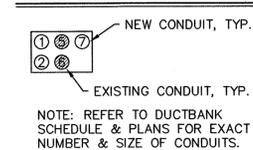

### GENERAL NOTES:

- DRAWINGS ARE DIAGRAMMATIC IN NATURE, CONTRACTOR SHALL VERIFY DIMENSIONS PRIOR TO INSTALLATION CONTRACTOR SHALL COORDINATE ALL WORK WITH OTHER DIVISION TRADES TO PROVIDE A COMPLETE AND OPERABLE SYSTEM. LOCATE FIXTURES, DEVICES, ETC. IN ORDER TO AVOID INTERFERENCES.
- ALL WORK SHALL BE PERFORMED AS REQUIRED BY APPLICABLE SECTION OF THE NATIONAL ELECTRICAL CODE, LATEST EDITION, AND ALL GOVERNING LOCAL CODES, LAWS, AND/OR REGULATIONS.
- SYSTEM AND EQUIPMENT GROUNDING CONTINUITY SHALL BE ASSURED AS REQUIRED BY APPLICABLE SECTIONS OF THE NATIONAL ELECTRICAL CODE.
- ALL WIRING SHALL BE TYPE "THHN-THWN" U.O.N.; MINIMUM WIRING SHALL BE #12 (POWER WIRE). ALL WIRE SHALL BE COPPER. MINIMUM CONDUIT SIZE FOR METALLIC CONDUIT TO BE 3/4" AND 1" FOR PVC.
- ALL CIRCUIT PROTECTIVE DEVICES SHALL HAVE THE REQUIRED RATING INTERRUPTING CAPACITY EQUAL TO OR GREATER THAN THE AVAILABLE SHORT-CIRCUIT CURRENT AT ITS SUPPLY TERMINAL; MINIMUM INTERRUPTING CAPACITY SHALL BE 10,000 AMPS, SYMMETRICAL A.I.C. FOR 120/208V SYSTEMS AND 14,000 AMPS, SYMMETRICAL A.I.C. FOR 277/480V SYSTEMS. REFER TO PANEL SCHEDULES FOR A.I.C. RATINGS.
- ALL OUTDOOR EXPOSED CONDUIT TO BE PVC COATED RGS. TRANSITION FROM UNDERGROUND TO EXPOSED SHALL BE PVC COATED RGS.
- ALL UNDERGROUND CONDUITS TO BE SCHEDULE 40 PVC UNLESS OTHERWISE INDICATED. ALL CONDUITS SHALL INCLUDE A NYLON PULL CORD.

### INSTRUMENT IDENTIFICATION TABLE

LETTER	FIRST LETTER		SUCCEEDING LETTERS		
	MEASURED OR INITIATING VARIABLE	MODIFIER	READOUT OR PASSIVE FUNCTION	OUTPUT FUNCTION	MODIFIER
A	ANALYSIS (2)		ALARM		
B	BURNER, COMBUSTION			CLOSE, STOP, DECREASE (1)	OFF (1)
C				CONTROL	
D		DIFFERENTIAL		OPEN, START, INCREASE (1)	
E	VOLTAGE		SENSOR (PRIMARY ELEMENT)		ENABLED (1)
F	FLOW RATE	RATIO (FRACTION)			FAIL (1)
G			GLASS, VIEWING DEVICE		
H	HAND				HIGH (OPENED)
I	CURRENT (ELECTRICAL)		INDICATE		
J	POWER	SCAN			
K	TIME, TIME SCHEDULE	TIME RATE OF CHANGE		CONTROL STATION	
L	LEVEL		LIGHT		LOW (CLOSED)
M	MOTOR, MOTION (1)	MOMENTARY		MOTOR (1)	MIDDLE OR INTERMEDIATE ON OR OPERATE (1)
N			ORIFICE, RESTRICTION		OVERLOAD (1)
O			POINT (TEST) CONNECTION	PUMP (1)	
P	PRESSURE, VACUUM		RECORD		
Q	QUANTITY (2)	INTEGRATE, TOTALIZE			
R	RADIATION				
S	SPEED, FREQUENCY	SAFETY OR SOLENOID			
T	TEMPERATURE			SWITCH	
U	MULTIVARIABLE (2)		MULTIFUNCTION (2)	MULTIFUNCTION (2)	MULTIFUNCTION (2)
V	VIBRATION, MECHANICAL ANALYSIS			VALVE, DAMPER, LOUVER	
W	WEIGHT, FORCE		WELL		
X	UNCLASSIFIED, (2)		UNCLASSIFIED (2)		UNCLASSIFIED (2)
Y	EVENT, STATE, PRESENCE			RELAY, COMPUTE, CONVERT	
Z	POSITION, DIMENSION			DRIVER, ACTUATOR, UNCLASSIFIED FINAL CONTROL ELEMENT	

- USER'S CHOICE
- WHEN USED, SYMBOL OR SIGNAL LINE IS INDICATED.

### RECORD DRAWING

This Drawing has been modified to reflect changes made during construction based upon information provided by the Contractor and construction observations made by the Owner's Authorized Representative.

By *Phyllis A. John* Date 7-23-12



FRANCIS FARM LANDFILL  
LANDFILL GAS COLLECTION & COMBUSTION SYSTEM  
PHASES 1 - 3  
**HAYWOOD COUNTY**  
HAYWOOD COUNTY, NORTH CAROLINA

JOB NO.: 09.00721  
DATE: NOVEMBER 2009  
DESIGNED BY: DLG  
CADD BY: SAR  
DESIGN REVIEW: PAF  
CONST. REVIEW: NAME  
FILE NAME:  
RD - 09.00721-E-001.dwg


ELECTRICAL LEGEND, NOTES, SCHEDULES, AND ABBREVIATIONS

SHEET  
**E-001**

C:\2009\08\0721\Design\Electrical\Drawings\RD - 09.00721-E-101.dwg 4/12/2012 9:10 AM SONJA ROBERTS

**DRAWING NOTES:**

- 1 CONTRACTOR IS TO COORDINATE WITH THE POWER COMPANY TO RUN 3Ø SERVICE FROM EXISTING POWER POLE TO FLARE STATION.
- 2 CONTRACTOR IS TO COORDINATE WITH THE TELEPHONE COMPANY TO GET TELEPHONE SERVICE FOR THE TELEPHONE ALARM DIALER. LOCATED IN THE FLARE STATION CONTROL PANEL.
- 3 NO OVERHEAD UTILITIES SHALL BE LOCATED WITHIN 90' OF FLARE.
- 4 REFER TO TYPICAL POST DETAIL FOR PISTON PUMP CONTROL PANEL ON SHEET E-501.

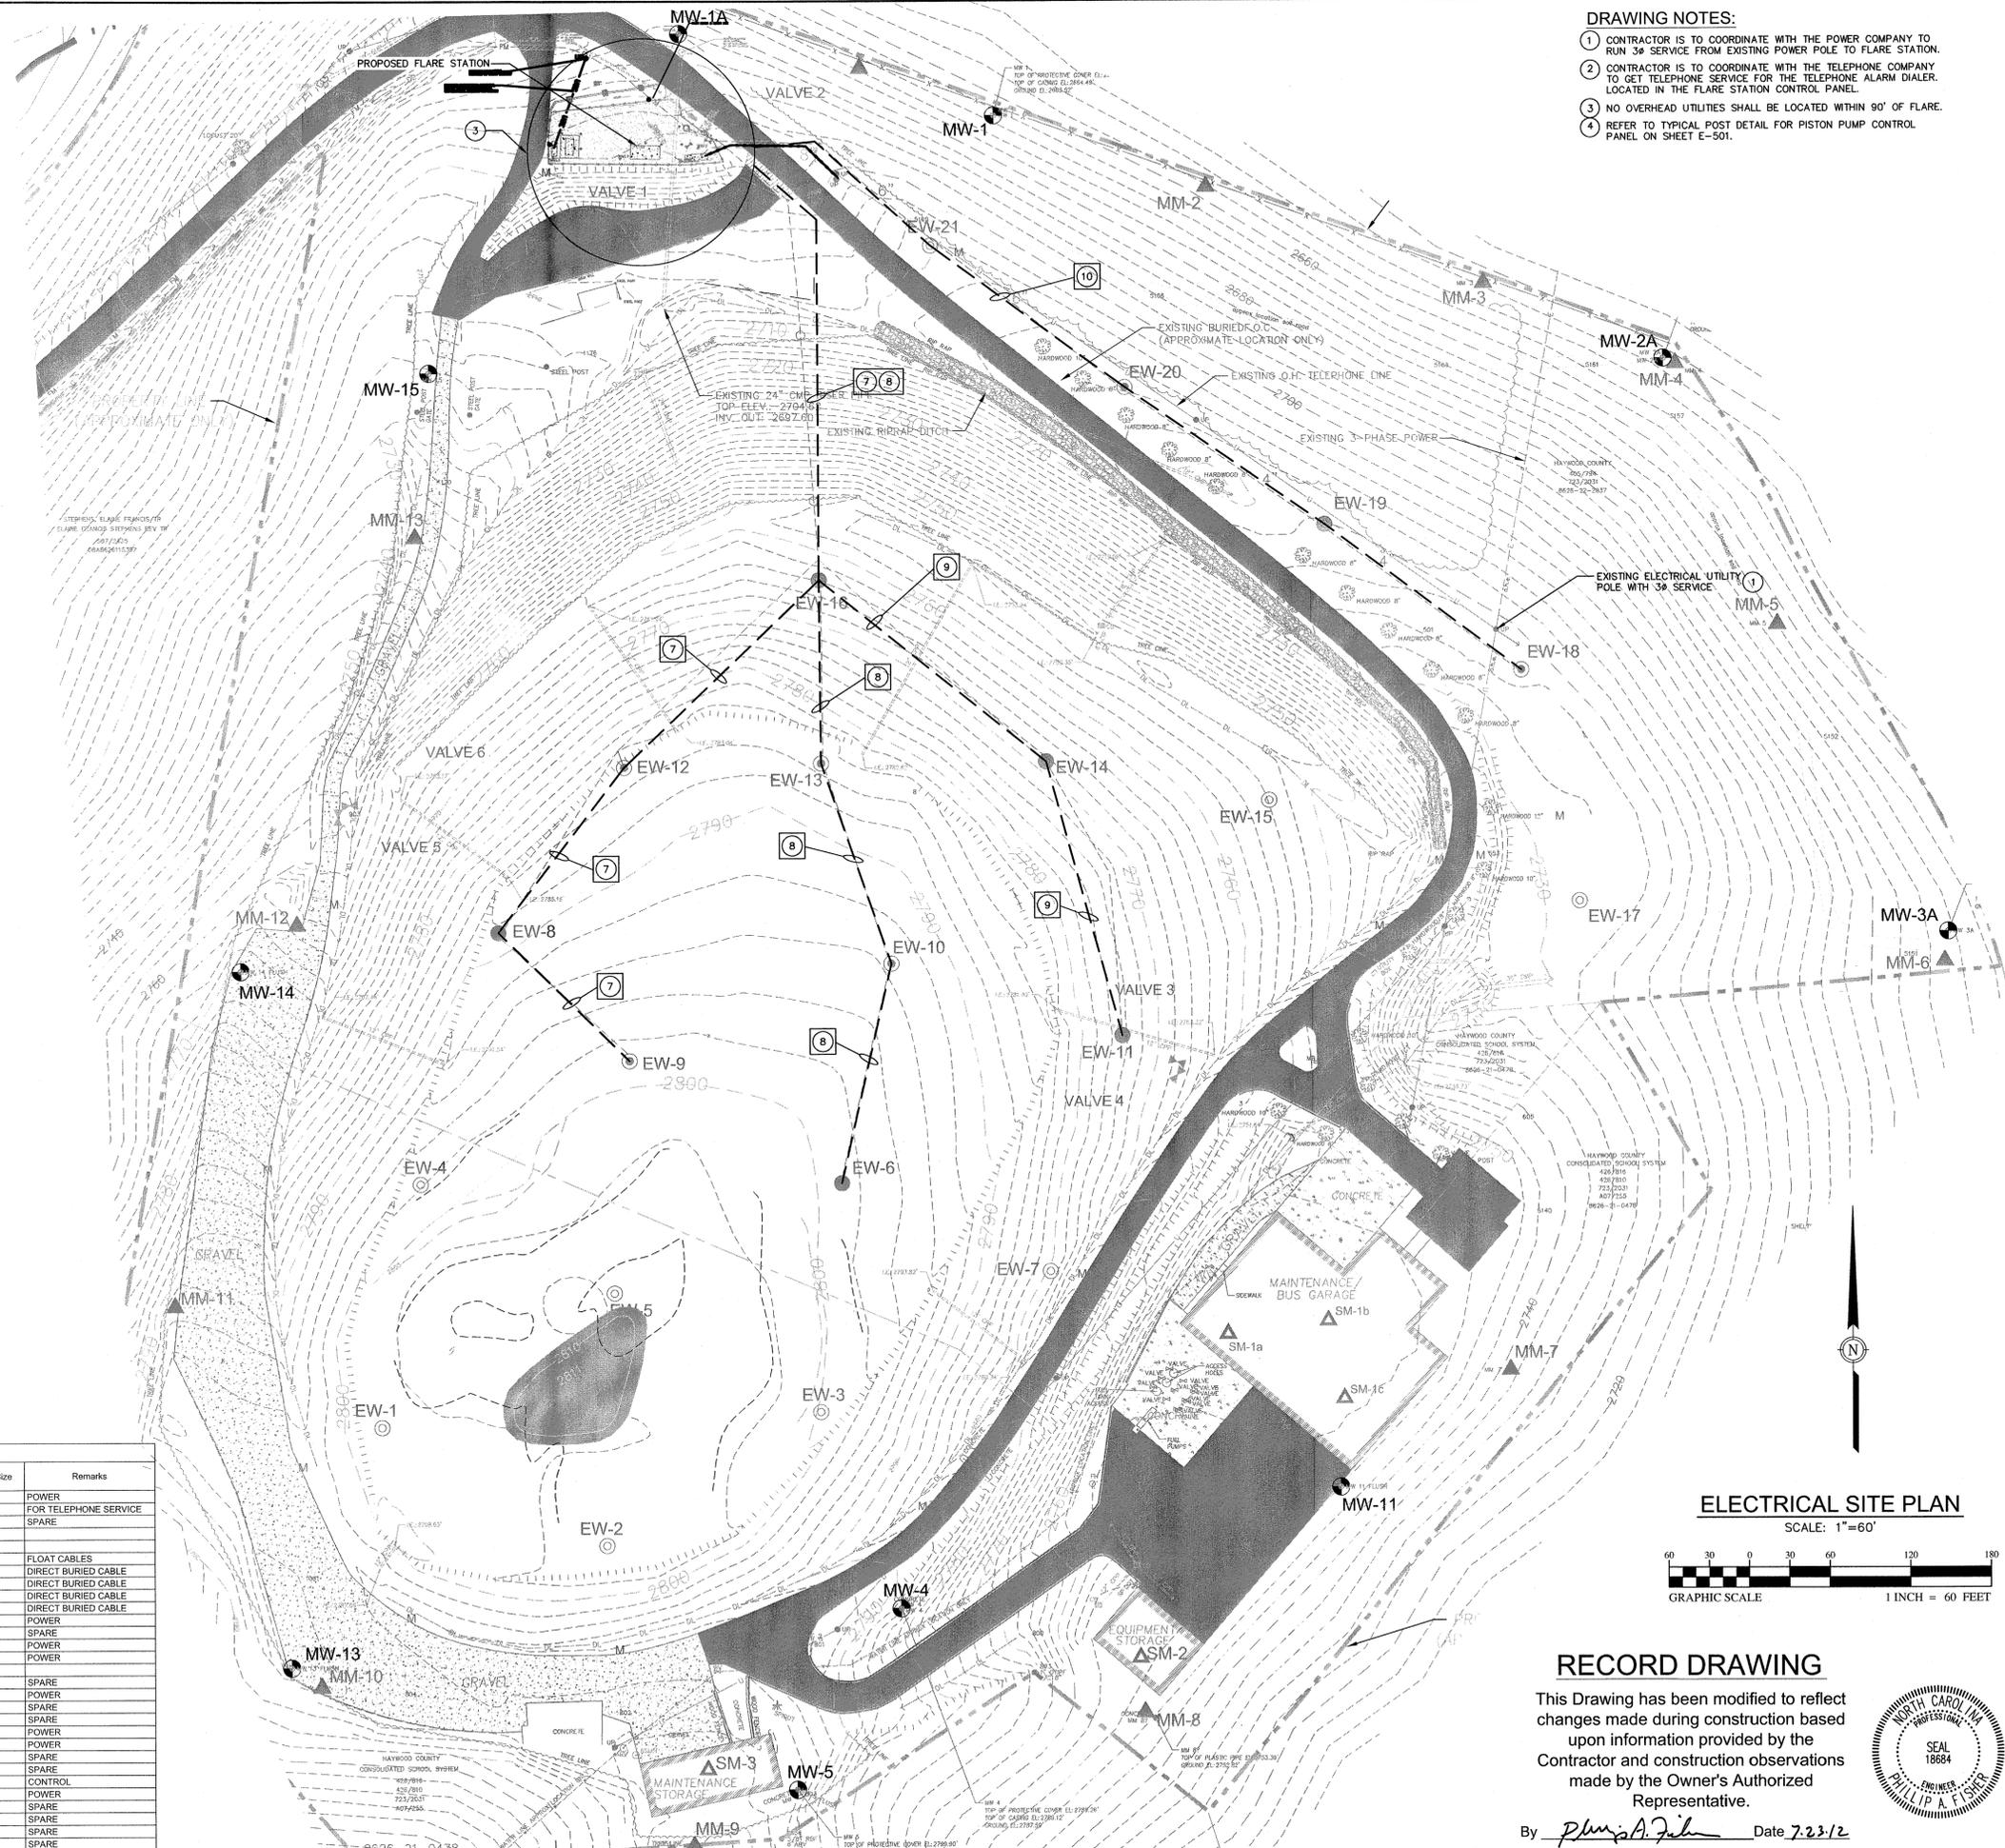


**Ductbank Conduit Schedule**

Conduit Tag No.	From	To	Conduit/Wiring Legend No.	Conduit Size	Remarks
1	SERVICE POLE	METERBASE	REFER TO ONE-LINE	2"	POWER
2	SERVICE POLE	METERBASE	CONDUIT ONLY	2"	FOR TELEPHONE SERVICE
3	SERVICE POLE	TELEPHONE INTERFACE	CONDUIT ONLY	2"	SPARE
4	PSCP	PUMP #1	PSCP-1	2"	
5	PSCP	PUMP #2	PSCP-2	2"	
6	PSCP	WETWELL	PSCP-3,4,5,6	4-1"	FLOAT CABLES
7	PANEL M	EW-12, EW-9, EW-8	M-7, 9, 11	N/A	DIRECT BURIED CABLE
8	PANEL M	EW-16, EW-13, EW-10, EW-6	M-8, 10, 12	N/A	DIRECT BURIED CABLE
9	EW-16	EW-14, EW-11	M-8, 10, 12	N/A	DIRECT BURIED CABLE
10	PANEL M	EW-21, EW-20, EW-19, EW-18	M-13, 15, 17	N/A	DIRECT BURIED CABLE
11	PANEL LP	FUTURE GENERATOR NO. 1	LP-1,3	1"	POWER
12	PANEL LP	FUTURE GENERATOR NO. 1	CONDUIT ONLY	1"	SPARE
13	CONDENSATE PUMP CONTROL PANEL	KNOCKOUT POT	3-#10&1-#10 GND	1"	POWER
14	PANEL M	FLARE STATION CONTROL PANEL	M-1,3,5	1"	POWER
15	TELEPHONE INTERFACE	FLARE STATION CONTROL PANEL	CA1,3	1"	SPARE
16	EQUIPMENT RACK	FLARE STATION CONTROL PANEL	CONDUIT ONLY	1"	SPARE
17	UTILITY POLE FOR GENERATORS	GENERATOR EQUIPMENT RACK	SEE ONE LINE	3"	POWER
18	UTILITY POLE FOR GENERATORS	GENERATOR EQUIPMENT RACK	CONDUIT ONLY	3"	SPARE
19	FLARE STATION CONTROL PANEL	GENERATOR EQUIPMENT RACK	CONDUIT ONLY	2"	SPARE
20	PANEL LP	AREA LUMINAIRE	LP-4	3/4"	POWER
21	PANEL LP	AREA LUMINAIRE	LP-4	3/4"	POWER
22	GENERATOR EQUIPMENT RACK	FUTURE GENERATOR NO. 1	CONDUIT ONLY	3"	SPARE
23	GENERATOR EQUIPMENT RACK	FUTURE GENERATOR NO. 1	CONDUIT ONLY	3-1"	SPARE
24	PUMP STATION CONTROL PANEL	FLOW METER	PSCP-7	3/4"	CONTROL
25	PANEL LP	FLOW METER	LP-6	3/4"	POWER
26	ELECTRICAL EQUIPMENT RACK	FUTURE GENERATOR NO. 2	CONDUIT ONLY	3"	SPARE
27	GENERATOR EQUIPMENT RACK	FUTURE GENERATOR NO. 2	CONDUIT ONLY	3"	SPARE
28	GENERATOR EQUIPMENT RACK	FUTURE GENERATOR NO. 2	CONDUIT ONLY	3-1"	SPARE
29	ELECTRICAL EQUIPMENT RACK	FUTURE GENERATOR NO. 2	CONDUIT ONLY	3-1"	SPARE

**ELECTRICAL SITE PLAN**

SCALE: 1"=60'

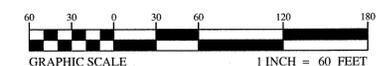

**RECORD DRAWING**

This Drawing has been modified to reflect changes made during construction based upon information provided by the Contractor and construction observations made by the Owner's Authorized Representative.


By *Philip A. Fisher* Date *7.23.12*




FRANCIS FARM LANDFILL  
LANDFILL GAS COLLECTION & COMBUSTION SYSTEM  
PHASES 1 - 3  
**HAYWOOD COUNTY**  
HAYWOOD COUNTY, NORTH CAROLINA

JOB NO.: 09.00721  
DATE: NOVEMBER 2009  
DESIGNED BY: DLG  
CADD BY: SAR  
DESIGN REVIEW: PAF  
CONST. REVIEW: \_\_\_\_\_  
FILE NAME: RD - 09.00721-E-101.dwg

**ELECTRICAL SITE PLAN**  
**SHEET**  
**E-101**

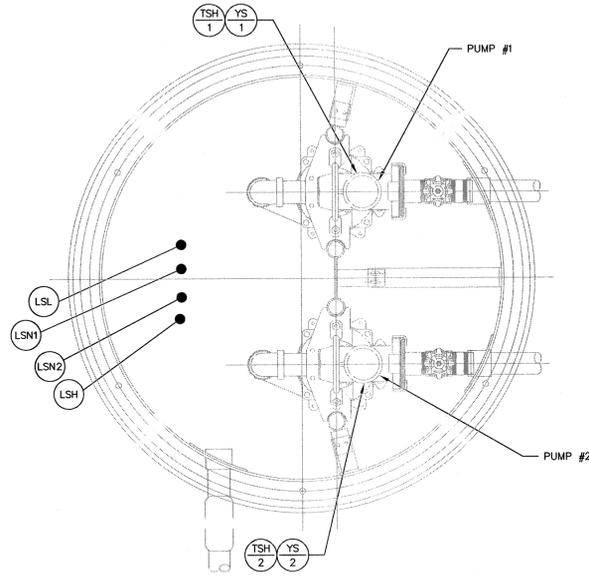

**PUMP STATION PLAN VIEW**  
NOT TO SCALE

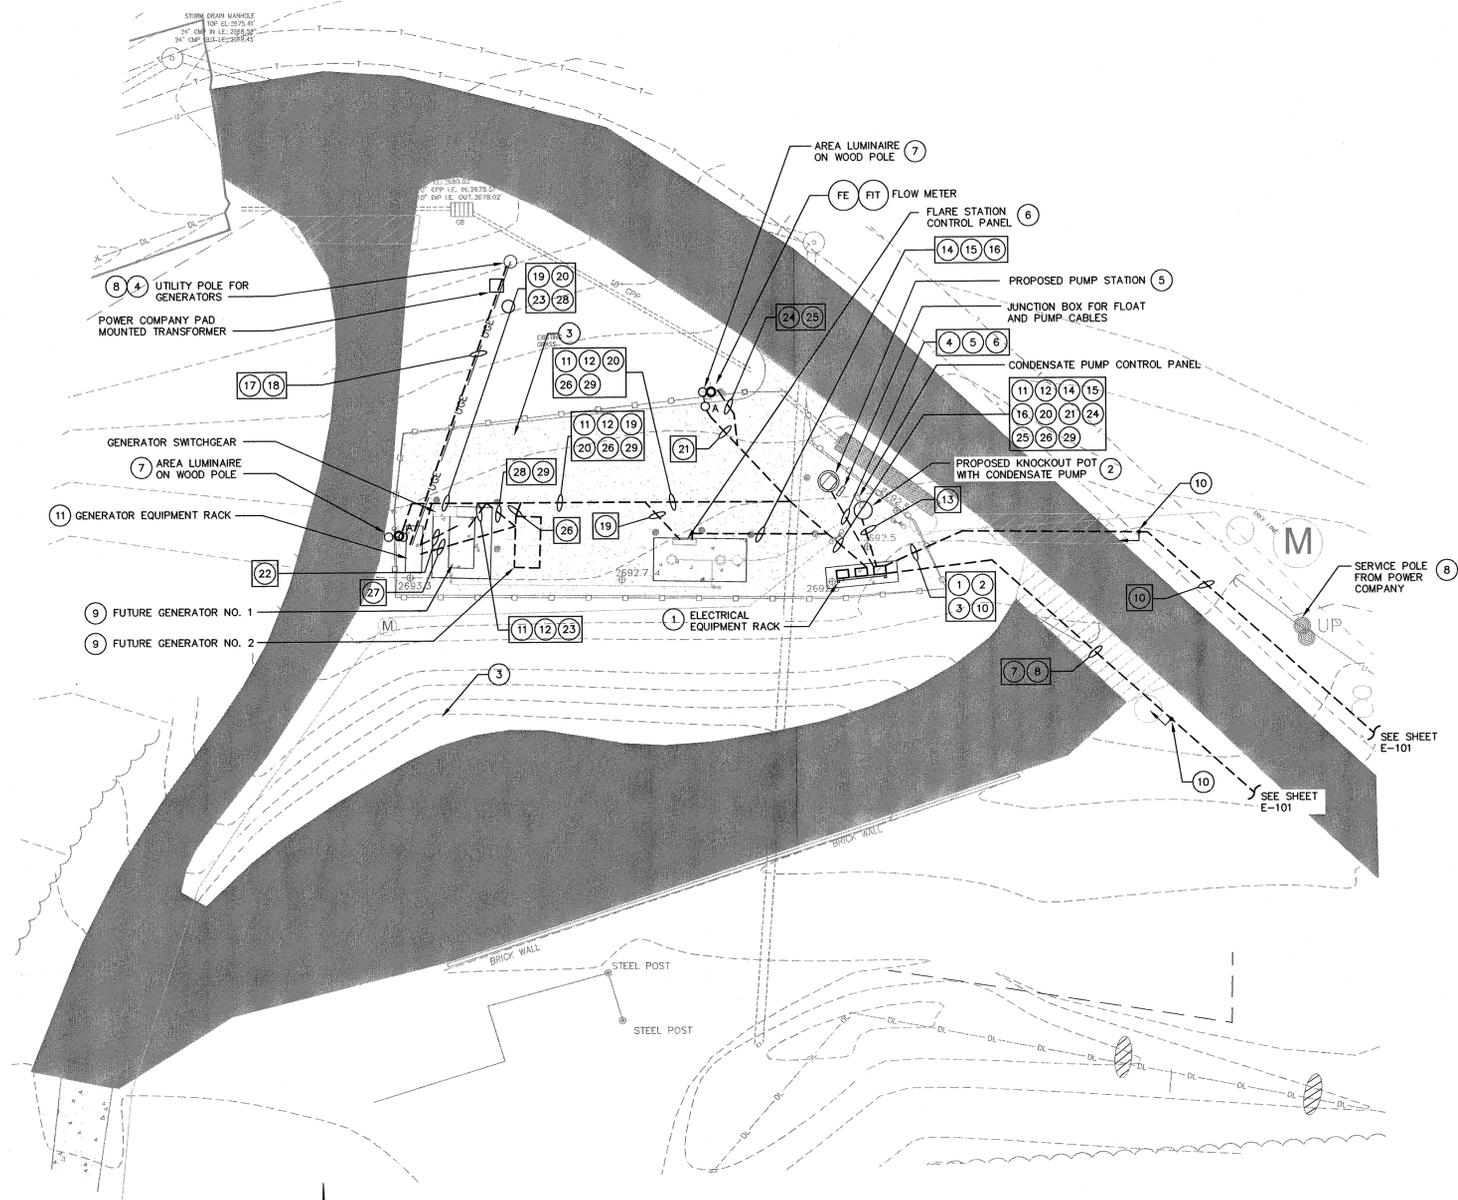

**FLARE PAD SITE PLAN**

SCALE: 1"=20'



**DRAWING NOTES:**

- 1 FOR EQUIPMENT ORIENTATION REFER TO ELECTRICAL EQUIPMENT RACK DETAIL ON SHEET E-501.
- 2 REFER TO TYPICAL POST DETAIL FOR PISTON PUMP CONTROL PANEL ON SHEET E-501.
- 3 CONTRACTOR TO COORDINATE THE REMOVAL OF EXISTING UTILITY POLES.
- 4 CONTRACTOR TO COORDINATE WITH THE POWER COMPANY FOR THE INSTALLATION OF THE UTILITY POLE FOR THE GENERATORS, AS WELL AS, CONNECTING THE GENERATOR CONDUCTORS WITH THE POWER COMPANY CONDUCTORS.
- 5 SEE PUMP STATION PLAN VIEW ON THIS SHEET.
- 6 CONTRACTOR IS RESPONSIBLE FOR THE INSTALLATION OF ALL THE NECESSARY FIELD WIRING AND RACEWAYS FOR PROPER INSTALLATION OF THE PACKAGED FLARE SYSTEM.
- 7 SEE LIGHTING POLE DETAIL ON SHEET E-501.
- 8 CONTRACTOR TO STRIP CONDUIT ABOVE THE GROUND AT THE SERVICE POLE AND UTILITY POLE FOR POWER COMPANY TO RUN THE WIRE UP EACH POLES AND CONNECT THE WIRE WITH THE SERVICE DROP.
- 9 THE EXACT LOCATIONS OF CONDUIT AND CABLE TERMINATIONS FOR RACEWAYS TERMINATING AT FUTURE GENERATOR WILL BE PROVIDED TO THE CONTRACTOR DURING CONSTRUCTION.
- 10 PROVIDE 2" CONDUIT SLEEVE FROM POINT INDICATED TO PANEL "M" FOR WELL PUMP CABLES.
- 11 PROVIDE RACK CONSTRUCTION SIMILAR TO THAT INDICATED FOR THE ELECTRICAL EQUIPMENT RACK. REFER TO DETAIL ON SHEET E-501. IN ADDITION TO EQUIPMENT INDICATED ON THE LANDFILL GAS GENERATOR POWER ONE-LINE, PROVIDE 72" OF CONTINUOUS HORIZONTAL SPACE ON RACK FOR FUTURE EQUIPMENT.
- 12 PROVIDE #2 COPPER WIRE TO BOND BETWEEN THE GROUNDING ELECTRODE CONDUCTORS FOR THE ELECTRICAL SERVICES FOR THE FLARE STATION AND THE LANDFILL GAS GENERATOR, AS WELL AS, THE STRUCTURAL METAL IN THE FLARE STATION PAD, ALL ELECTRICAL EQUIPMENT RACKS AND CONCRETE PADS, AND THE GENERATOR PAD.



FRANCIS FARM LANDFILL  
LANDFILL GAS COLLECTION & COMBUSTION SYSTEM  
PHASES 1-3  
**HAYWOOD COUNTY**  
HAYWOOD COUNTY, NORTH CAROLINA

JOB NO.: 09.00721  
DATE: NOVEMBER 2009  
DESIGNED BY: DLG  
CADD BY: SAR  
DESIGN REVIEW: PAF  
CONST. REVIEW: \_\_\_\_\_  
FILE NAME: RD - 09.00721-E-102.dwg

**FLARE PAD PLANS**


**SHEET**  
**E-102**

**RECORD DRAWING**


This Drawing has been modified to reflect changes made during construction based upon information provided by the Contractor and construction observations made by the Owner's Authorized Representative.

By *Phillip A. Fisher* Date *7.23.12*




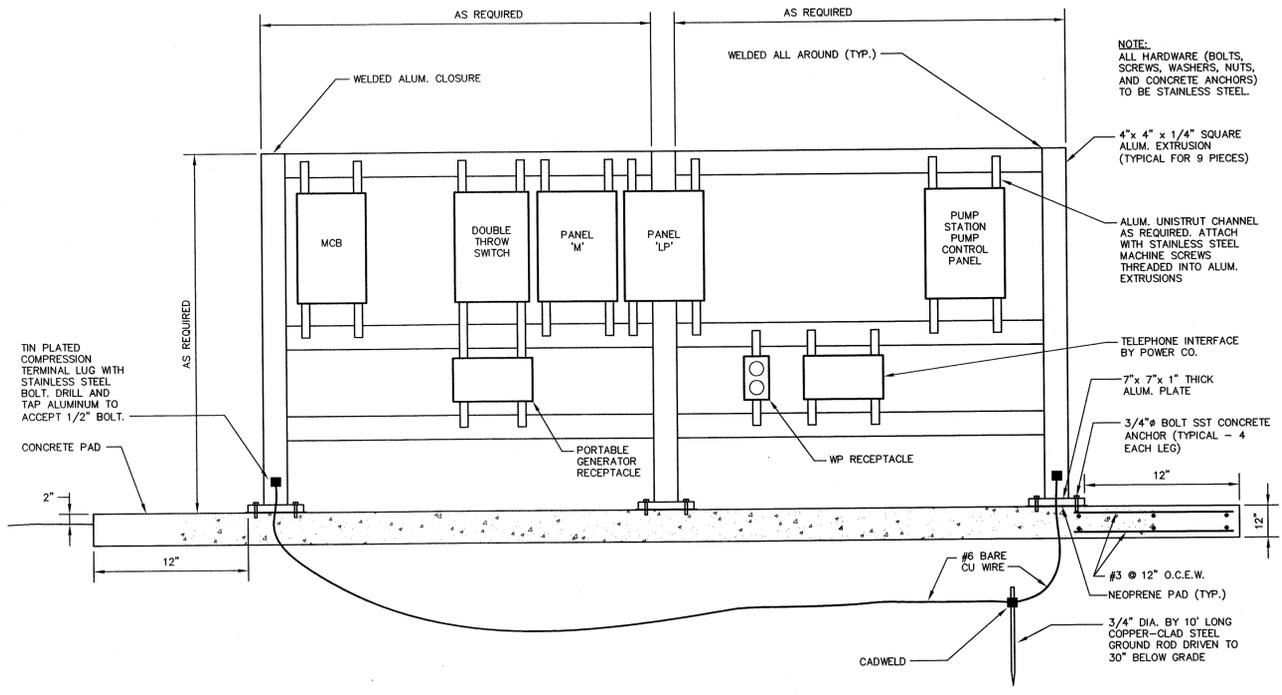


**ELECTRICAL EQUIPMENT RACK DETAIL**  
NOT TO SCALE

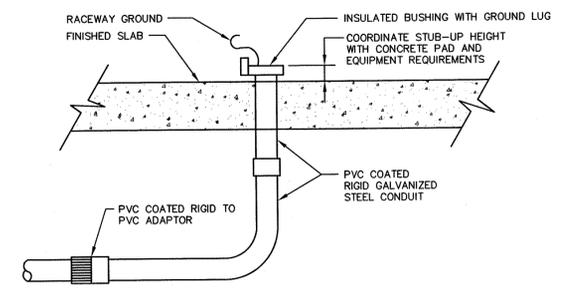


**TYPICAL CONDUIT STUB-UP**  
NOT TO SCALE

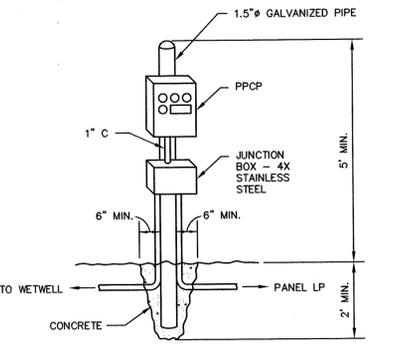


**TYPICAL POST DETAIL FOR PISTON PUMP CONTROL PANEL**  
NOT TO SCALE

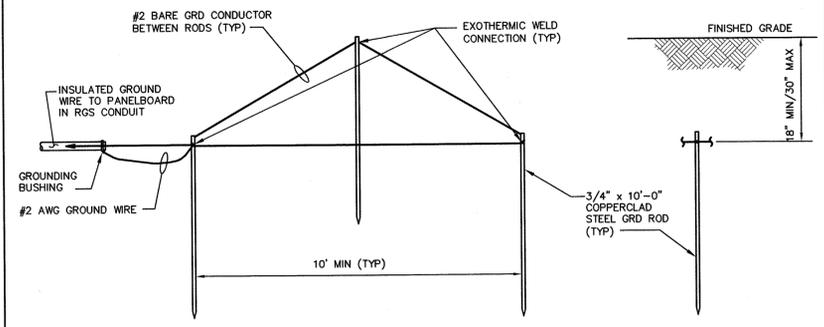

**GROUNDING COUNTERPOISE DETAIL**  
NOT TO SCALE

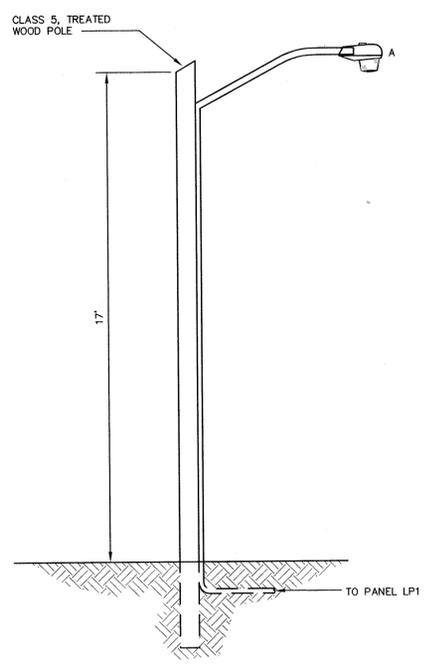

**LIGHTING POLE DETAIL**  
NOT TO SCALE

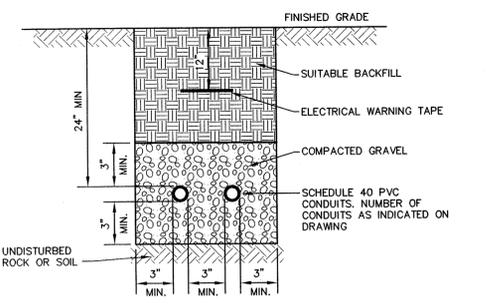

**TYPICAL SITE ELECTRICAL TRENCH DETAIL**  
NOT TO SCALE

**McGill**  
A SOCIATES  
ENGINEERING · PLANNING · FINANCE  
55 BROAD STREET ASHEVILLE, NC 28801 PH: (828) 252-0575 FAX: (828) 252-0575

FRANCIS FARM LANDFILL  
LANDFILL GAS COLLECTION & COMBUSTION SYSTEM  
PHASES 1-3  
**HAYWOOD COUNTY**  
HAYWOOD COUNTY, NORTH CAROLINA

JOB NO.: 09.00721  
DATE: NOVEMBER 2009  
DESIGNED BY: DLG  
CADD BY: SAR  
DESIGN REVIEW: PAF  
CONST. REVIEW:  
FILE NAME:  
RD - 09.00721-E-501.dwg

**ELECTRICAL DETAILS**

**SHEET**  
**E-501**


**RECORD DRAWING**

This Drawing has been modified to reflect changes made during construction based upon information provided by the Contractor and construction observations made by the Owner's Authorized Representative.


By *Philip A. Fisher* Date *7.23.12*



C:\2009\09.00721\Design\Electrical Drawings\RD - 09.00721-E-501.dwg 4/12/2012 10:23 AM SCNUA ROBERT'S

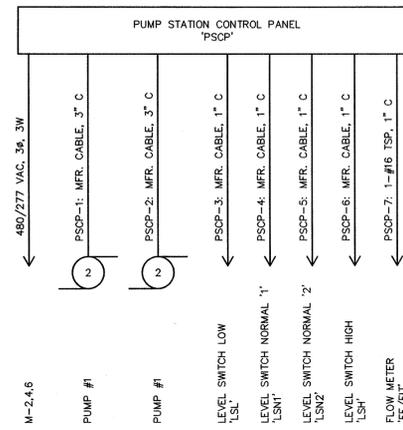


**PUMP STATION CONTROL PANEL ONE-LINE**  
NOT TO SCALE

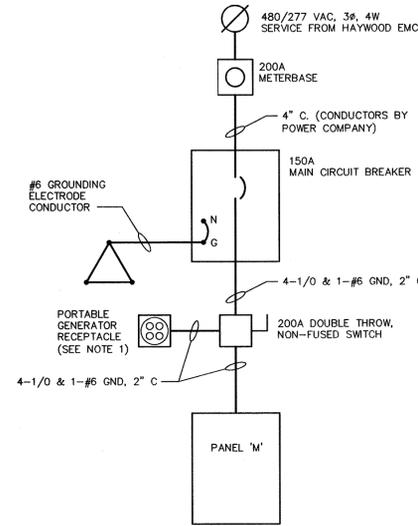

NOTES:  
1. PROVIDE A 200A, 480 VAC, 3φ, 4W, PIN AND SLEEVE PORTABLE GENERATOR RECEPTACLE WITH REVERSE POLARITY.

**POWER ONE-LINE**  
NOT TO SCALE

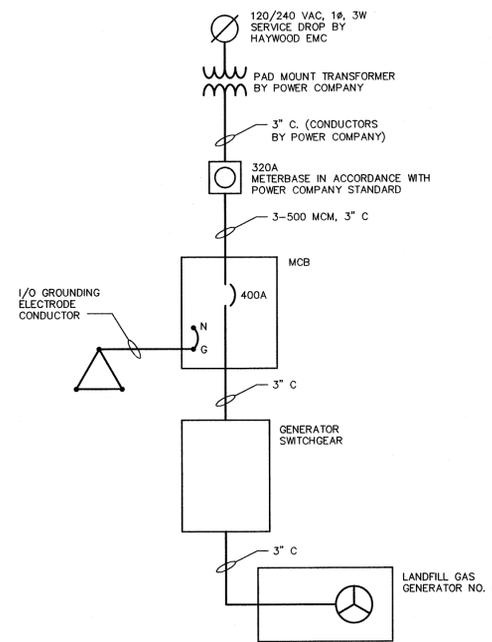

**LANDFILL GAS GENERATOR POWER ONE-LINE**  
NOT TO SCALE

PANEL LP		BUS AMP	MIN. A.I.C.	MAIN BREAKER																	
MOUNTING SURFACE		100A	10,000	60A																	
LOCATION ELECTRICAL RACK		PHASE 1	WIRE 3	VOLTAGE 120/240																	
		NEMA TYPE 4X	NOTE: PROVIDE WITH INTEGRAL 10 KVA TRANSFORMER																		
CKT	DESCRIPTION	BREAKER AMP	LOAD (KW)	WIRE SIZE	GND. SIZE	COND. SIZE	DESCRIPTION	CKT													
1	GENERATOR HEATER	20	1.2	2	12	12	3/4	3/4	12	12	2	0.18	1	20						RACK RECEPTACLES	2
3	GEN. BATTERY CHARGER	20	1	2	12	12	3/4	3/4	12	12	2	0.37	1	20						AREA LIGHTING	4
5	SPARE	20	1	-				3/4	12	12	2	0.2	1	20						FE/FIT	6
7	SPARE	20	1	-									1	20						SPARE	8
9	SPARE	20	1	-									1	20						SPARE	10
SUB-TOTAL LOAD KW			1.2	0.6										0.38	0.37						
TOTAL LOAD KW														1.58	0.97						

PANEL M		BUS AMP	MIN. A.I.C.	MAIN BREAKER																	
MOUNTING SURFACE		225A	10,000	150A																	
LOCATION FLARE STATION SITE		PHASE 3	WIRE 4	VOLTAGE 480V																	
		NEMA TYPE 3R	NOTE: PROVIDE PANELBOARD WITH INTEGRAL SPD.																		
CKT	DESCRIPTION	BREAKER AMP	LOAD (KW)	WIRE SIZE	GND. SIZE	COND. SIZE	DESCRIPTION	CKT													
1	FLARE STATION CONTROL PANEL	60	3	8.87	3	4	8	1	1	10	10	3	1.77	3	30					PUMP STATION CONTROL PANEL	2
3	FLARE STATION CONTROL PANEL			8.87									1.77							PUMP STATION CONTROL PANEL	4
5	FLARE STATION CONTROL PANEL			8.87									1.77							PUMP STATION CONTROL PANEL	6
7	WELL PUMPS 8, 9, 12	30	3	1.4	3	6	6	2	2	6	6	-	-	3	30					SPARE	8
9	WELL PUMPS 8, 9, 12			1.4									-							SPARE	10
11	WELL PUMPS 8, 9, 12			1.4									-							SPARE	12
13	WELL PUMPS 18,19,20,21	30	3	2.44	3	10	10	1	1	10	10	3	0.55	3	20					CONDENSATE REMOVAL PUMP	14
15	WELL PUMPS 18,19,20,21			2.44									0.55							CONDENSATE REMOVAL PUMP	16
17	WELL PUMPS 18,19,20,21			2.44									0.55							CONDENSATE REMOVAL PUMP	18
19	WELL PUMPS 6,10,11,13,14,16	30	3	2.44	3	10	10	3/4	3/4	10	10	3	1	2	30					PANEL LP	20
21	WELL PUMPS 6,10,11,13,14,16			2.44									1							PANEL LP	22
23	WELL PUMPS 6,10,11,13,14,16			2.44																PANEL LP	24
25																					26
27																					28
29																					30
SUB-TOTAL LOAD KW			15.1	15.1	15.1									3.32	3.32	2.33					
TOTAL LOAD KW														18.5	18.5	17.5					

LIGHTING FIXTURE SCHEDULE							
TYPE	DESCRIPTION	MANUFACTURER AND CATALOG NO.	MOUNTING	VOLTAGE	LAMPS	BALLASTS/ FIXTURE	WATTS/ FIXTURE
A	AREA LUMINAIRE WITH CUTOFF OPTICS UL LISTED FOR USE IN WET LOCATIONS IES DISTRIBUTION TYPE III	GE M2AC 15 S COOPER HPRC FL 3 150 HUBBELL RM SERIES	WOOD POLE (SEE DETAIL ON E-501)	120V	(1) 150W HPS	1	185

**RECORD DRAWING**

This Drawing has been modified to reflect changes made during construction based upon information provided by the Contractor and construction observations made by the Owner's Authorized Representative.

By *Philip A. Fisher* Date *7.23.12*



FRANCIS FARM LANDFILL  
LANDFILL GAS COLLECTION & COMBUSTION SYSTEM  
PHASES 1 - 3  
**HAYWOOD COUNTY**  
HAYWOOD COUNTY, NORTH CAROLINA

JOB NO.: 09.00721  
DATE: NOVEMBER 2009  
DESIGNED BY: DLG  
CADD BY: SAR  
DESIGN REVIEW: PAF  
CONST. REVIEW: PAF  
FILE NAME: RD - 09.00721-E-601.dwg

**SCHEDULES AND ONE-LINES**

**SHEET E-601**