

Mecklenburg Co.

2



6013 2006
Map

NOTES

- REFERENCE IS MADE TO THE FOLLOWING:
- EXISTING CONTOURS BASED ON COMBINED INFORMATION AND B.P. BARBER & ASSOCIATES, INC. SURVEY ON MARCH 7, 2005.
 - GROUNDWATER DATA BASED ON INFORMATION PROVIDED BY ENVIRO-FLO, P.C. AND GRIFFIN BROTHERS DATED SEPTEMBER 2005 AND NOVEMBER 2005.
 - ELEVATIONS BASED ON THE FOLLOWING:
 - DRAWING BY PATTERSON BREWER & ASSOCIATES DATED JANUARY 22, 2001.
 - TRANSFERRED BENCHMARK FROM NCSS MONUMENT "JOLLY" BY PATTERSON BREWER & ASSOCIATES.

LEGEND

- EXISTING**
- CONTOURS (2')
 - CONTOURS (10')
 - GROUNDWATER CONTOURS
 - EDGE OF DIRT ROAD
 - EDGE OF PAVEMENT
 - PROPERTY LINE
 - IRON PIN FOUND
 - POWER POLE
 - GROUNDWATER MONITORING WELL
 - OUTLET STRUCTURE

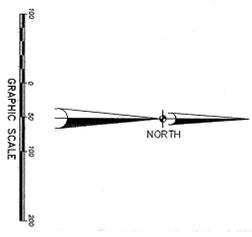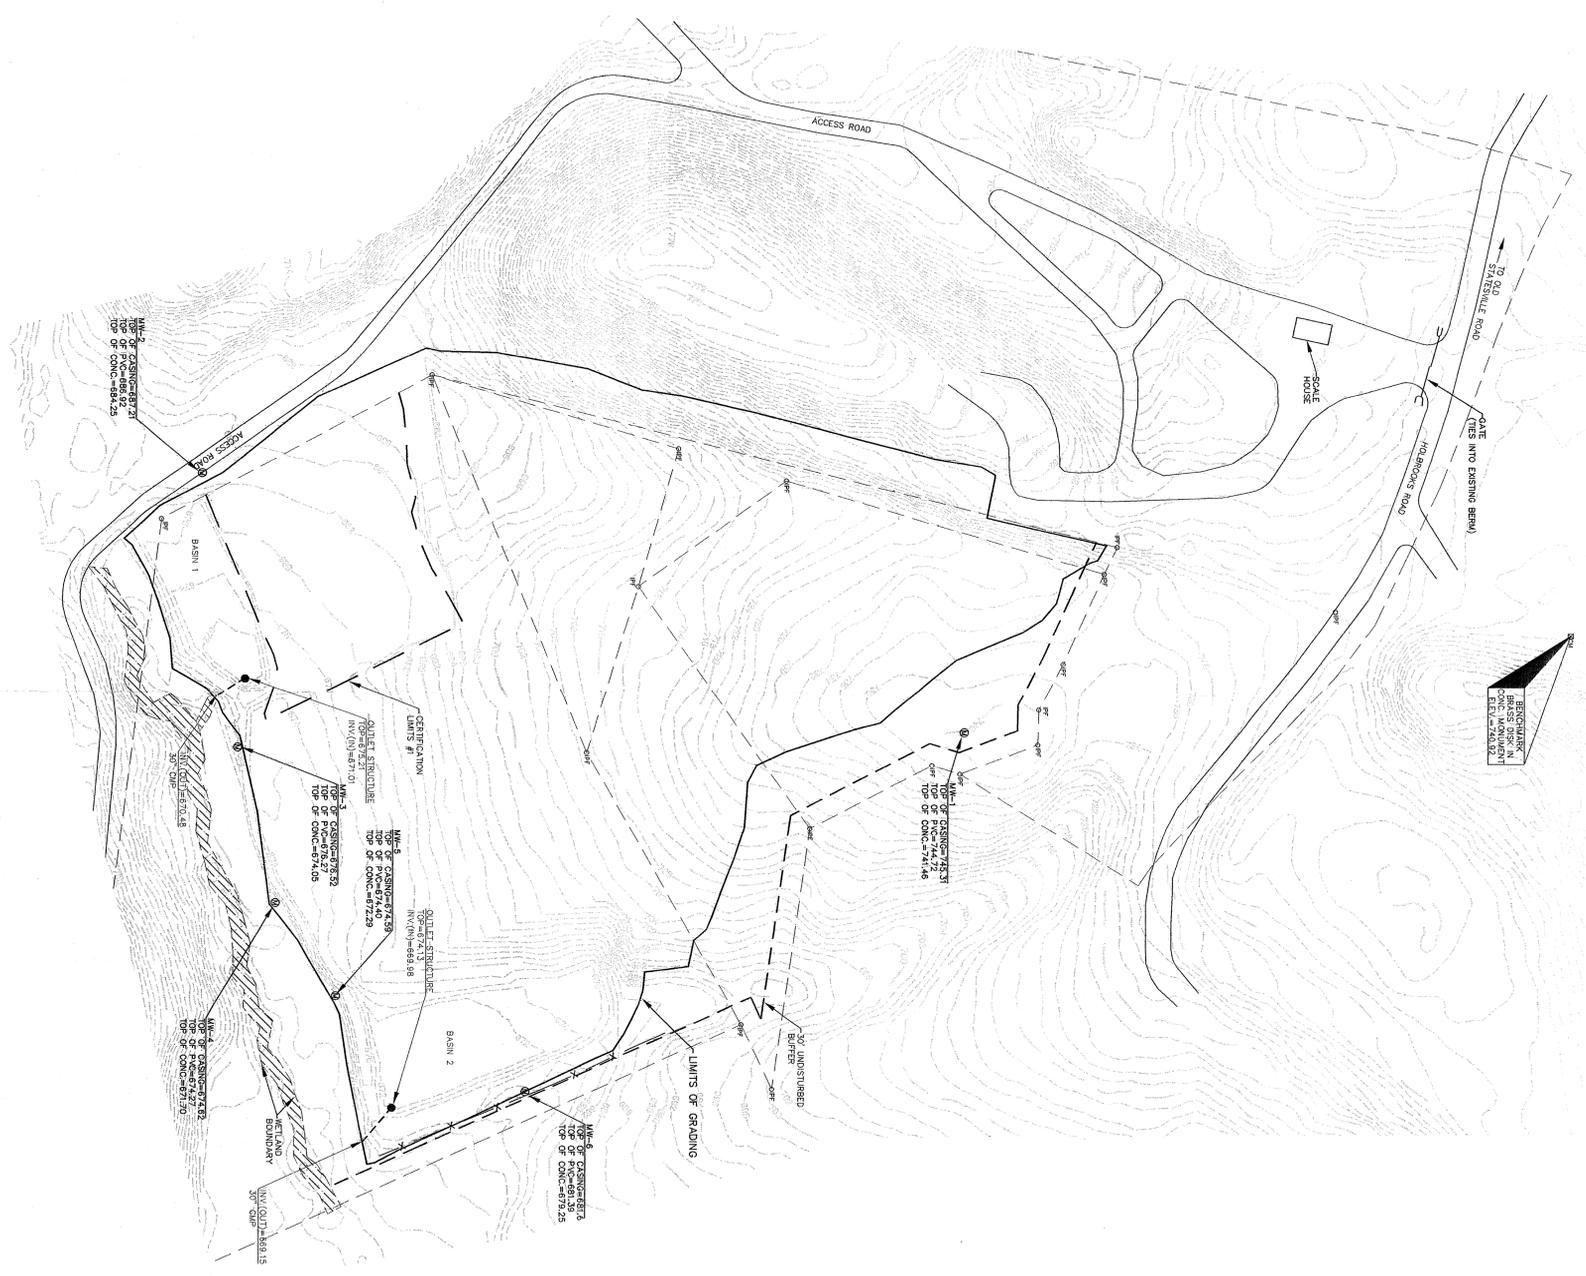

I HEREBY CERTIFY THAT THIS PLAN WAS DRAWN UNDER MY CLOSE PERSONAL SUPERVISION AND THAT I AM A LICENSED PROFESSIONAL ENGINEER IN THE STATE OF NORTH CAROLINA. I AM NOT PROVIDING ANY PROFESSIONAL SERVICES UNDER THIS PLAN.

[Signature]
 A.P. BARBER, INC.
 03/08/2006

<p>PROJECT NORTH MECKLENBURG C&D LANDFILL EXPANSION II FOR NORTH MECKLENBURG LANDFILL, INC. MECKLENBURG COUNTY NORTH CAROLINA</p>		<p>SHEET TITLE PHASE 1A BASE GRADING RECORD DRAWING</p>		<p>bpb B. P. BARBER & ASSOCIATES, INC. ENGINEERS - PLANNERS - SURVEYORS COLUMBIA • SPARTANBURG • CHARLESTON FLORENCE • CHARLOTTE • SAVANNAH</p>		<p>APPROVALS</p> <table border="1"> <tr> <td>PROJECT ENG:</td> <td>FWS</td> </tr> <tr> <td>DESIGNED BY:</td> <td>DWT</td> </tr> <tr> <td>DRAWN BY:</td> <td>CBB</td> </tr> <tr> <td>CHECKED BY:</td> <td>DWT</td> </tr> <tr> <td>APPROVED:</td> <td>FWS</td> </tr> </table>		PROJECT ENG:	FWS	DESIGNED BY:	DWT	DRAWN BY:	CBB	CHECKED BY:	DWT	APPROVED:	FWS	<p>REVISIONS</p> <table border="1"> <thead> <tr> <th>NO.</th> <th>DESCRIPTION</th> <th>DATE</th> <th>BY</th> </tr> </thead> <tbody> <tr> <td> </td> <td> </td> <td> </td> <td> </td> </tr> <tr> <td> </td> <td> </td> <td> </td> <td> </td> </tr> <tr> <td> </td> <td> </td> <td> </td> <td> </td> </tr> <tr> <td> </td> <td> </td> <td> </td> <td> </td> </tr> </tbody> </table>		NO.	DESCRIPTION	DATE	BY																
PROJECT ENG:	FWS																																						
DESIGNED BY:	DWT																																						
DRAWN BY:	CBB																																						
CHECKED BY:	DWT																																						
APPROVED:	FWS																																						
NO.	DESCRIPTION	DATE	BY																																				
<p>DATE: MARCH 2006 SCALE: 1" = 100'</p>		<p>SIGNATURE</p>		<p>DATE</p>		<p>FILE NO. 33,408-B79</p>																																	