Attachment B - Load Out Area and Cross Sections

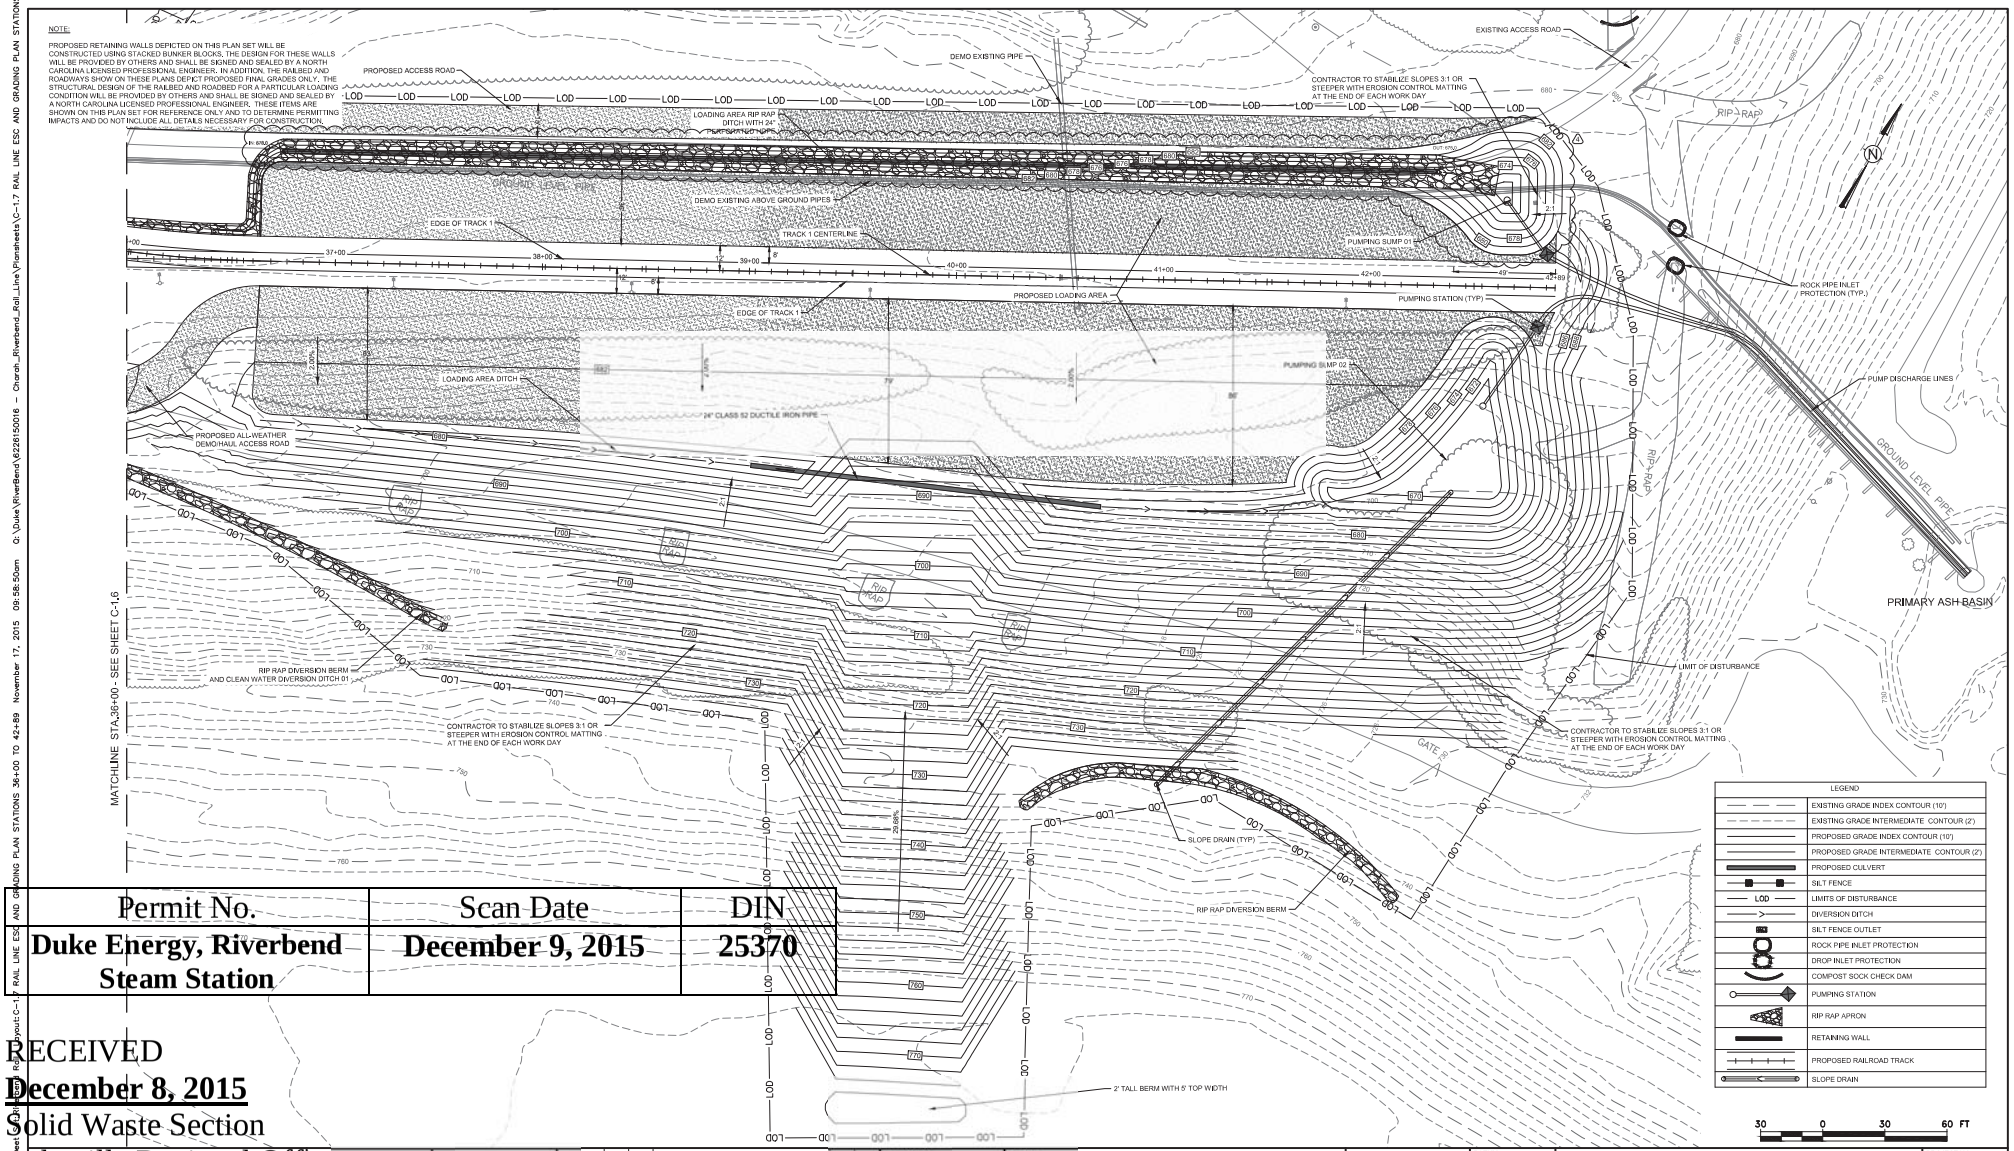

Permit No.	Scan Date	DIN
Duke Energy, Riverbend Steam Station	**December 9, 2015**	**25370**

RECEIVED
December 8, 2015
Solid Waste Section
Asheville Regional Office

REV	D	M	Y	ISSUE/REVISION DESCRIPTION	ENG.	APPR.
4	16	11	2015	REVISIONS/AS-BUILT DATA PER CHARAH	RLH	CNB
3	21	10	2015	NCDER MINOR MODIFICATION	RLH	CNB

CLIENT LOGO: Charah, 12601 PLANTSIDE DRIVE LOUISVILLE, KY 40299 PHONE: (502)245-1353

CLIENT: DUKE ENERGY CAROLINAS LLC. MOUNT HOLLY, NC

Amec Foster Wheeler Environment & Infrastructure, Inc.
2801 YORKMONT ROAD, SUITE 100
CHARLOTTE, NC 28208
TEL: (704) 357-8600 FAX: (704) 357-8638
LICENSURE: NC ENG: F-1253 NC GEOLOGY: C-247

DATUM: NAD83
PROJECTION: -
DRAWN BY: CNB
REVIEWED BY: RH
SCALE: AS NOTED

PROJECT: RIVERBEND STEAM STATION RAIL LINE IMPROVEMENTS

TITLE: RAIL LINE ESC AND GRADING PLAN STATIONS 36+00 TO 42+89

PROJECT NO.: 6226-15-0016
REVISION NO. 4
DATE: 05/14/2015
DRAWING NO. C-1.7

Plotted By:Brown, Chad Layout:C-1.7 RAIL LINE ESC AND GRADING PLAN STATIONS 36+00 TO 42+89 November 17, 2015 09:58:50am Q:\Duke\RiverBend\6226150016 - Charah_Riverbend_Rail_Line\Plansheets\C-1.7 RAIL LINE ESC AND GRADING PLAN STATIONS 36+00