4

North Carolina - Department of Environment, Health, and Natural Resources
Division of Environmental Management - Groundwater Section
P.O. Box 29535 - Raleigh, N.C. 27626-0535
Phone (919) 733-3221

FOR OFFICE USE ONLY	
QUAD. NO.	SERIAL NO. 14587
Lat	Long. RO
Minor Basin	
Basin Code	
Header Ent.	GW-1 Ent.

WELL CONSTRUCTION RECORD

DRILLING CONTRACTOR: S AND Acco

DRILLER REGISTRATION NUMBER: 1021 #

STATE WELL CONSTRUCTION PERMIT NUMBER:

1. WELL LOCATION: (Show sketch of the location below)
Nearest Town: Greensboro NC County: Guilford
(Road, Community, or Subdivision and Lot No.)

2. OWNER Draper Inc
ADDRESS 5644 Hornaday
(Street or Route No.)
Greensboro, N.C. 27406
City or Town State Zip Code

3. DATE DRILLED ~~7-26-93~~ 4-30-93 USE OF WELL Monitor
4. TOTAL DEPTH 39.5
5. CUTTINGS COLLECTED YES ☐ NO ☐
6. DOES WELL REPLACE EXISTING WELL? YES ☐ NO ☒
7. STATIC WATER LEVEL Below Top of Casing: _____ FT.
(Use "+" if Above Top of Casing)
8. TOP OF CASING IS 0 FT. Above Land Surface*
* Casing Terminated at/or below land surface is illegal unless a variance is issued in accordance with 15A NCAC 2C .0118
9. YIELD (gpm): _____ METHOD OF TEST _____
10. WATER ZONES (depth): _____

DEPTH From	DEPTH To	DRILLING LOG Formation Description
0	15'	TAN SAND With SOME CLAY
15'	39.5'	TAN Silty SAND With TRACES of CLAY

If additional space is needed use back of form

11. CHLORINATION: Type _____ Amount _____
12. CASING:

	Depth From	To	Diameter	Wall Thickness or Weight/Ft.	Material
	0	19.5' Ft.	2"		PVC
		Ft.			
		Ft.			

13. GROUT:

	Depth From	To	Material	Method
	15.5'	0 Ft.	Portland	
		Ft.		

14. SCREEN:

	Depth From	To	Diameter	Slot Size	Material
	19.5	39.5 Ft	2" in.	in.	PVC
		Ft.	in.	in.	
		Ft.	in.	in.	

15. SAND/GRAVEL PACK:

	Depth From	To	Size	Material
	39.5	17.5 Ft.		
		Ft.		

16. REMARKS: _____

LOCATION SKETCH
(Show direction and distance from at least two State Roads, or other map reference points)

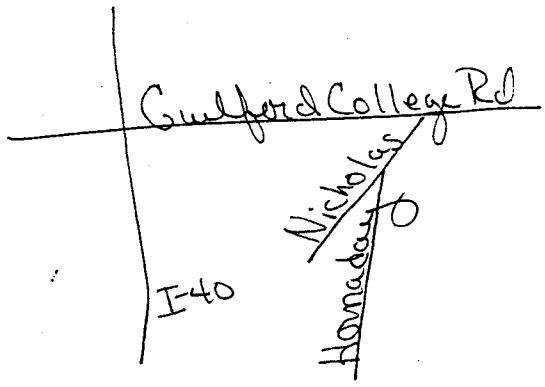

I DO HEREBY CERTIFY THAT THIS WELL WAS CONSTRUCTED IN ACCORDANCE WITH 15A NCAC 2C, WELL CONSTRUCTION STANDARDS, AND THAT A COPY OF THIS RECORD HAS BEEN PROVIDED TO THE WELL OWNER.

SIGNATURE OF CONTRACTOR OR AGENT — DATE 4/30/93

Submit original to Division of Environmental Management and copy to well owner.

GW-1 REV. 9/91

RECEIVED AUG 27 1993 GROUNDWATER SECTION RALEIGH, NC

TEC-001