N.C. DEPARTMENT OF HEALTH, ENVIRONMENT AND NATURAL RESOURCES
Ground Water Section

Telephone Log

Date: ____/____/____ Sheet 1 of 1

Time: ____:____ am ____ Call: Placed ____

pm ____ Received ____

Returned ____

Project: Food Rite

County: Gu.

Conversation with: Mr. ~~Marvin~~ Maynard

Telephone: 373/8755/____

Affiliation: owner of shopping center

Discussion: Well behind Royal Style Center abandoned. New well dug behind Drug Rite (see map). Well at Drug Rite was installed by Built-Rite. Well is 220' deep w/ 83' casing; 80 gals/min flow; water bearing zones from 115'-130'. He is owner of UST's installed 5 yrs ago in front of Food Rite. Food Rite is served by a different well.

Sampled both wells - results attached. Ken Rudo says no health hazard, no further sampling warranted per telecon.

cc: Climax General Store Filed by: K. Gage

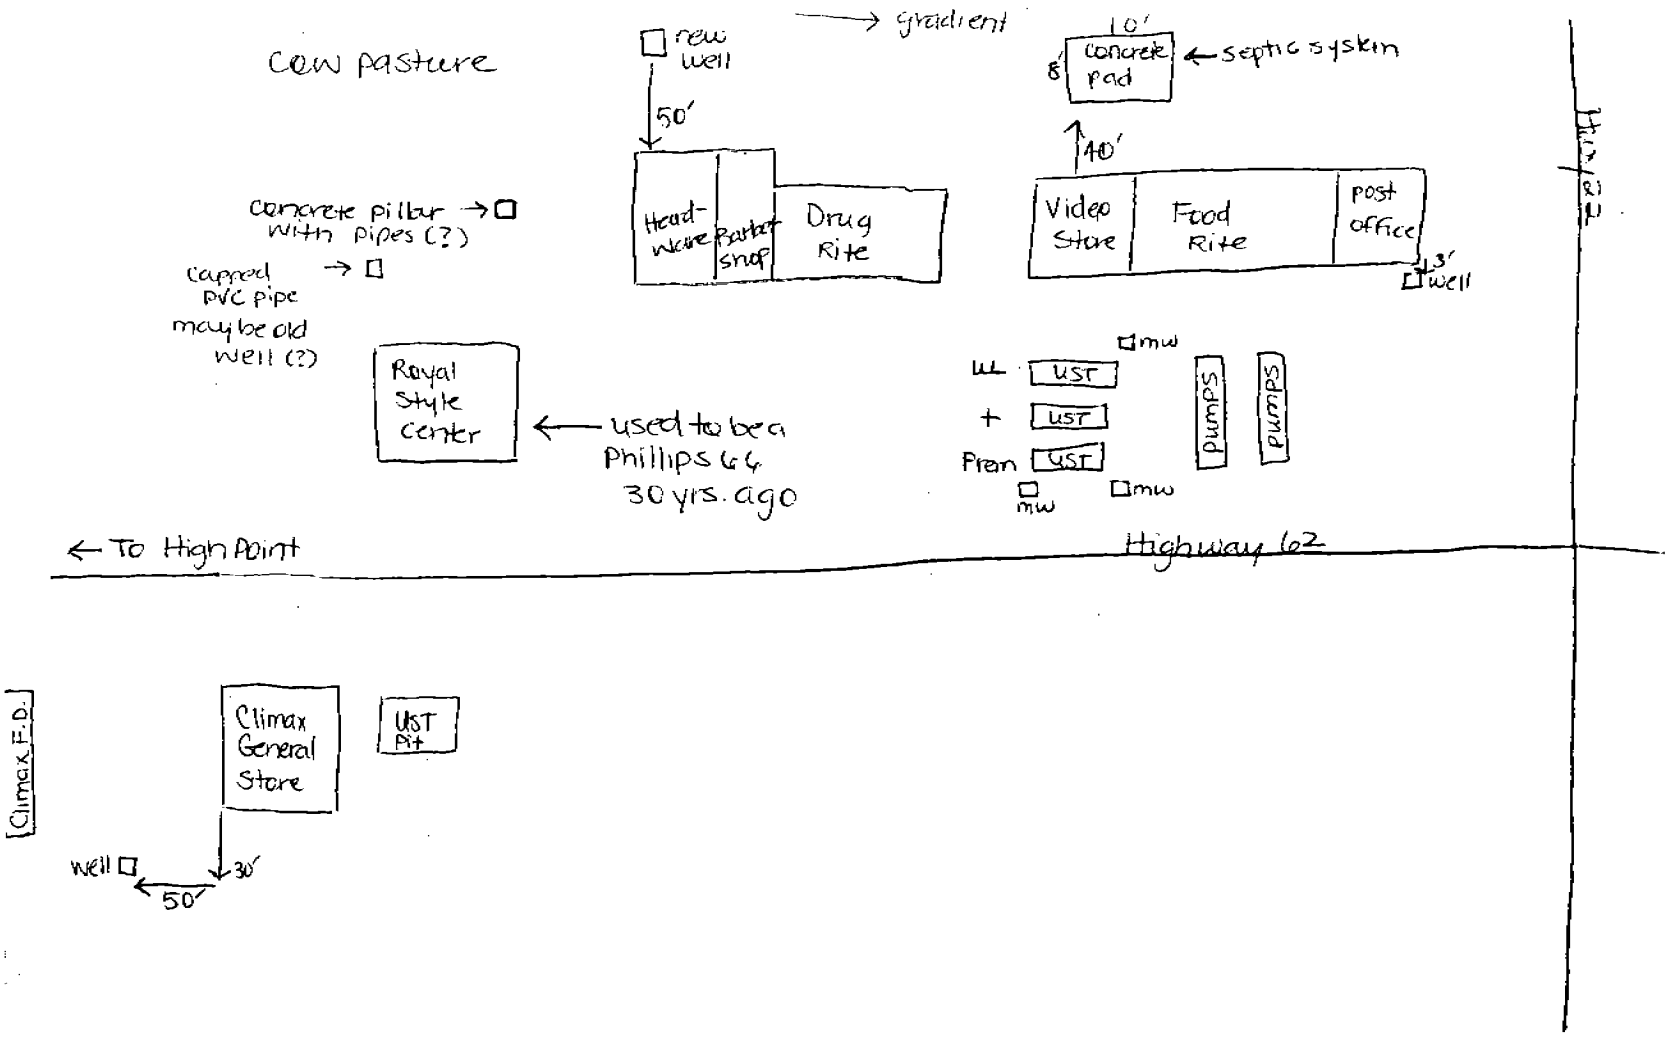

Cow pasture
new well
50'
gradient
10'
8'
concrete pad
septic system
40'
Hardware
Barber shop
Drug Rite
Video Store
Food Rite
post office
3'
well
concrete pillar with pipes (?)
capped PVC pipe
may be old well (?)
Royal Style center
used to be a Phillips 66 30 yrs. ago
mw
UST
UST
UST
Prem
mw
mw
pumps
pumps
To High Point
Highway 62
Climax F.D.
Climax General Store
UST Pit
well
30'
50'

N.C. DEPARTMENT OF HEALTH, ENVIRONMENT AND NATURAL RESOURCES
Ground Water Section

Telephone Log

Date: ____/____/____ Sheet 1 of 1

Time: ____:____ am ____ Call: Placed ✓

pm ____ Received ____

Returned ____

Project: Climax General Store

County: Gu

Conversation with: Ken Carter

Telephone: 373/27613/____

Affiliation: Health Dept.

Discussion:

Store has 180' deep well w/ 91' of casing flow 20 gal/min. Water bearing zone from 120'-147'.

cc: Food Rite/Drug Rite

Filed by: K. Gage