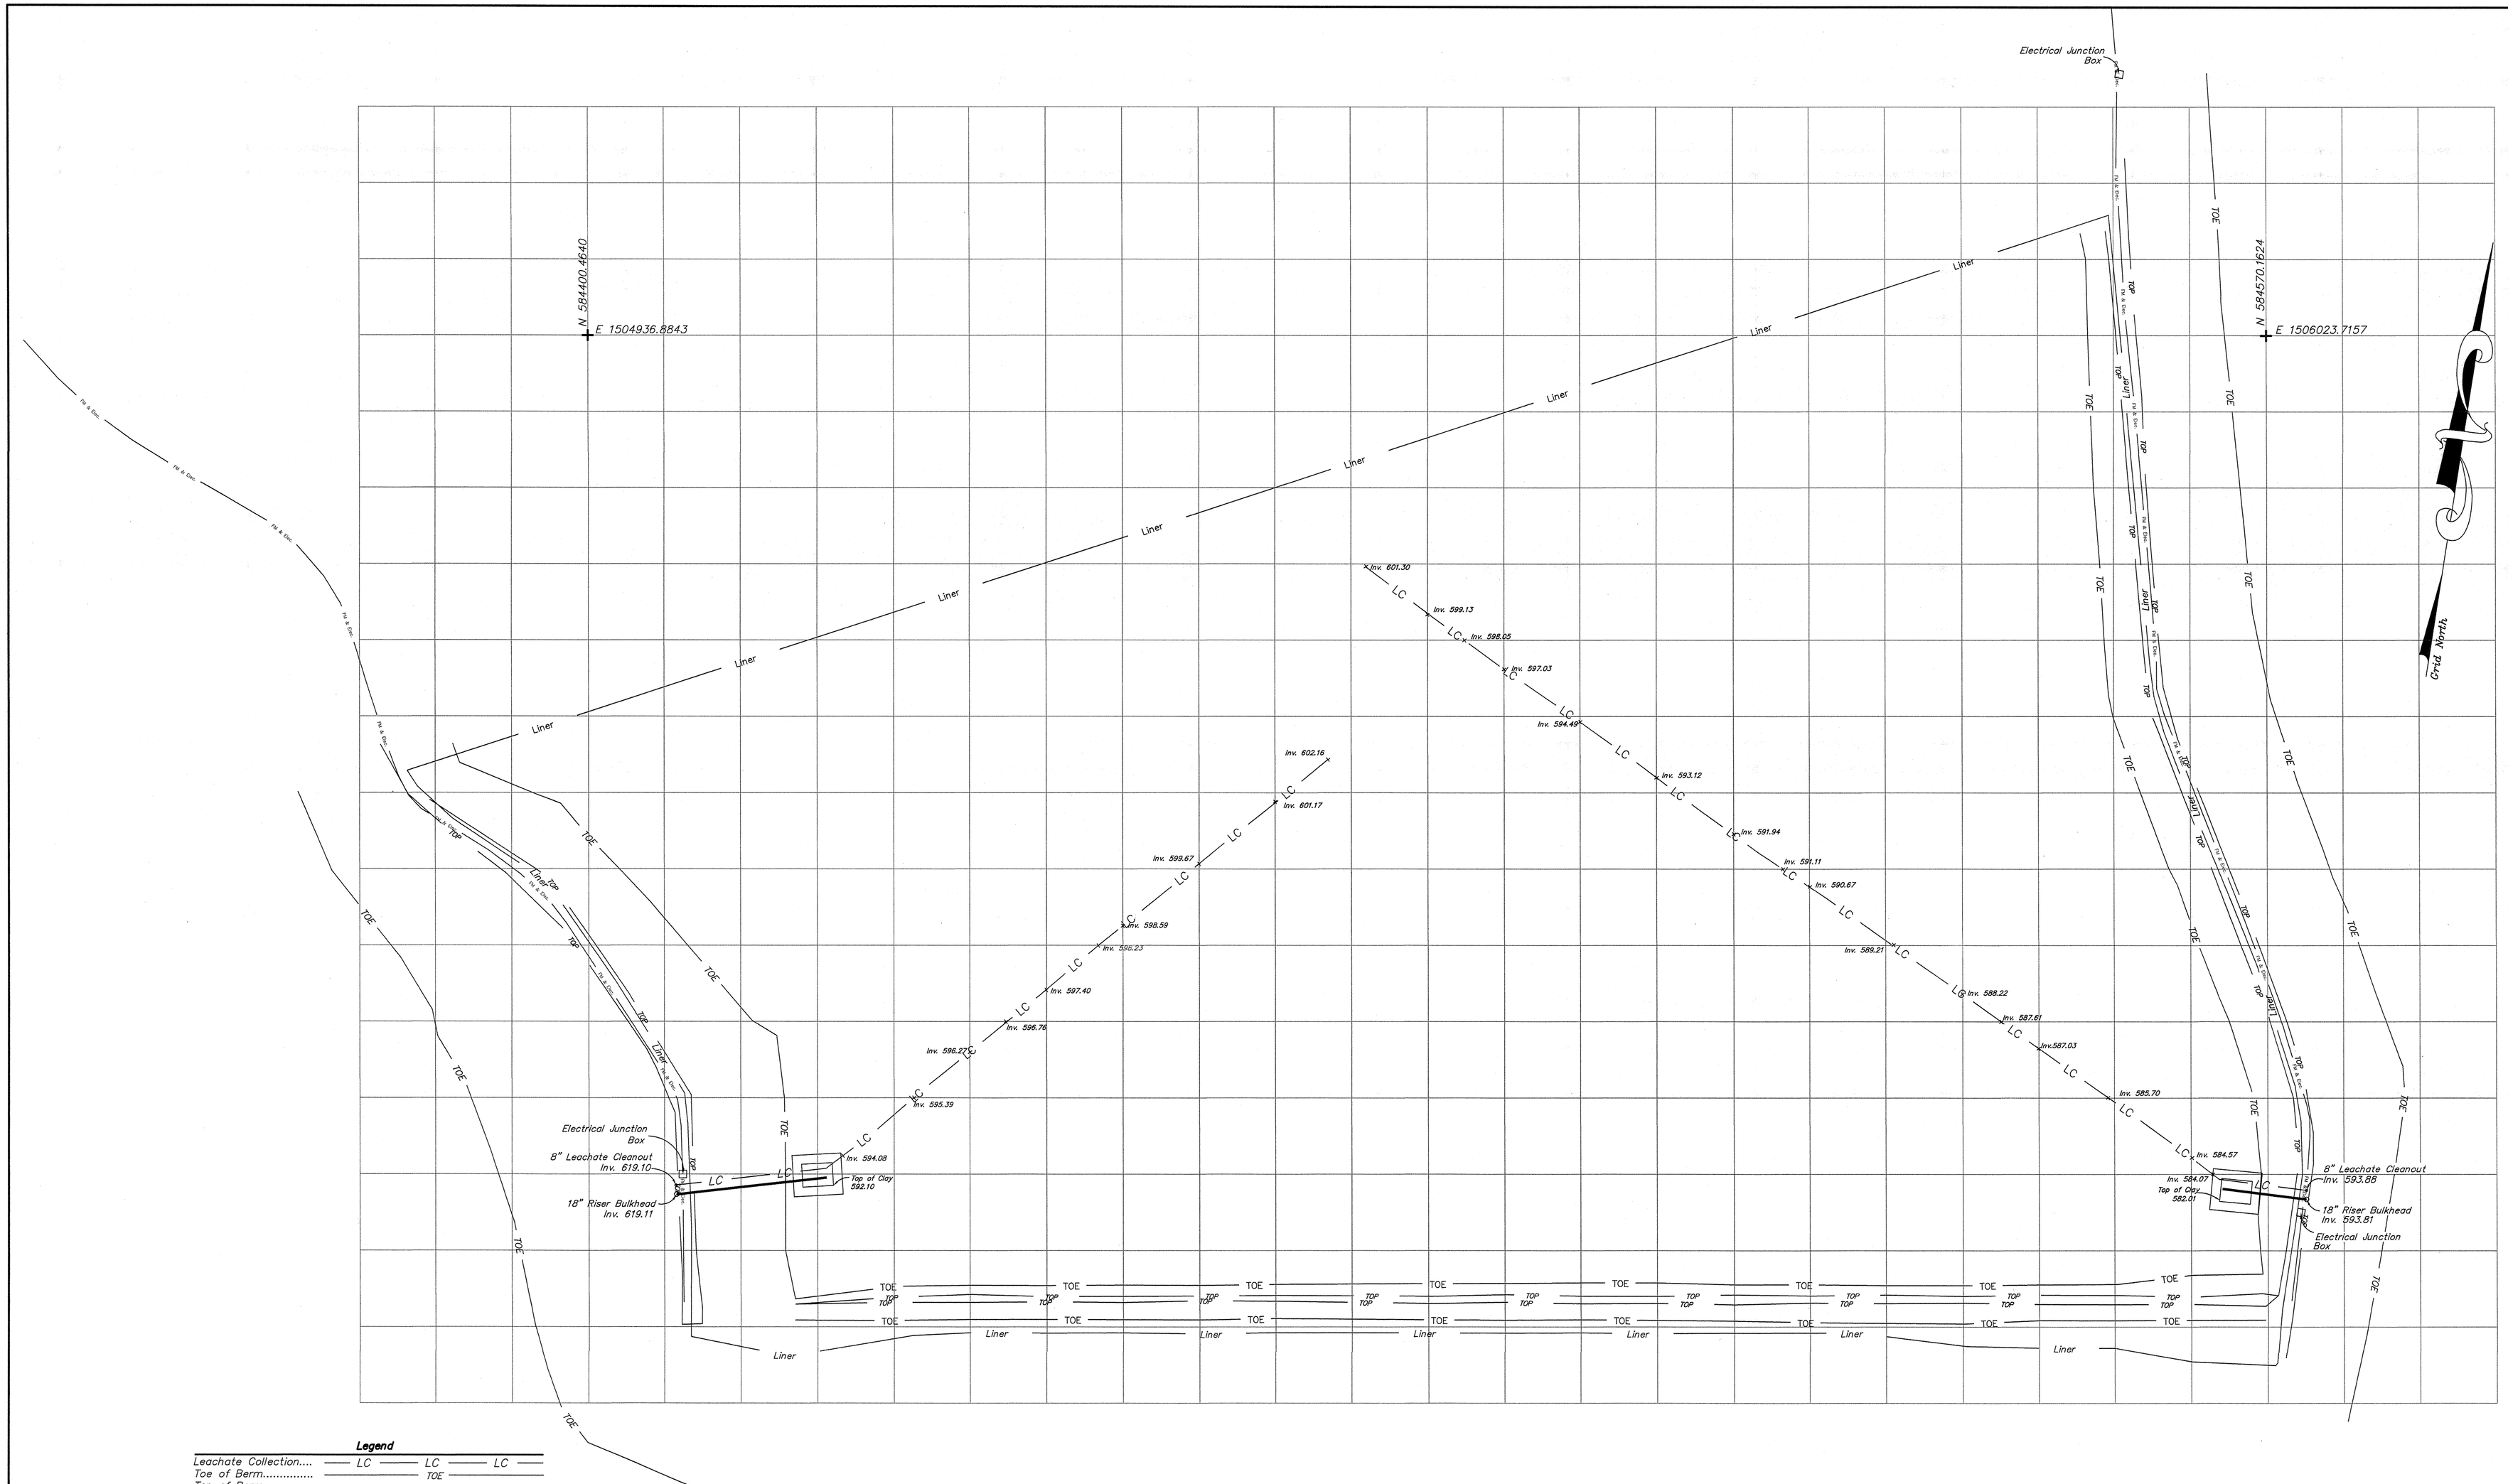

Legend

Leachate Collection....	LC
Toe of Berm.....	TOE
Top of Berm.....	TOP
Force Main & Electrical....	Fm & Elec.
Edge of Liner.....	Liner

NORTH CAROLINA PROFESSIONAL SEAL L-1290 LAND SURVEYOR R. DONALD LAWRENCE

12-01-09

GRAPHIC SCALE

50 0 25 50 100 200

(IN FEET)
1 inch = 50 ft.

FDL & assoc

Asbuilt Conditions Survey of
CMS Cell 2-H
Cabarrus County — Concord, N.C.
Orig. scale 1"=50'
Date: 11/30/09
Lawrence Associates, P.A.
106 W. Jefferson St.
Monroe, North Carolina 28112 (704) 289-1013

Drawn By: MCM
REVISIONS
12/01/09 MCM

Job No. 0135-2h — Drawing file : 2H-Work-leachate.dwg — Drawing no. 09/137