Cell 2-H

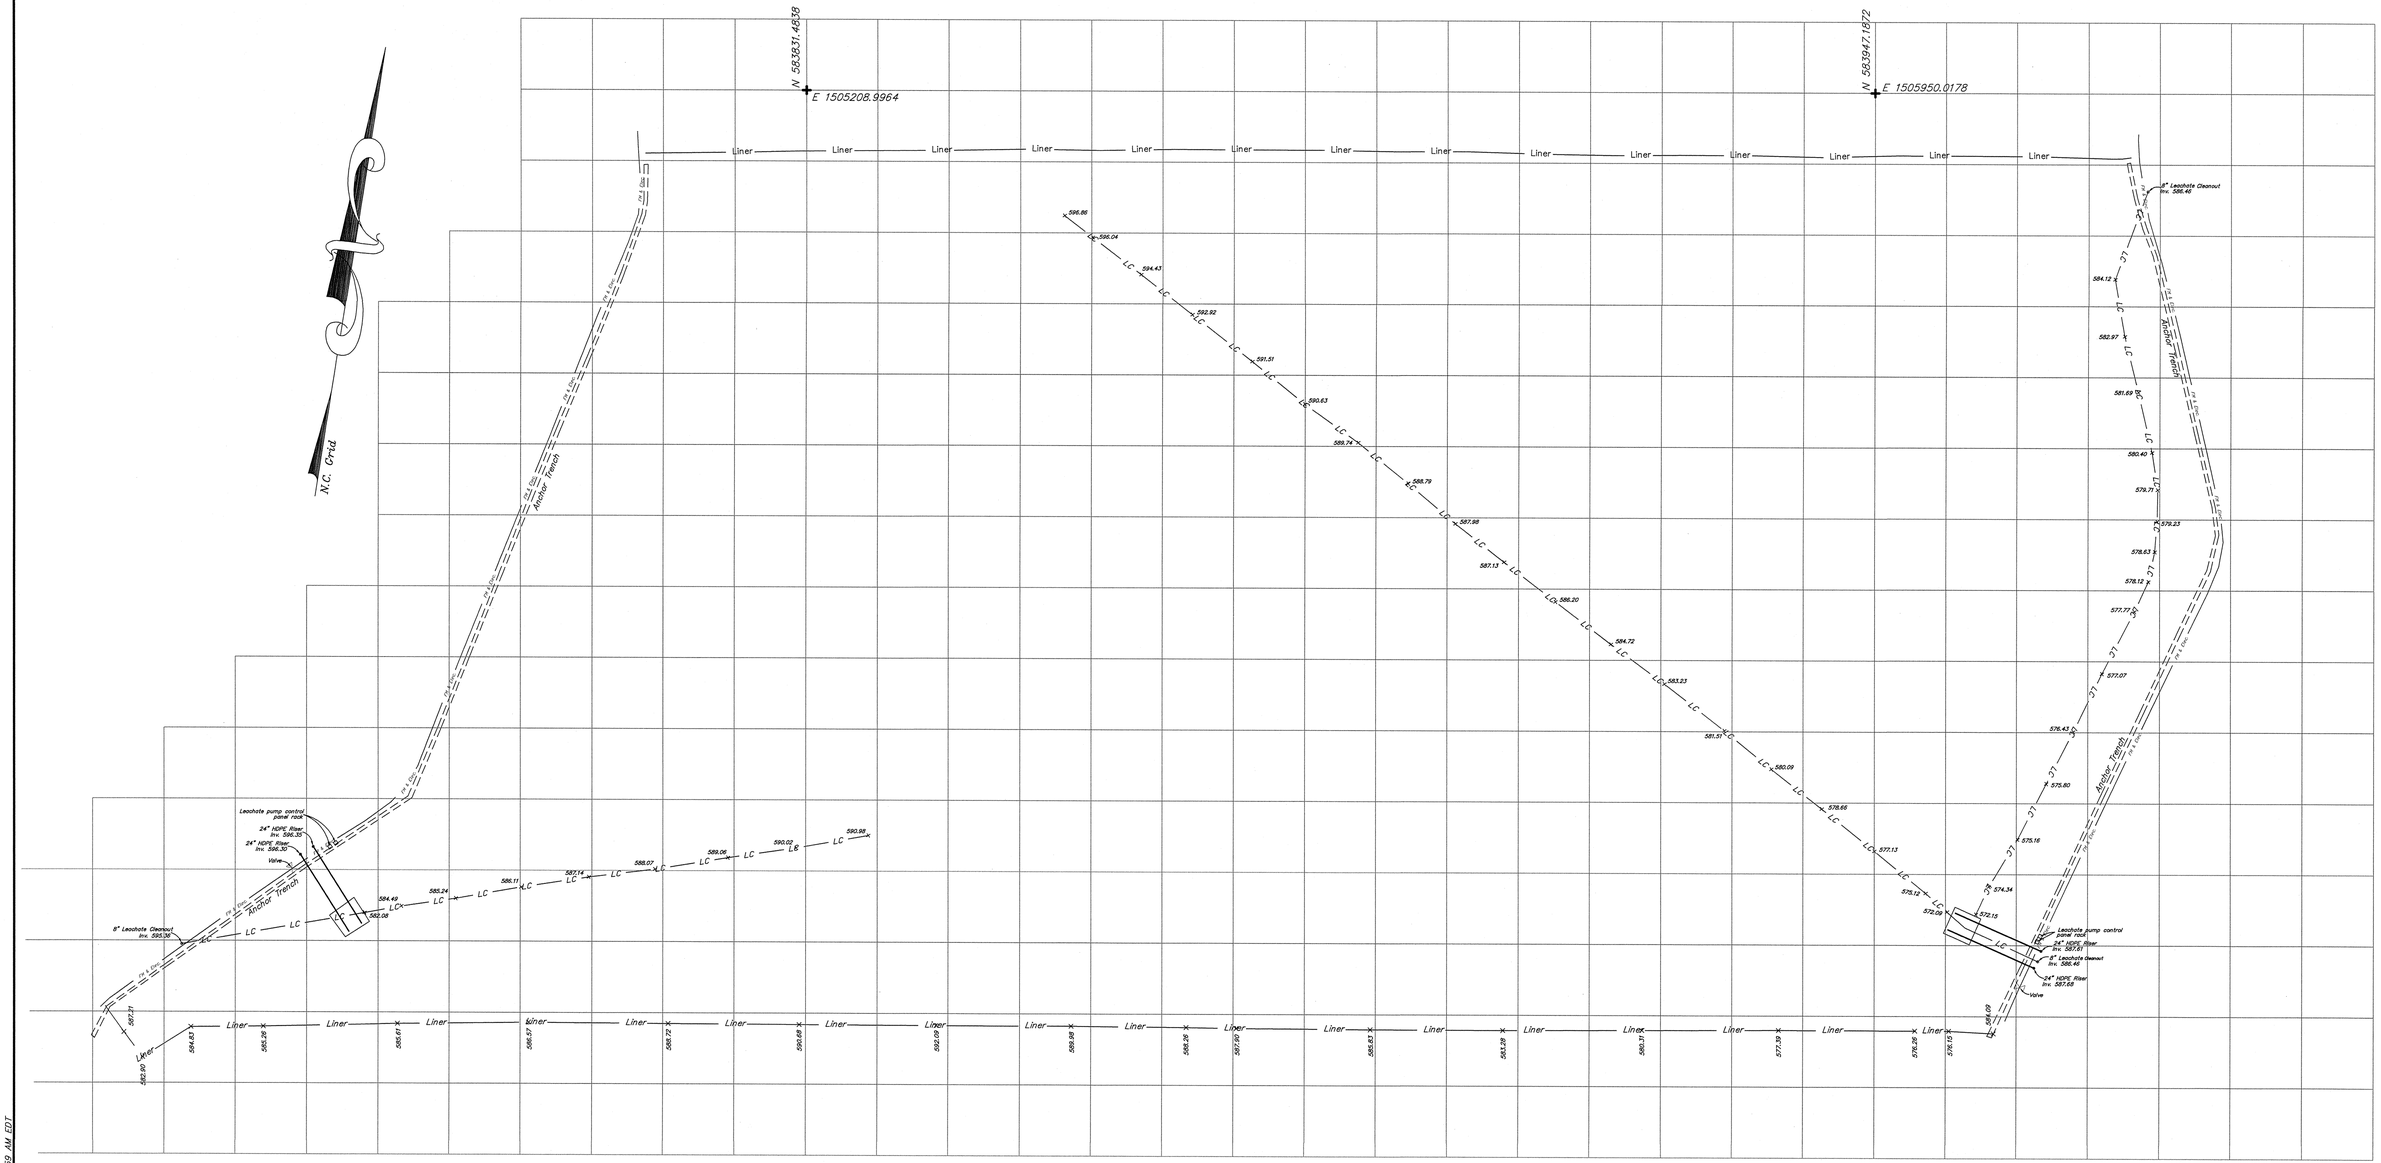

GRAPHIC SCALE

50 0 25 50 100 200

(IN FEET)
1 inch = 50 ft.

NORTH CAROLINA PROFESSIONAL SEAL L-2250 LAND SURVEYOR DONALD LAWRENCE 4-13-11

LAWRENCE ASSOCIATES
106 W. Jefferson St.
Monroe, North Carolina 28112
P 704-289-1013 866-557-8051
F 704-283-9035
www.lawrencesurveying.com

Asbuilt Conditions of
Leachate Collection System
CMS Landfill V Cell 2-I Construction
Cabarrus County, N.C.

Orig. scale: 1" = 50' Date: February 8, 2011 Drawn By: MCM

REVISIONS
MCM 4-12-11
MCM 4-13-11

Job No. 0135-21 Drawing file: Cell 21 Working Surface-Contours.dwg Drawing no. 11/016

C:\proj\0135 - 21\Anchor and Leachate Asbuilt.dwg 4/13/2011 10:17:59 AM EDT