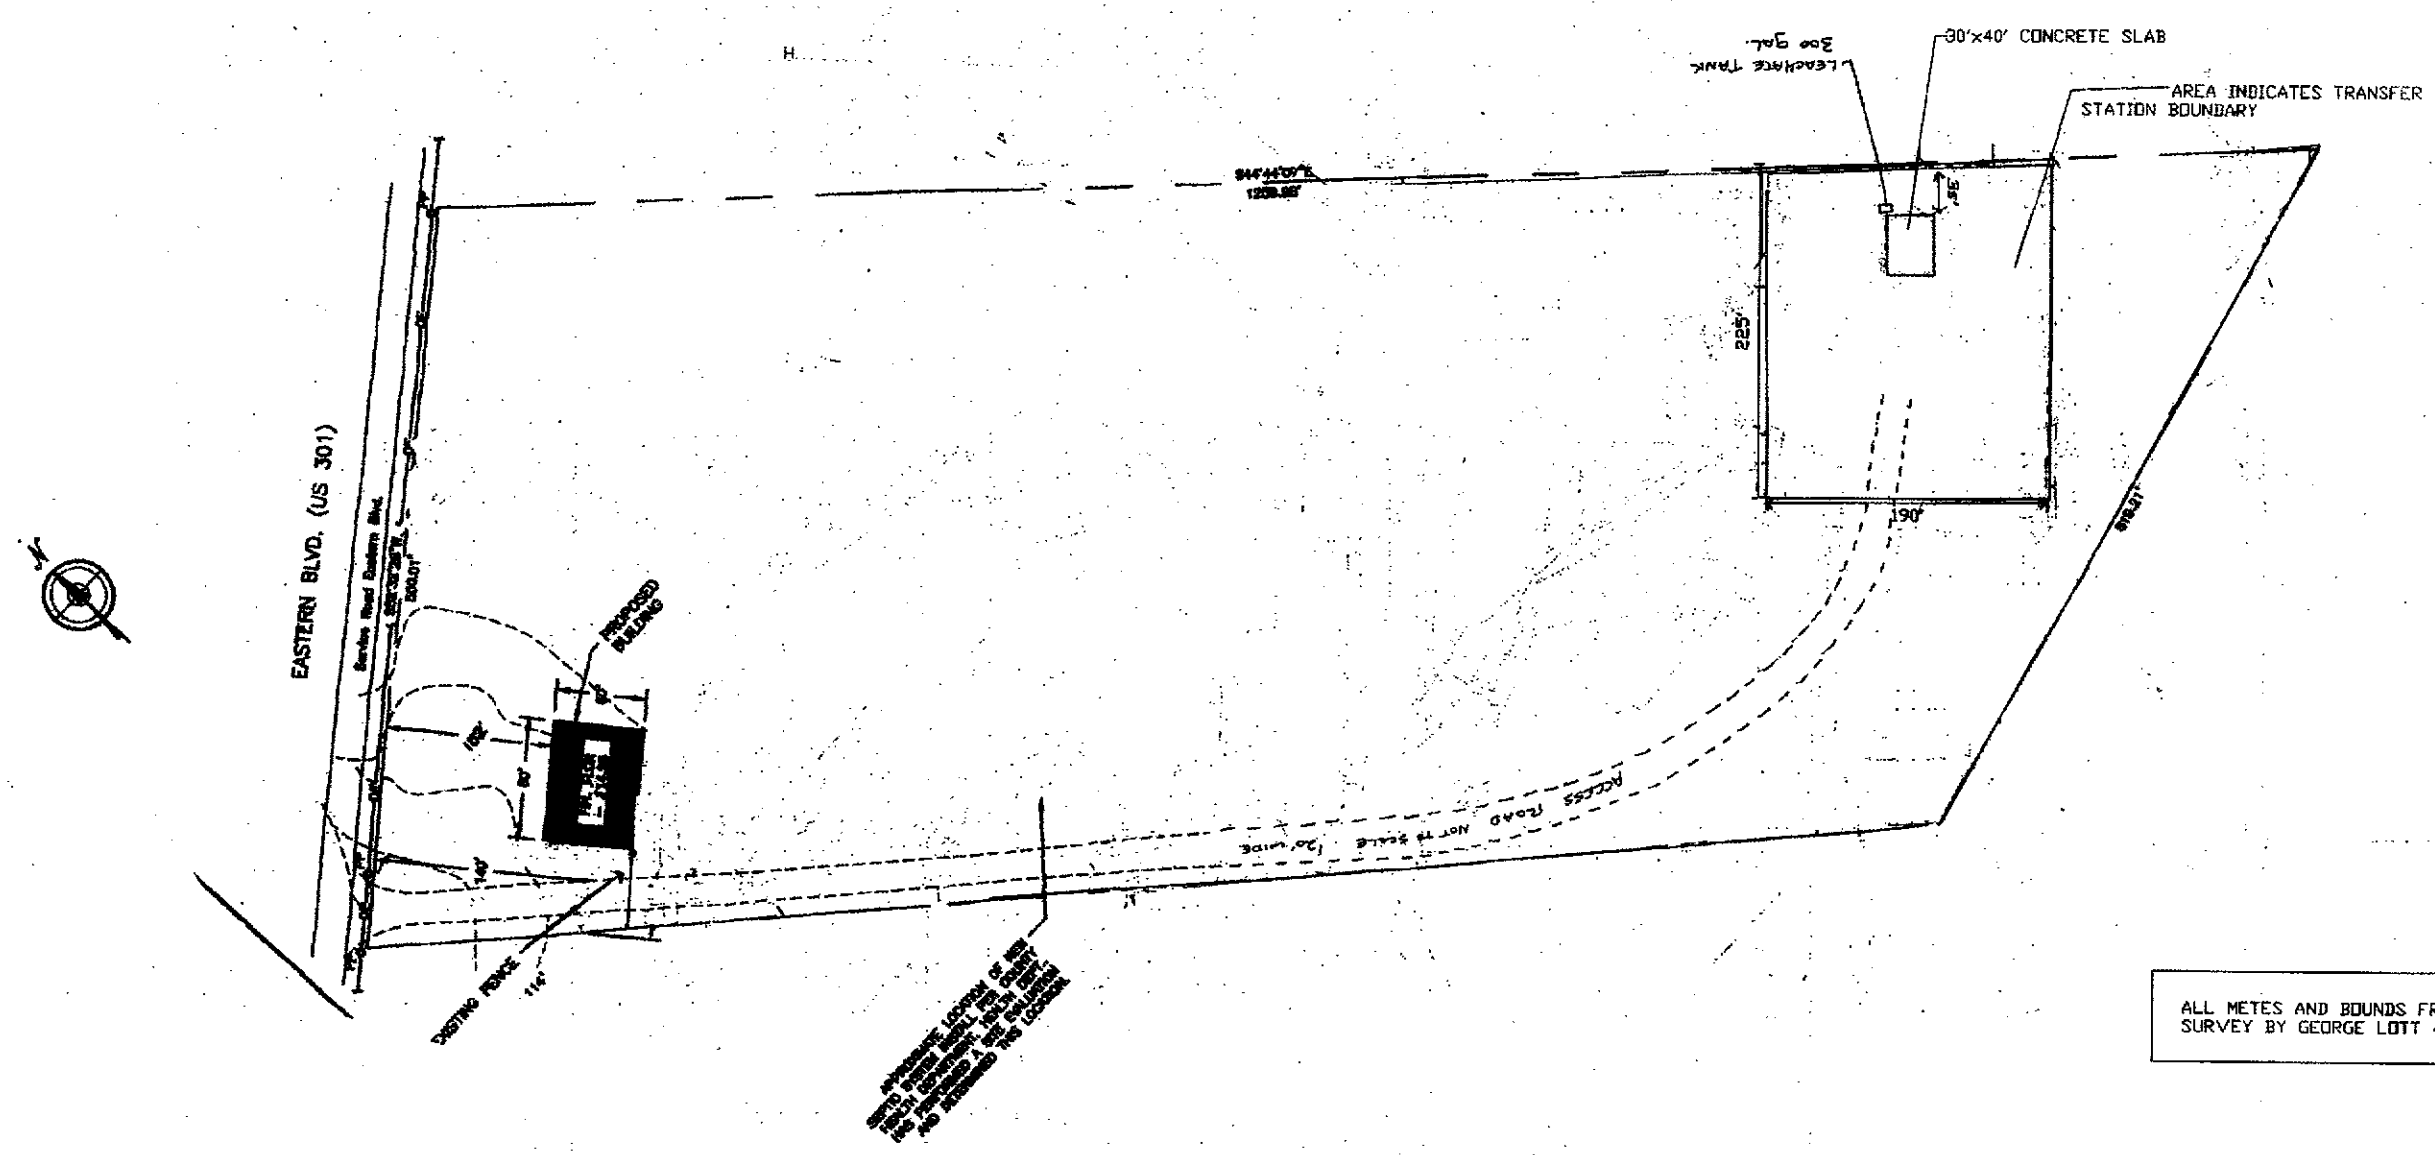

SITE PLAN

SCALE 1" = 60'

ALL METES AND BOUNDS FROM A SURVEY BY GEORGE LOTT 4-12-06

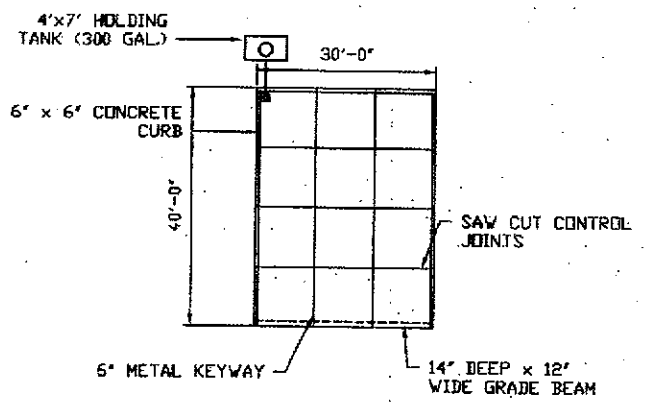

EQUIPMENT SLAB ON GRADE

SCALE 1" = 15'

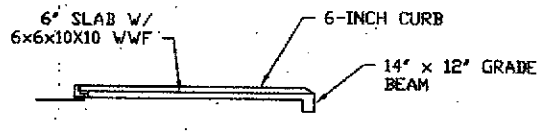

SECTION THROUGH SLAB

SCALE 1" = 15'

Permit No.	Date	DIN
2613	December 2, 2010	12330

RECEIVED
December 2, 2010
Solid Waste Section
Asheville Regional Office

I CERTIFY BY AN INSPECTION BY ME THAT THE CONCRETE EQUIPMENT PAD IS INSTALLED PER THESE DRAWINGS.

BUDDY JENKINS, PE 17 SEPTEMBER 2010

AS-BUILT DRAWING

REV. 1 21 OCT. 2010 INDICATED TRANSFER BOUNDARY

JENKINS CONSULTING ENGINEERS, PA
DOUGLAS L. "BUDDY" JENKINS, PE 7740 McARTANS FORD LINDEN NC 28356
910.822.1724 FAX 910.822.4646 buddy.jenkins@embarqmail.com

NORTH CAROLINA PROFESSIONAL ENGINEER SEAL 26803 DOUGLAS L. "BUDDY" JENKINS

DRAWN BY: B. J.
CHECKED BY: B. JENKINS
DATE: 17 SEPT 2010
SCALE:

PROJECT: AAA HAULING EQUIPMENT SLAB
1171 S. EASTERN BLVD. FAYETTEVILLE N.C.

SHEET: EQUIPMENT SLAB

CS