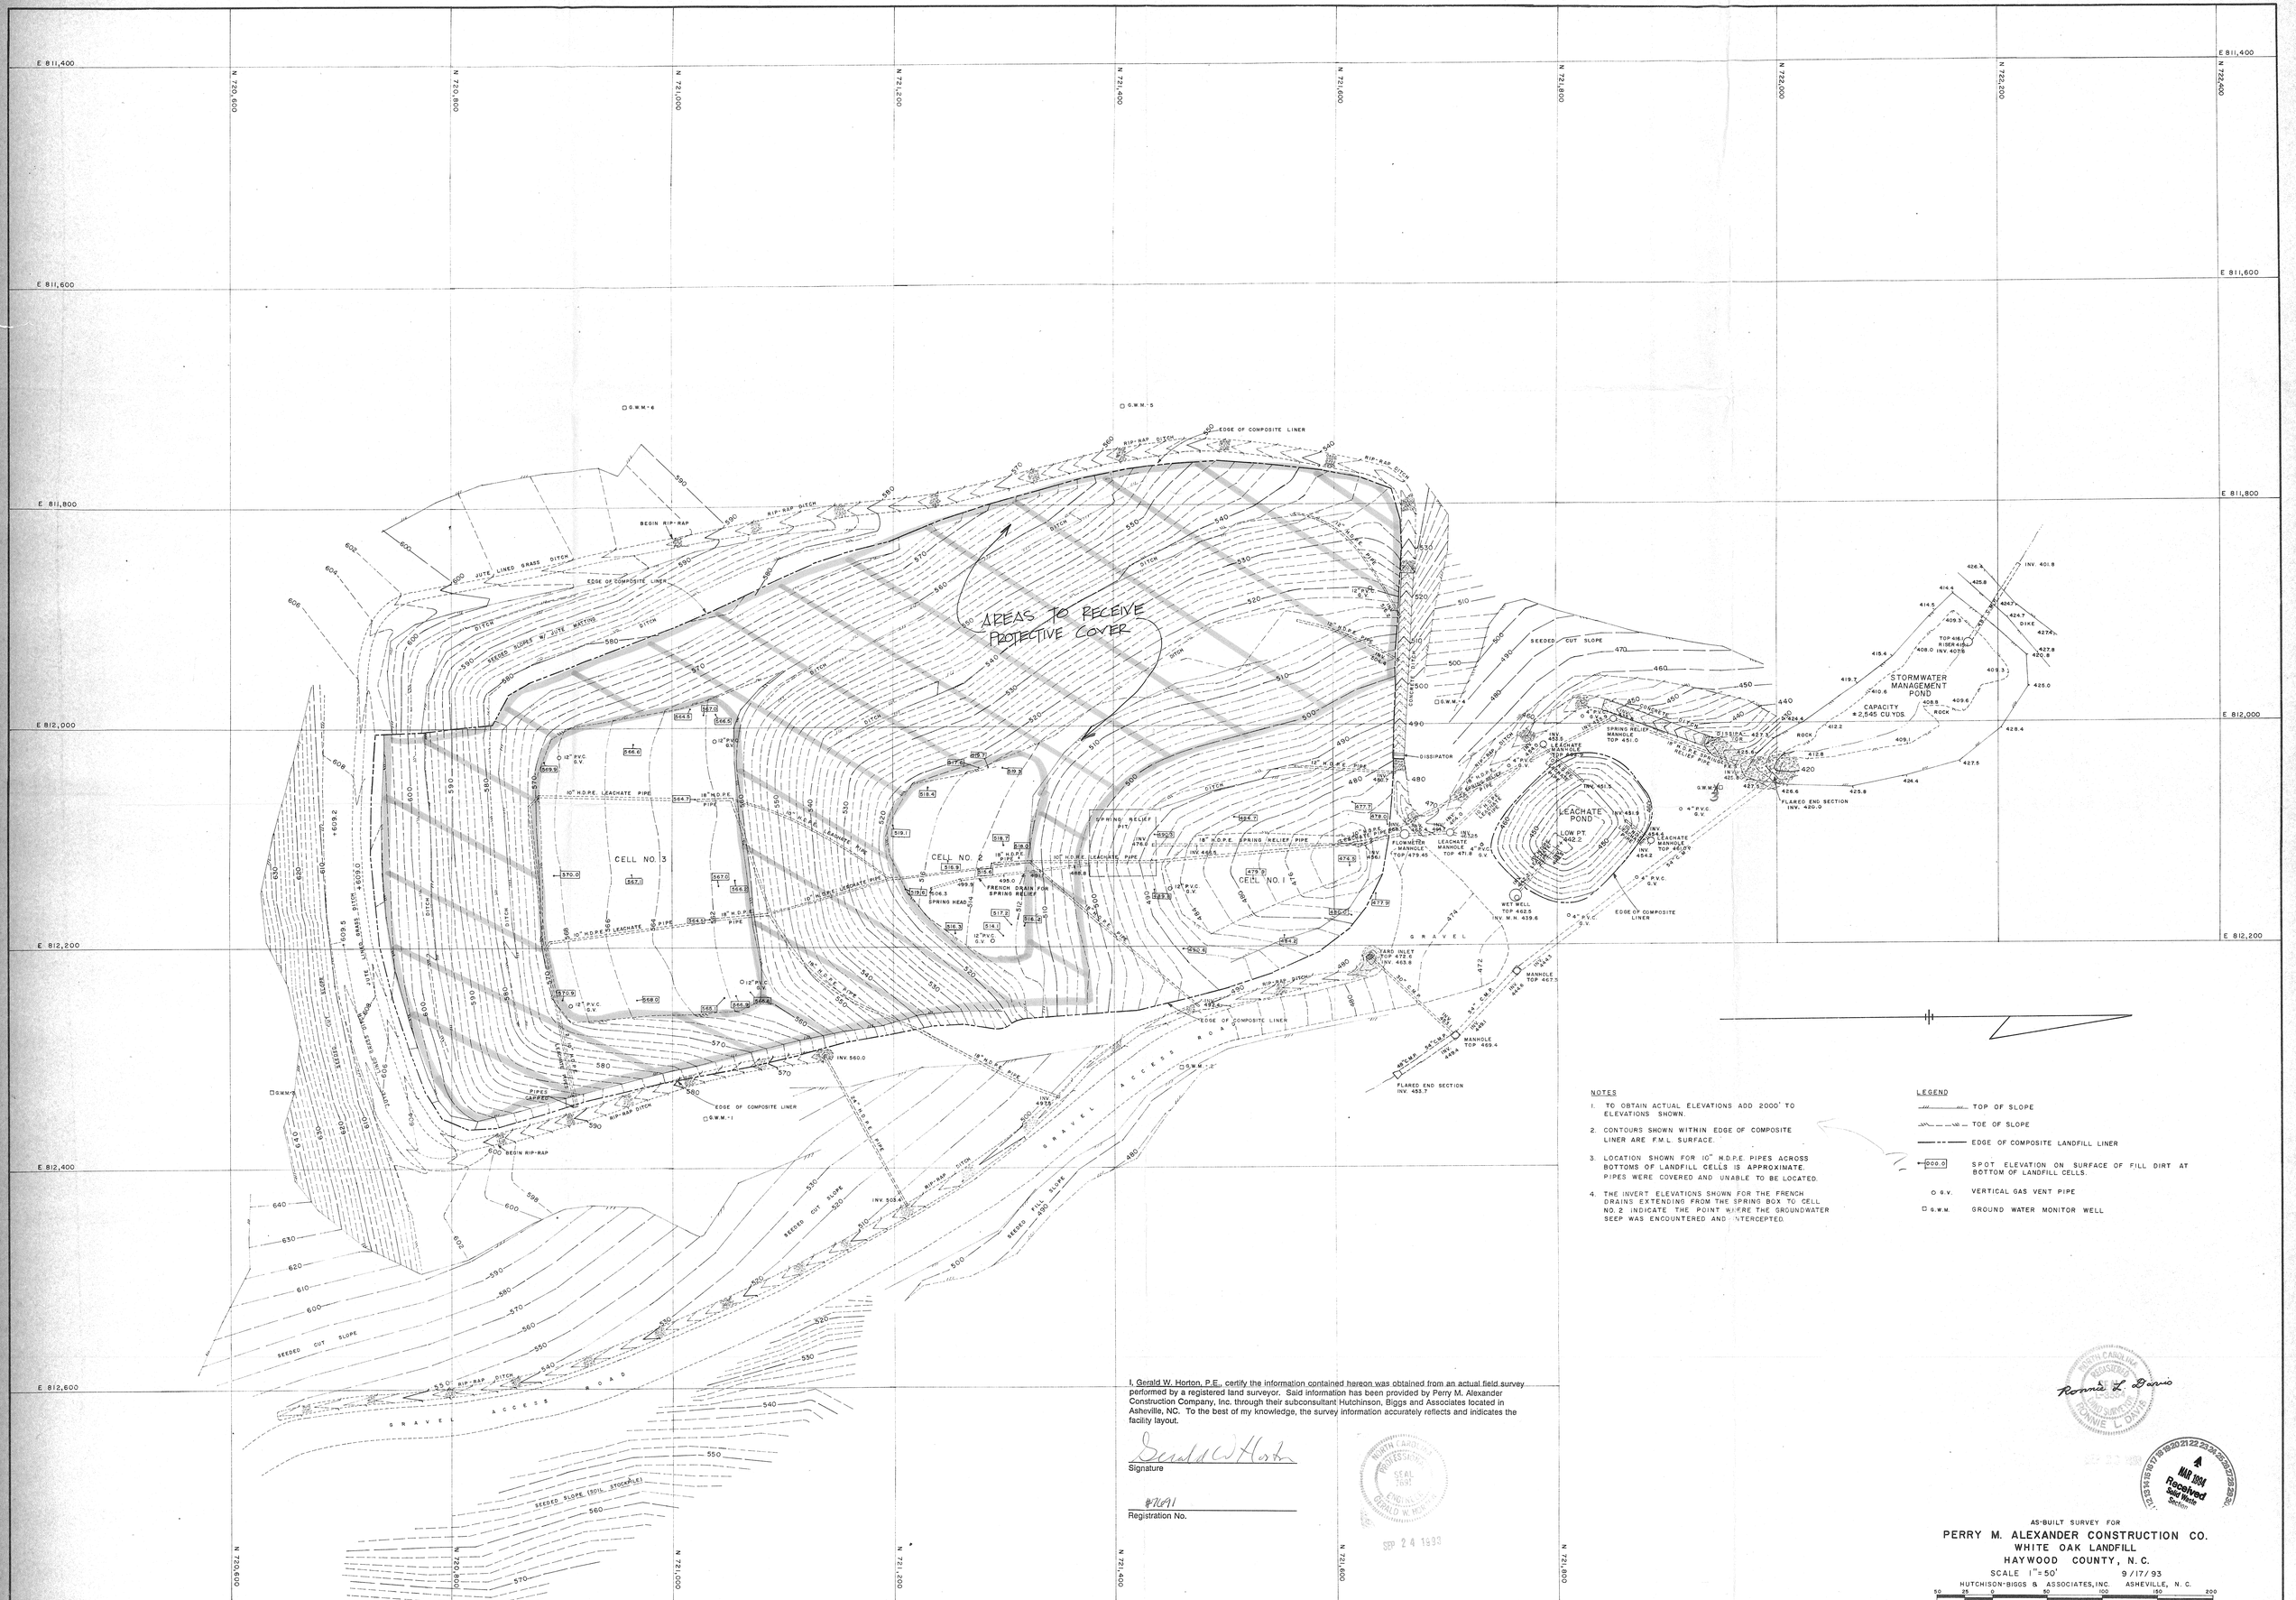

NOTES

1. TO OBTAIN ACTUAL ELEVATIONS ADD 2000' TO ELEVATIONS SHOWN.
2. CONTOURS SHOWN WITHIN EDGE OF COMPOSITE LINER ARE F.M.L. SURFACE.
3. LOCATION SHOWN FOR 10" H.D.P.E. PIPES ACROSS BOTTOMS OF LANDFILL CELLS IS APPROXIMATE. PIPES WERE COVERED AND UNABLE TO BE LOCATED.
4. THE INVERT ELEVATIONS SHOWN FOR THE FRENCH DRAINS EXTENDING FROM THE SPRING BOX TO CELL NO. 2 INDICATE THE POINT WHERE THE GROUNDWATER SEEP WAS ENCOUNTERED AND INTERCEPTED.

LEGEND

- TOP OF SLOPE
- TOE OF SLOPE
- EDGE OF COMPOSITE LANDFILL LINER
- 000.0 SPOT ELEVATION ON SURFACE OF FILL DIRT AT BOTTOM OF LANDFILL CELLS.
- G.V. VERTICAL GAS VENT PIPE
- G.W.M. GROUND WATER MONITOR WELL

I, Gerald W. Horton, P.E., certify the information contained hereon was obtained from an actual field survey performed by a registered land surveyor. Said information has been provided by Perry M. Alexander Construction Company, Inc. through their subconsultant Hutchinson, Biggs and Associates located in Asheville, NC. To the best of my knowledge, the survey information accurately reflects and indicates the facility layout.

Signature

#7691
Registration No.

NORTH CAROLINA REGISTERED PROFESSIONAL SEAL 7691 ENGINEER GERALD W. HORTON

SEP 24 1993

NORTH CAROLINA REGISTERED LAND SURVEYOR SEAL L-3325 RONNIE L. DAVIS

Ronnie L. Davis

SEP 23 1993

4 MAR 1994 Received Solid Waste Section

AS-BUILT SURVEY FOR

PERRY M. ALEXANDER CONSTRUCTION CO.
WHITE OAK LANDFILL
HAYWOOD COUNTY, N. C.

SCALE 1"=50' 9/17/93

HUTCHISON-BIGGS & ASSOCIATES, INC. ASHEVILLE, N. C.

50 25 0 50 100 150 200

G 93-205