1906Map2003 - Batch No.___

1

1906-200=
map

Re-Printed by permission of

Adams
Architecture
608 West Broad Street
Elizabethtown, NC 28337
phone 910.862.3131
fax 910.862.3636
email cadams@intrstar.net

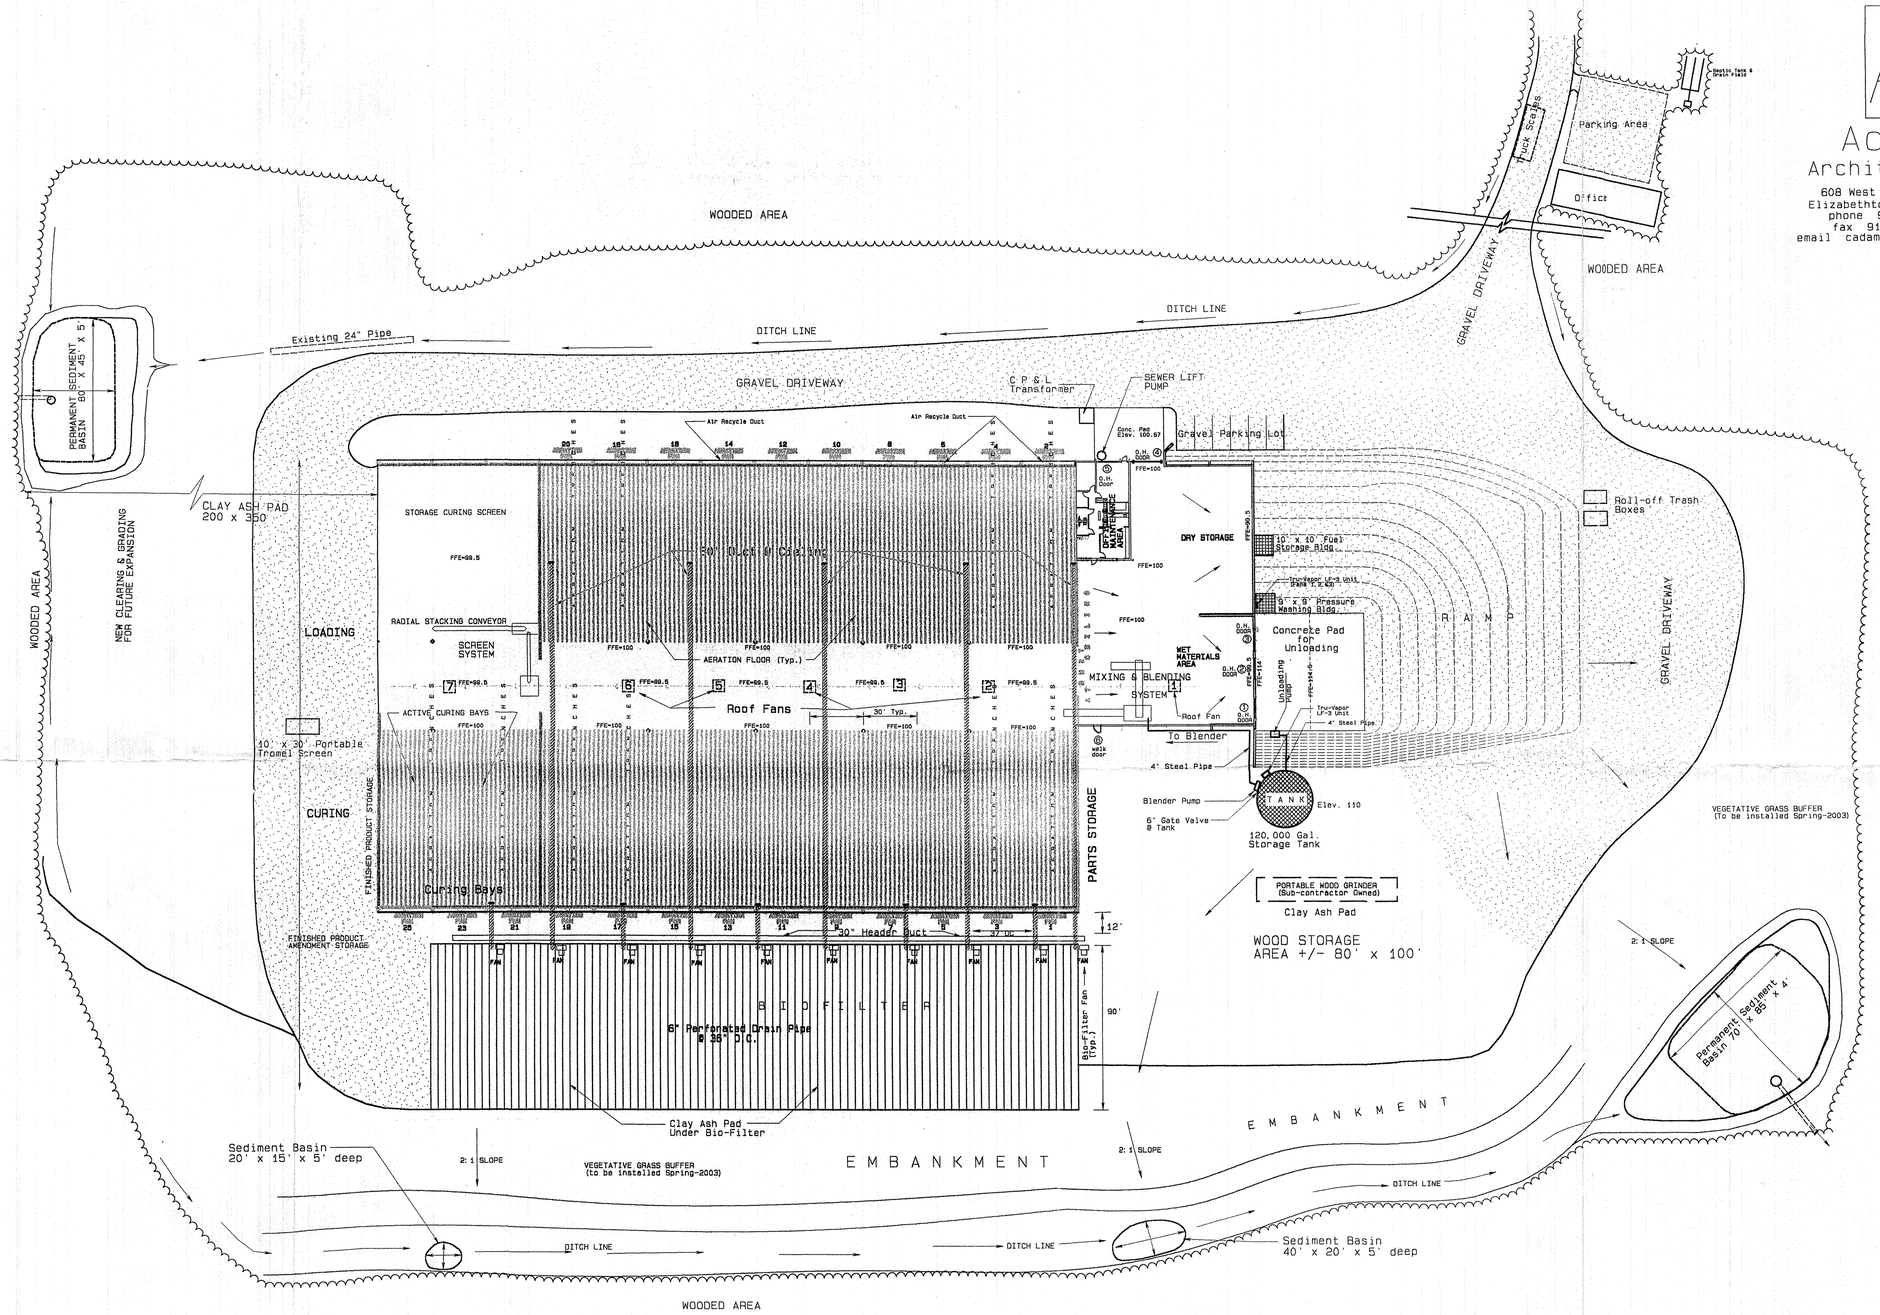

JOHN W. HARRIS, P.E.
CONSULTING ENGINEER
7909 OCDEE COURT, RALEIGH, N.C. 27612
(919) 789-0744

AS-BUILT SITE PLAN
McGILL ENVIRONMENTAL SYSTEMS
CHATHAM COUNTY, N.C.

Date: 02-18-03 Scale: 1" = 40' Drawn By: jwh Revised:

19-96