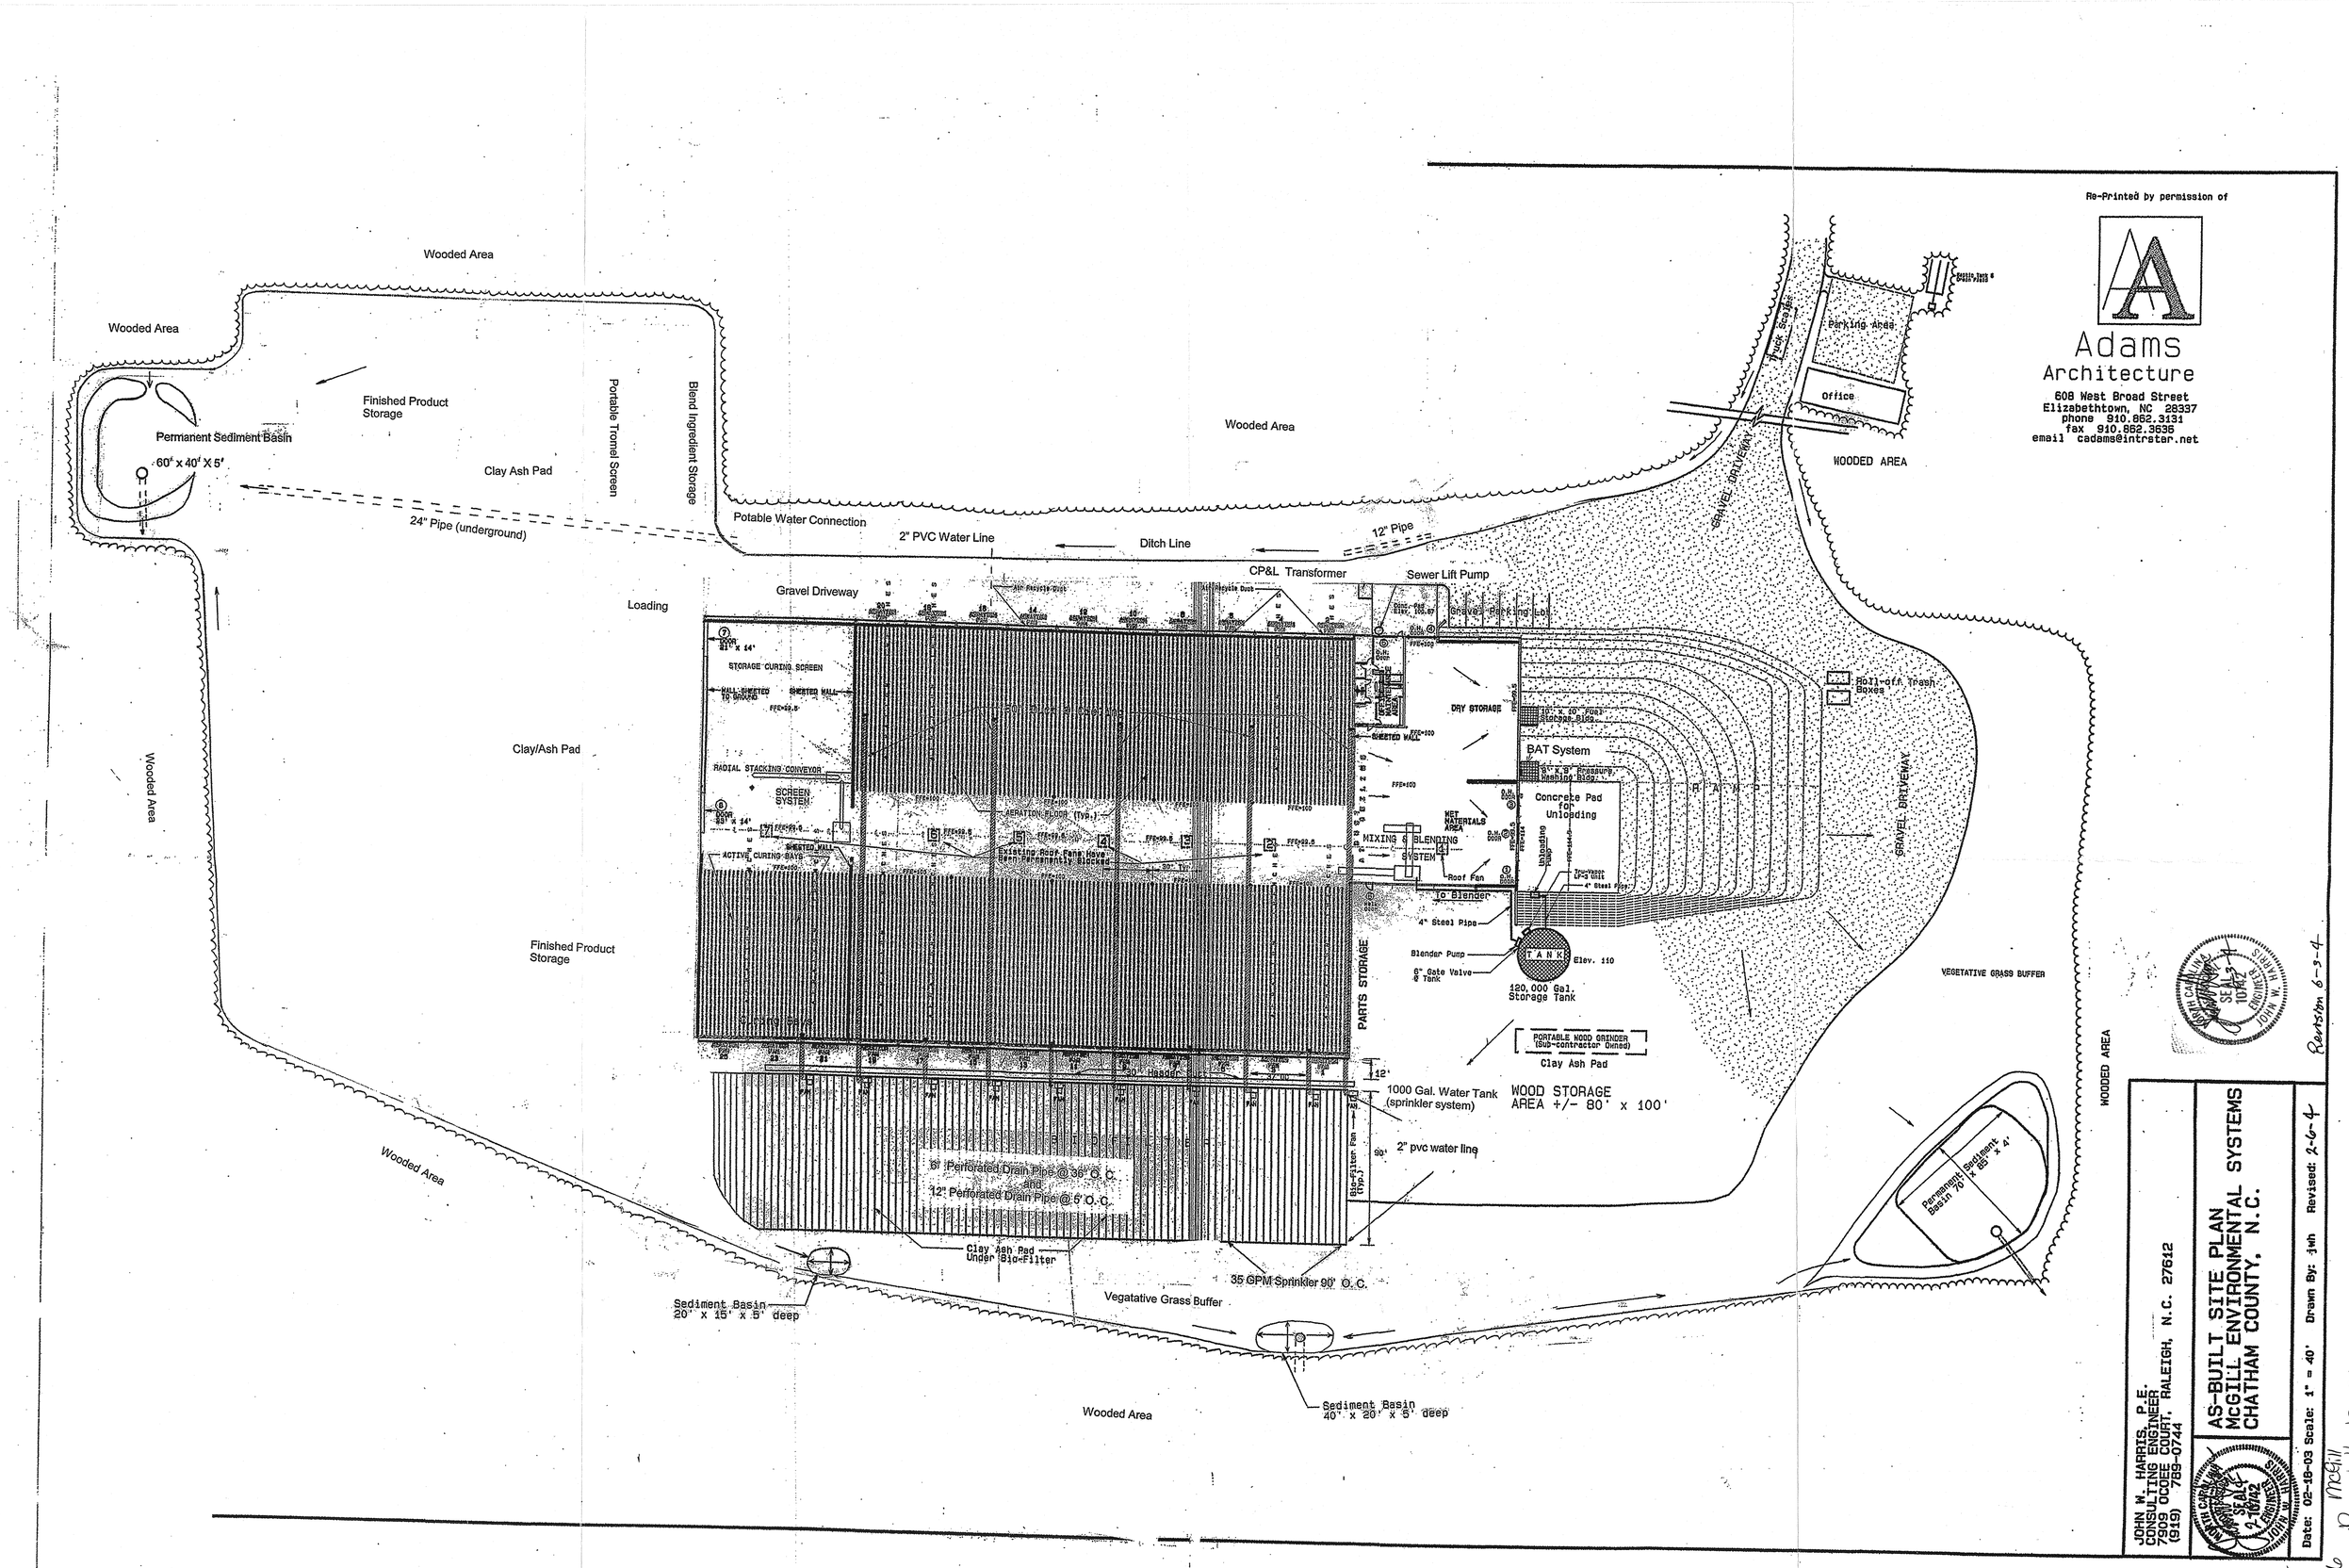
Wooded Area
Wooded Area
Finished Product Storage
Permanent Sediment Basin
60' x 40' X 5'
Clay Ash Pad
Portable Tromel Screen
Blend Ingredient Storage
24" Pipe (underground)
Potable Water Connection
2" PVC Water Line
Ditch Line
12" Pipe
Wooded Area
CP&L Transformer
Sewer Lift Pump
Gravel Driveway
Loading
Gravel Parking Lot
Truck Scales
Parking Area
Office
WOODED AREA
GRAVEL DRIVEWAY
Roll-off Trash Boxes
STORAGE CURING SCREEN
DRY STORAGE
Clay/Ash Pad
RADIAL STACKING CONVEYOR
SCREEN SYSTEM
BAT System
Concrete Pad for Unloading
MIXING & BLENDING SYSTEM
Roof Fan
To Blender
4" Steel Pipe
Blender Pump
6" Gate Valve @ Tank
TANK
Elev. 110
120,000 Gal. Storage Tank
PARTS STORAGE
Finished Product Storage
GRAVEL DRIVEWAY
VEGETATIVE GRASS BUFFER
PORTABLE WOOD GRINDER (Sub-Contractor Owned)
Clay Ash Pad
1000 Gal. Water Tank (sprinkler system)
WOOD STORAGE AREA +/- 80' x 100'
2" pvc water line
6" Perforated Drain Pipe @ 36" O.C. and 12" Perforated Drain Pipe @ 6' O.C.
Clay Ash Pad Under Bio-Filter
35 GPM Sprinkler 90' O.C.
Vegatative Grass Buffer
Sediment Basin 20' x 15' x 5' deep
Sediment Basin 40' x 20' x 5' deep
Permanent Sediment Basin 70' x 80' x 4'
WOODED AREA
Wooded Area
Wooded Area
Wooded Area
Wooded Area
Re-Printed by permission of
Adams Architecture
608 West Broad Street
Elizabethtown, NC 28337
phone 910.862.3131
fax 910.862.3635
email cadams@intrstar.net
Revision 6-3-4
JOHN W. HARRIS, P.E.
CONSULTING ENGINEER
7309 OCOEE COURT, RALEIGH, N.C. 27612
(919) 789-0744
AS-BUILT SITE PLAN
McGILL ENVIRONMENTAL SYSTEMS
CHATHAM COUNTY, N.C.
Date: 02-19-03 Scale: 1" = 40' Drawn By: jwh Revised: 2-6-4
Permit No. 19-06
McGill Permit # 19-06
6/3/04 1 Sheet